


CONSTRUCTION DETAILS


- A. INSTALL 3" SCHEDULE 80 RIGID PVC CONDUIT - TRENCHED PRIOR TO FINAL SIDEWALK POUR.
- B. INSTALL 3" SCHEDULE 80 RIGID PVC CONDUIT - SLOTTED.
- C. DISCONNECT EXISTING WIRE FROM CONTROLLER AND PULL BACK TO THIS EXISTING HANDHOLE. RE-INSTALL THROUGH NEW CONDUIT TO THE NEW CONTROLLER.
- D. INSTALL HANDHOLE PRIOR TO FINAL SIDEWALK POUR.
- E. REMOVE EXISTING HANDHOLE. CAP AND ABANDON EXISTING CONDUIT.

DIMENSION DIAGRAM

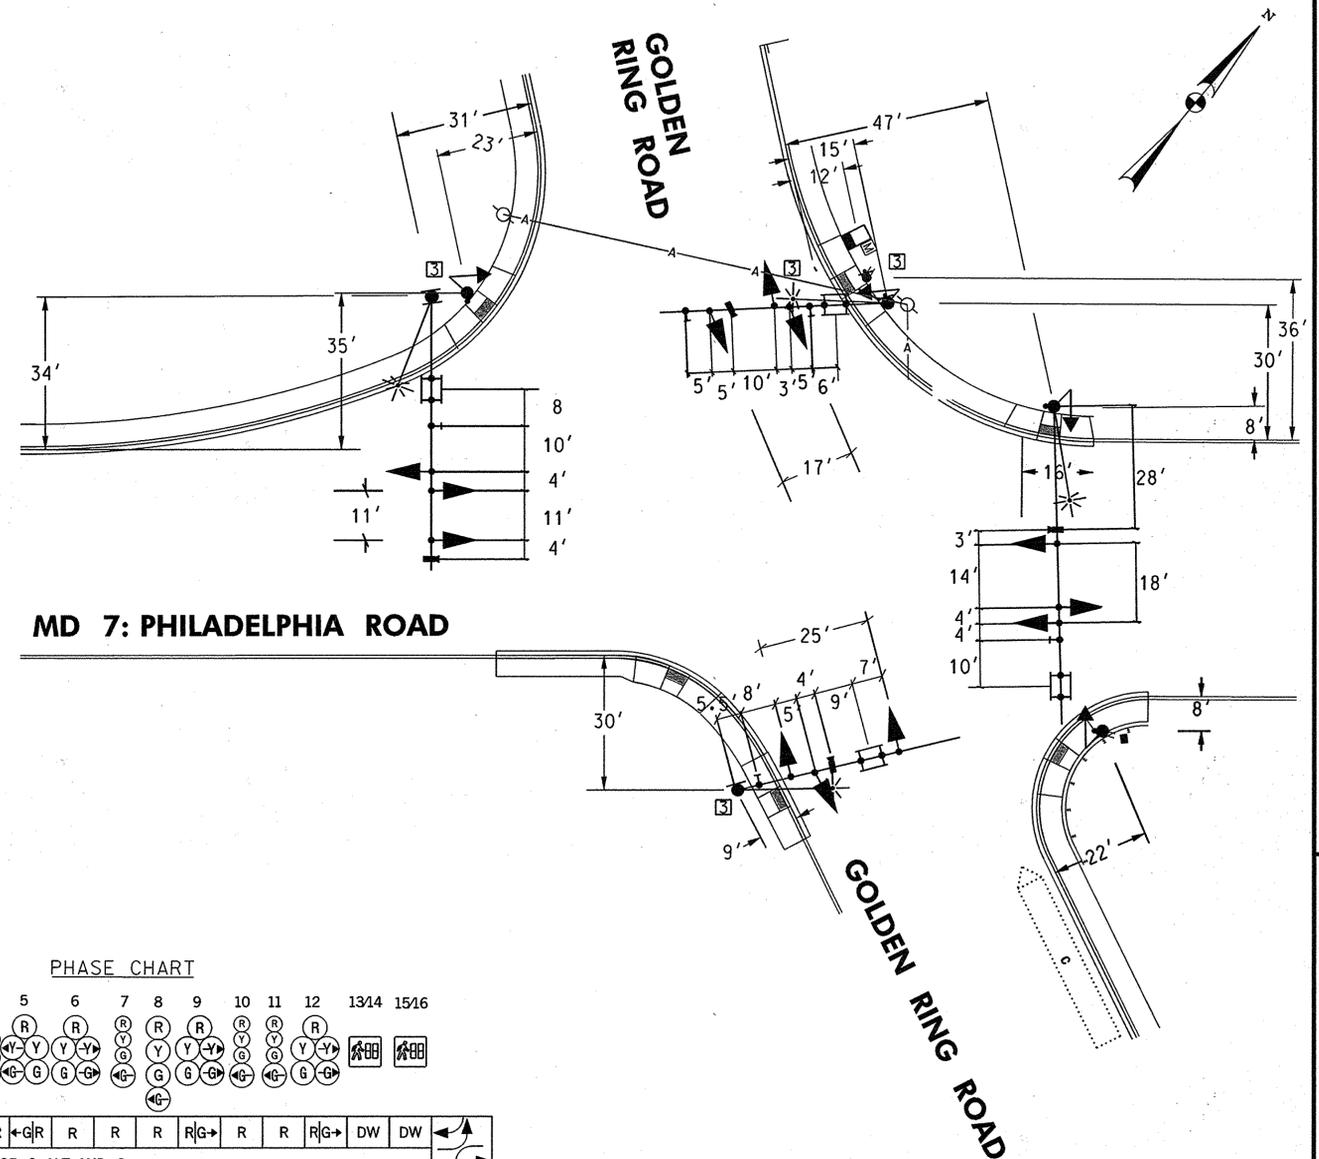

MD 7: PHILADELPHIA ROAD

PHASE CHART

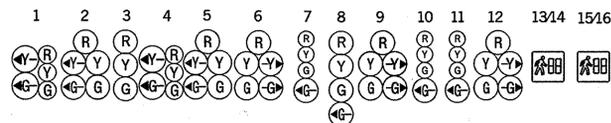

PHASE 1 AND 5	←G R	←G R	G	←G R	←G R	R	R	R	R G→	R	R	R G→	DW	DW	↔
1 AND 5 CHANGE TO 1 AND 6, 2 AND 5, 2 AND 6, OR 2 ALT AND 6															
PHASE 1 AND 6	←G G	←G G	G	R	R	R	R	R	R	R	R	R G→	DW	DW	↔
1 CHANGE	←Y G	←Y G	Y	R	R	R	R	R	R	R	R	R Y→	DW	DW	↔
PHASE 2 AND 5	R	R	R	←G G	←G G	G	R	R	R G→	R	R	R	DW	DW	↔
5 CHANGE	R	R	R	←Y G	←Y G	G	R	R	R Y→	R	R	R	DW	DW	↔
PHASE 2 AND 6	G	G	G	G	G	G	R	R	R	R	R	R	WK	DW	↔
PED CLEARANCE	G	G	G	G	G	G	R	R	R	R	R	R	FL/DW	DW	↔
2 AND 6 CHANGE	Y	Y	Y	Y	Y	Y	R	R	R	R	R	R	DW	DW	↔
PHASE 3	R	R	R	R	R	R	←G	←G	G	R	R	R	DW	DW	↔
3 CHANGE	R	R	R	R	R	R	←Y	←Y	Y	R	R	R	DW	DW	↔
PHASE 3 ALT	R	R	R	R	R	R	←G	←G	G	R	R	R	DW	WK	↔
PED CLEARANCE	R	R	R	R	R	R	←G	←G	G	R	R	R	DW	FL/DW	↔
3 ALT CHANGE	R	R	R	R	R	R	←Y	←Y	Y	R	R	R	DW	DW	↔
PHASE 4	R	R	R	R	R	R G→	R	R	R	←G	←G	G	DW	DW	↔
4 CHANGE	R	R	R	R	R	R Y→	R	R	R	←Y	←Y	Y	DW	DW	↔
FIREHOUSE PREEMPTION	R	R	R	R	R	R R→	R	R	R	G	G	G	DW	DW	↔
PREEMPTION CHANGE	R	R	R	R	R	R R→	R	R	R	Y	Y	Y	DW	DW	↔
FLASHING OPERATION	FL/Y	FL/Y	FL/Y	FL/Y	FL/Y	FL/R	DARK	DARK	↔						

SHA STATE OF MARYLAND
 DEPARTMENT OF TRANSPORTATION
 STATE HIGHWAY ADMINISTRATION
 OFFICE OF TRAFFIC & SAFETY
 TRAFFIC ENGINEERING DESIGN DIVISION
**MD 7 (PHILADELPHIA RD) AND
 MD 588 (GOLDEN RING RD)**

REVISIONS		GENERAL INFORMATION SHEET	
3 GREEN LINE NO. 3, TRAFFIC REPLACE SHEET NO. 169 DATE: OCTOBER 6, 2008	SCALE 1" = 20'	DATE 10-11-08	CONTRACT NO. BA8885185
DESIGNED BY AJM	COUNTY BALTIMORE	LOGMILE 03000702.25	T.I.M.S. NO. F188
DRAWN BY WMD	F.A.P. NO.	TOD NO.	
CHECKED BY PAT	DRAWING NO. TS-1158J	SG-8 OF 9	SHEET NO. 169 OF 249
1 RED LINE NO. 1, TRAFFIC REPLACE SHEET NO. 169 DATE: AUGUST 1, 2007			

PLOTTED: Monday, October 06, 2008 AT 12:15 PM
 FILE: Y:\08-0000 Century Engineering-MD SHA\Task 1 MD 7\CADD\6 Green Line 3 Plans\SG-P008_MD7.dgn

CENTURY
 ENGINEERING
 CONSULTING ENGINEERS - PLANNERS
 10710 GILROY ROAD
 HUNT VALLEY, MD 21031

T3
 design
 T3 DESIGN, P.C.
 3927 OLD LEE HWY
 SUITE 101-C
 FAIRFAX, VA 22030
 PHONE: 703-359-5861
 www.t3design.us

BY: amym