

DRILL HOLES

DRILL HOLES

DRILL HOLES

BORDER REV. DATE: JUN 11, 2004

REFER TO SHEET DE-1 FOR ALL GENERAL NOTES

STANDARD TYPE A COMBINATION CURB AND GUTTER
12 INCH GUTTER PAN 8 INCH DEPTH SHA STD. NO. MD-620.02

LOCATION	QUANTITY (LF)
NORTHWEST QUADRANT	22
NORTHWEST MEDIAN ISLAND	20
SOUTHWEST QUADRANT	51
NORTHEAST QUADRANT	65 47
SOUTHEAST QUADRANT	46 0

DETECTABLE WARNING SURFACE
(TYPE 3 BRICK PAVERS)
SHA STD. NO. MD-655.40

LOCATION	QUANTITY (SF)
NORTHWEST QUADRANT	10
NORTHWEST MEDIAN ISLAND	22
SOUTHWEST QUADRANT	22
NORTHEAST QUADRANT	23 10
SOUTHEAST QUADRANT	16 0

LOCATION	QUANTITY (SF)
NORTHWEST QUADRANT	684
NORTHWEST MEDIAN ISLAND	66
SOUTHWEST QUADRANT	592
NORTHEAST QUADRANT	184 168
SOUTHEAST QUADRANT	129 0


LOCATION	QUANTITY (SF)
NORTHWEST QUADRANT	55
SOUTHWEST QUADRANT	66

PROPOSED PEDESTRIAN PATH BOUNDARY LINES SHOWN FOR REPRESENTATIVE PURPOSES ONLY. CONTRACTOR SHALL ENSURE 5-FOOT WIDE PATH AT 2 PERCENT MAXIMUM CROSS SLOPE IS MAINTAINED THROUGHOUT RECONSTRUCTION AREA.

1 BALTIMORE COUNTY PROPERTY


APPROXIMATE LOCATION OF EXISTING CONSTRUCTION JOINT

APPROXIMATE LOCATION OF SIDEWALK TIE-IN. LENGTHEN TIE-IN AS NEEDED IN ORDER TO MAINTAIN A MAXIMUM 12:1 GRADE ALONG SIDEWALK

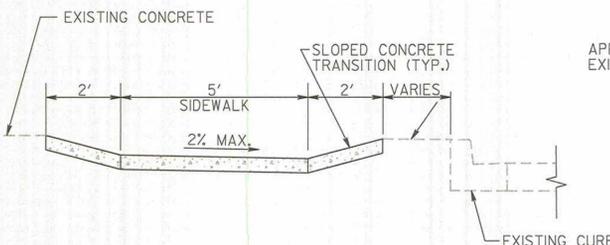

SECTION B-B
TYPICAL ISLAND CUT-THROUGH WITH SLOPED SIDES
NOT TO SCALE

BY: BJG

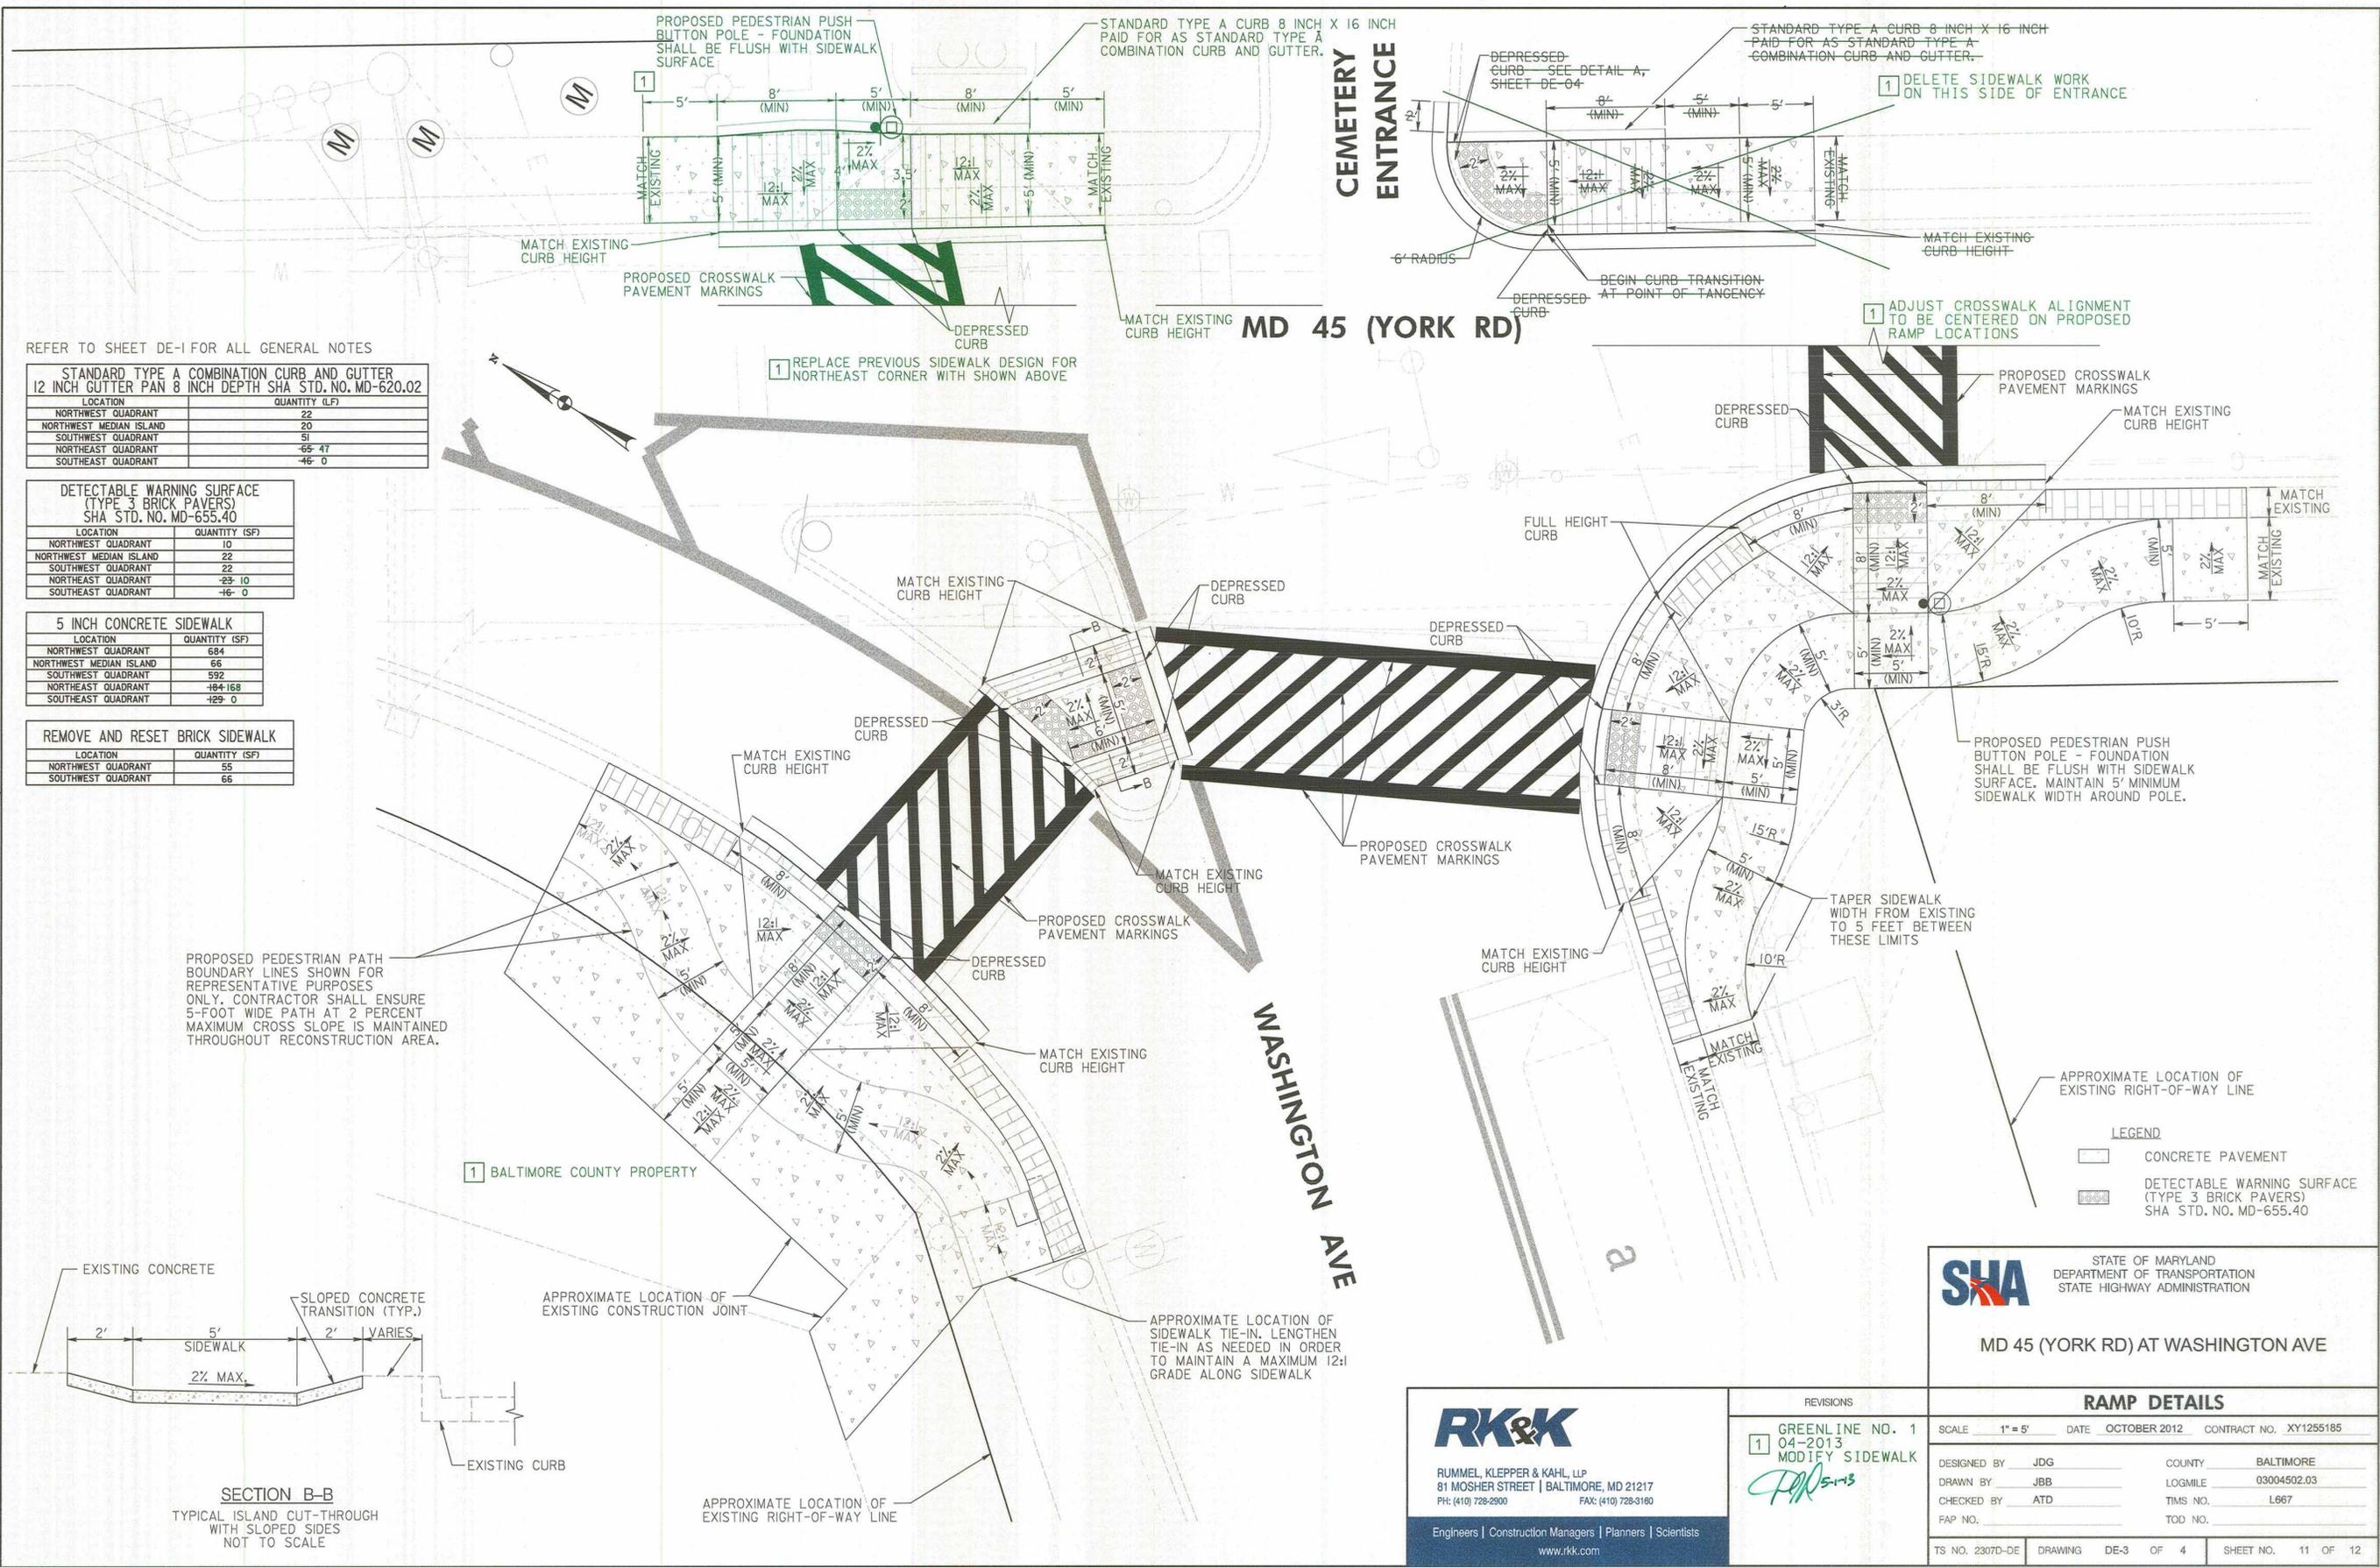

- LEGEND
- CONCRETE PAVEMENT
 - DETECTABLE WARNING SURFACE (TYPE 3 BRICK PAVERS) SHA STD. NO. MD-655.40

STATE OF MARYLAND
DEPARTMENT OF TRANSPORTATION
STATE HIGHWAY ADMINISTRATION

MD 45 (YORK RD) AT WASHINGTON AVE

RK&K
RUMMEL, KLEPPER & KAHL, LLP
81 MOSHER STREET | BALTIMORE, MD 21217
PH: (410) 728-2900 FAX: (410) 728-3180

Engineers | Construction Managers | Planners | Scientists
www.rkk.com

REVISIONS

1	GREENLINE NO. 1 04-2013 MODIFY SIDEWALK
---	---

RAMP DETAILS

SCALE	1" = 5'	DATE	OCTOBER 2012	CONTRACT NO.	XY1255185
DESIGNED BY	JDG	COUNTY	BALTIMORE		
DRAWN BY	JBB	LOGMILE	03004502.03		
CHECKED BY	ATD	TMS NO.	L667		
FAP NO.		TOD NO.			
TS NO.	2307D-DE	DRAWING	DE-3	OF	4
SHEET NO.	11	OF	12		

PLOTTED: Wednesday, April 24, 2013 AT 07:36 AM
FILE: \\bmr\03\2008\2009\08148_bss\Task\Task_141_MD_45_Lutherville\CADD\c06-P003_MD45-Washington - merge.dgn