


BORDER REV. DATE: Mch 17 2008



BY: John Borkowski Division: P068 Highway Traff GMA Emp

- CONSTRUCTION DETAILS**
- A. INSTALL NEW SIDEWALK AND RAMP WITH DETECTABLE WARNING SURFACE, (STANDARD NO. MD 655.12 AND MD 655.40).
 - B. INSTALL STANDARD TYPE A CURB AND GUTTER, (STANDARD NO. MD 620.02).
 - C. INSTALL NEW 5 INCH CONCRETE SIDEWALK.
 - D. INSTALL CUT-THROUGH ISLAND OPENINGS, (STANDARD NO. 655.21 (MOD.)). NO FLARES, AS SHOWN ON THE MODIFIED TYPE A CURB DETAIL ON THIS SHEET.
 - E. INSTALL MODIFIED TYPE A BACK CURB (0 TO 8 INCH HEIGHT).

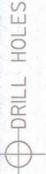





MD 45 (YORK ROAD)

WARREN ROAD

MD 45 (YORK ROAD)

WARREN ROAD W

NOTE:
LANES ON WEST LEG OF WARREN ROAD ARE REDUCED FROM 12 FEET TO 11 FEET.

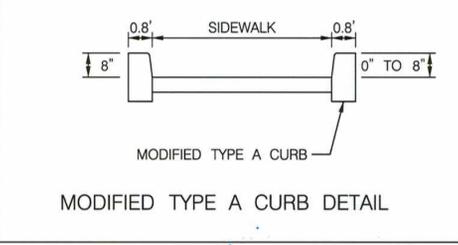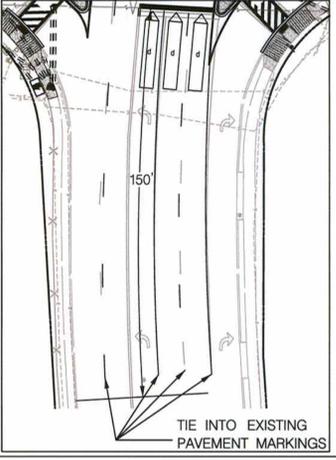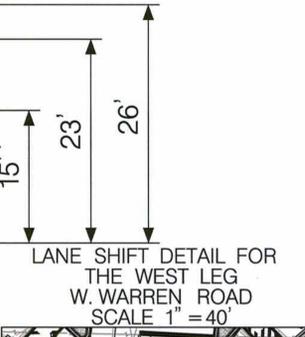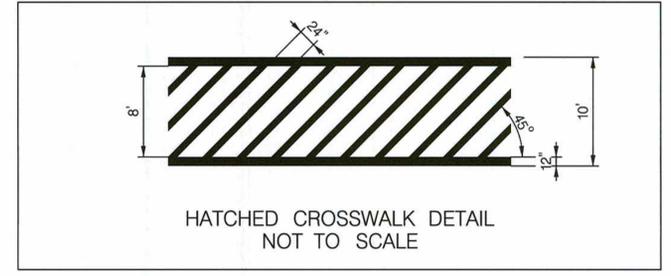

KCI
TECHNOLOGIES

ENGINEERS
PLANNERS
SCIENTISTS
CONSTRUCTION MANAGERS

936 RIDGEBROOK ROAD
SPARKS, MARYLAND 21152
TELEPHONE: (410) 316-7800
FAX: (410) 316-7818

1 REDLINE NO. 1
REPLACE SHEET
MAY 24 2013
Adrian Wal 6/13

STATE OF MARYLAND DEPARTMENT OF TRANSPORTATION STATE HIGHWAY ADMINISTRATION OFFICE OF TRAFFIC & SAFETY TRAFFIC ENGINEERING DESIGN DIVISION MD 45 (YORK ROAD) AT WARREN ROAD COCKEYSVILLE, MARYLAND			
DETAIL SHEET			
SCALE 1" = 10', ADVERTISED DATE 04/2013, CONTRACT NO. XY1255185			
DESIGNED BY	AFAMH	COUNTY	BALTIMORE
DRAWN BY	AF	LOGMILE	03004507.66
CHECKED BY	JFL	TIMS NO.	L674
F.A.P. NO.		TOD NO.	
TS NO. 1439C	DRAWING SG-2	OF 3	SHEET NO. 5 OF 9