

**PROJECT DESCRIPTION**

THIS PROJECT INVOLVES THE INSTALLATION OF HAZARD IDENTIFICATION BEACONS EAST AND WEST OF PARK SCHOOL DRIVE ALONG MD 133 IN BALTIMORE COUNTY. MD 133 IS ASSUMED TO RUN IN AN EAST-WEST DIRECTION.

**HAZARD IDENTIFICATION BEACON OPERATION**

THE HAZARD IDENTIFICATION BEACON SHALL FLASH ALTERNATIVELY DURING SCHOOL HOURS.

**CONTROLLER REQUIREMENTS**

A FULL-TRAFFIC-ACTUATED, EIGHT-PHASE CONTROLLER WITH INTERSECTION MONITOR AND TWO CIRCUIT FLASHER UNIT HOUSED IN A POLE MOUNTED CABINET SHALL BE FURNISHED BY SHA AND INSTALLED BY THE CONTRACTOR.

**SPECIAL NOTE**

UPON COMPLETION OF THIS PROJECT, THE CONTRACTOR SHALL NOTIFY MR. ROBERT SNYDER OF SHA AT (410) 787-7631 TO ARRANGE FOR THE PHONE LINE INSTALLATION. THE CONTRACTOR IS TO PROVIDE MR. SNYDER WITH THE NEAREST STREET ADDRESS, ZIP CODE, AND PHONE NUMBER.

**CONTACT PERSONS FOR DISTRICT #4 ARE AS FOLLOWS:**

MS. ERIN KUHN  
ASSISTANT DISTRICT ENGINEER-TRAFFIC  
PHONE: (410) 229-2381

MR. ANDRE FUTRELL  
ASSISTANT DISTRICT ENGINEER - MAINTENANCE  
PHONE: (410) 229-2361

MR. JESSE FREE  
ASSISTANT DISTRICT ENGINEER - CONSTRUCTION  
PHONE: (410) 229-2421

**CONTACT PERSONS FOR OOTS ARE AS FOLLOWS:**

MS. CORREN JOHNSON  
DIVISION CHIEF,  
TRAFFIC OPERATIONS  
(410)787-7630

MR. ROBERT SNYDER  
ASSISTANT DIVISION CHIEF,  
TRAFFIC OPERATIONS  
(410)787-7631

MR. ED RODENHIZER  
MANAGER, SIGNAL OPERATIONS  
(410)787-7650

MR. EUGENE BAILEY  
MANAGER, SIGN OPERATIONS  
(410)787-7676

**EQUIPMENT LIST "A, B & C"**

**A. EQUIPMENT TO BE SUPPLIED BY THE SHA**


ITEM NO.	DESCRIPTION	UNIT	QUANTITY
9101	CONTROLLER CABINET "G" TYPE POLE MOUNT	EA	2
9114	2 CIRCUIT FLASHER	EA	2
9115	CONTROLLER ASC III WITH INTERSECTION MONITOR	EA	2
9570	SHEET ALUMINUM GROUND MOUNTED SIGN	SF	29
	2 - S1-1 FYG 36"X36"		
	2 - S4-3 FYG 36"X12"		
	1 - S5-2 24"X30"		
9571	SHEET ALUMINUM MAST ARM/POLE MOUNTED SIGN	SF	32
	2 - S5-1 30"X60"		
	2 - S4-4(1) 30"X15"		

**B. EQUIPMENT TO BE FURNISHED AND/OR INSTALLED BY THE CONTRACTOR**

ITEM NO.	DESCRIPTION	UNIT	QUANTITY
1001	MAINTENANCE OF TRAFFIC	EA	1
2002	TEST PIT EXCAVATION	CY	2
6002	5 INCH CONCRETE SIDEWALK	SF	50
8001	12 INCH LED SIGNAL HEAD SECTION	EA	4
8009	BREAKAWAY PEDESTAL POLE (ANY SIZE)	EA	2
8012	EMBEDDED METERED SERVICE PEDESTAL (100 AMP)	EA	2
8024	REMOVE & DISPOSE OF EQUIPMENT (PER ASSIGNMENT)	EA	1
8038	UP TO 4 INCH SCHEDULE 80 RIGID PVC CONDUIT-BORED	LF	160
8040	UP TO 4 INCH SCHEDULE 80 RIGID PVC CONDUIT-TRENCHED	LF	260
8041	WOOD SIGN SUPPORTS UP TO 4' X 6'	LF	47
8042	INSTALL OVERHEAD OR GROUND MOUNTED SIGN (INCLUDING ALL HARDWARE)	SF	61
8044	NO. 6 AWG STRANDED BARE COPPER GROUND WIRE	LF	125
8047	ELECTRICAL CABLE 1-CONDUCTOR NO. 8 AWG-THHN/THWN	LF	215
8048	FURNISH AND INSTALL ELECTRICAL HANDHOLE	EA	2
8057	ELECTRICAL CABLE - 5 CONDUCTOR (NO. 14 AWG)	LF	70
8063	INSTALL CONTROLLER AND CABINET - POLE MOUNT	EA	2

**C. ALL MATERIALS TO BE REMOVED BY THE CONTRACTOR SHALL BECOME THE PROPERTY OF THE CONTRACTOR.**


**PHASING CHART**

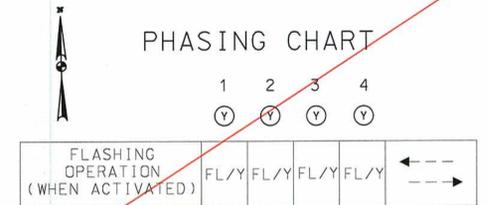


**GENERAL NOTES**

1. THE CONTRACTOR SHALL VERIFY ALL PROPOSED POLE LOCATIONS PRIOR TO INSTALLATION.
2. THE CONTRACTOR SHALL BE RESPONSIBLE FOR TERMINATING ALL SIGNAL CABLE TO THE APPROPRIATE TERMINALS AND PROPERLY LABELING EACH CABLE.
3. ALL UNUSED CABLE SHALL BE REMOVED AND DISPOSED OF BY THE CONTRACTOR.
4. UNDERGROUND UTILITIES SHOWN ON THESE PLANS ARE SCHEMATIC ONLY AND MAY NOT BE COMPLETE. THE CONTRACTOR SHALL BE RESPONSIBLE FOR NOTIFYING "MISS UTILITY" PRIOR TO CONSTRUCTION SO THAT ALL UTILITIES MAY BE LOCATED IN THE FIELD. IF THE CONTRACTOR PERCEIVES THAT A CONFLICT BETWEEN THE UTILITIES AND THE TRAFFIC SIGNAL WILL OCCUR, THE CONTRACTOR SHALL NOTIFY THE PROJECT ENGINEER IMMEDIATELY SO THAT THE CONFLICT MAY BE RESOLVED.

WESTBOUND MD 133 TS. 4914

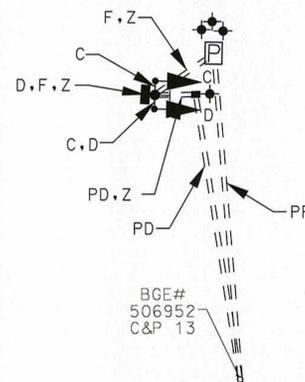

EASTBOUND MD 133 TS. 4913

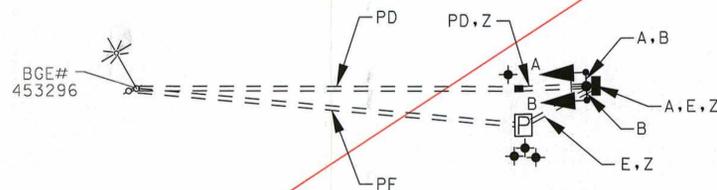

**WIRING KEY**

A,B,C,D	5-CONDUCTOR ELECTRICAL CABLE (NO. 14 AWG)
E,F	1-CONDUCTOR ELECTRICAL CABLE (NO. 8 AWG - THHN/THWN), 3 RUNS
Z	STRANDED BARE COPPER GROUND WIRE (NO. 6 AWG) PROPOSED UNDERGROUND POWER FEED
PF	PROPOSED UNDERGROUND POWER FEED
PD	PHONE DROP BY VERIZON
+	PROPOSED GROUND ROD



STATE OF MARYLAND  
DEPARTMENT OF TRANSPORTATION  
STATE HIGHWAY ADMINISTRATION  
OFFICE OF TRAFFIC & SAFETY  
TRAFFIC ENGINEERING DESIGN DIVISION

MD 133 (OLD COURT ROAD) EB & WB AT  
EAST & WEST OF PARK SCHOOL DRIVE  
PIKESVILLE, MARYLAND

REVISIONS	GENERAL INFORMATION SHEET		
1 REDLINE NO. 1 06/2013 DELETE SHEET	SCALE NONE	DATE MAY 2013	CONTRACT NO. XY1375185
	DESIGNED BY GS	COUNTY BALTIMORE	
	DRAWN BY GS	LOGMILE 03013302.82	
	CHECKED BY BJJ	TMS NO. L862	
	FAP NO.	TOD NO.	
TS NO. 4913-GI 4914-GI	DRAWING SP-3	OF 3	SHEET NO. 3 OF 3