

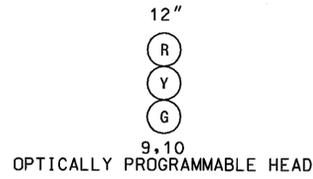


PROPOSED SIGNALS

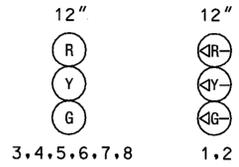

PROPOSED SIGNS

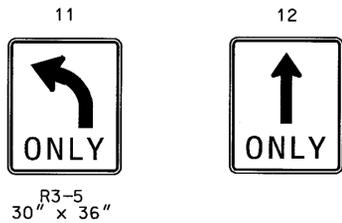


CONSTRUCTION DETAILS

- A. INSTALL 50 FT. WOOD POLE AND GUYS WITH TWO 20 FT. LIGHTING ARMS AND 250 WATT HPS LUMINAIRE. STATION 33+61; RIGHT 71 FEET.
- B. INSTALL 50 FT. WOODEN POLE AND GUY. STATION 34+56; RIGHT 81 FEET.
- C. INSTALL 3/8 IN. SPAN WIRE, SIGNAL HEADS AND SIGN.
- D. INSTALL 3/8 IN. SPAN WIRE, TETHER WIRE AND SIGNAL HEADS.
- E. COIL A MINIMUM OF 40 FEET OF CABLE TO ALLOW THE RELOCATION OF HEADS 1 AND 2 IN FUTURE STAGES.
- F. ADJUST VIDEO DETECTION CAMERAS AS DIRECTED BY THE ENGINEER.
- G. REMOVE AND DISPOSE OF EXISTING SPAN WIRE SIGNAL HEADS AND SIGNS.
- H. REMOVE AND DISPOSE OF EXISTING POLE, GUY WIRE AND LUMINARIES.
- I. REMOVE AND DISPOSE OF EXISTING SIGNAL HEADS AND SIGNS.
- J. INSTALL 24 IN. WHITE MARKING.

GENERAL NOTES:

1. MARKING TO BE INSTALLED AS SHOWN ON DRAWING NO. TCP-7.
2. SIGNAL HEADS 9 AND 10 SHALL BE OPTICALLY PROGRAMMABLE.
3. OPTICALLY PROGRAMMED SIGNAL HEADS SHALL BE TETHERED.
4. SEE DRAWING NO. SS-12 FOR WIRING DIAGRAM, PHASE CHART AND ADDITIONAL NOTES.


PHASING DIAGRAM

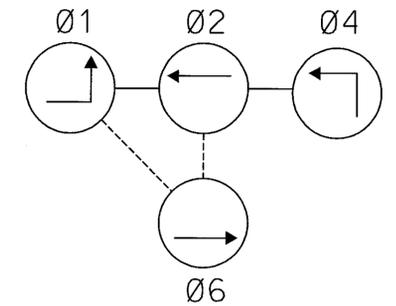

PHASING NOTES:

- PHASES ASSOCIATED BY A SOLID LINE WILL NOT OPERATE CONCURRENTLY.
- PHASES ASSOCIATED BY A DASHED LINE MAY/WILL OPERATE CONCURRENTLY.

MATCH LINE - STATION 30+00 (DWG NO. SS-10)

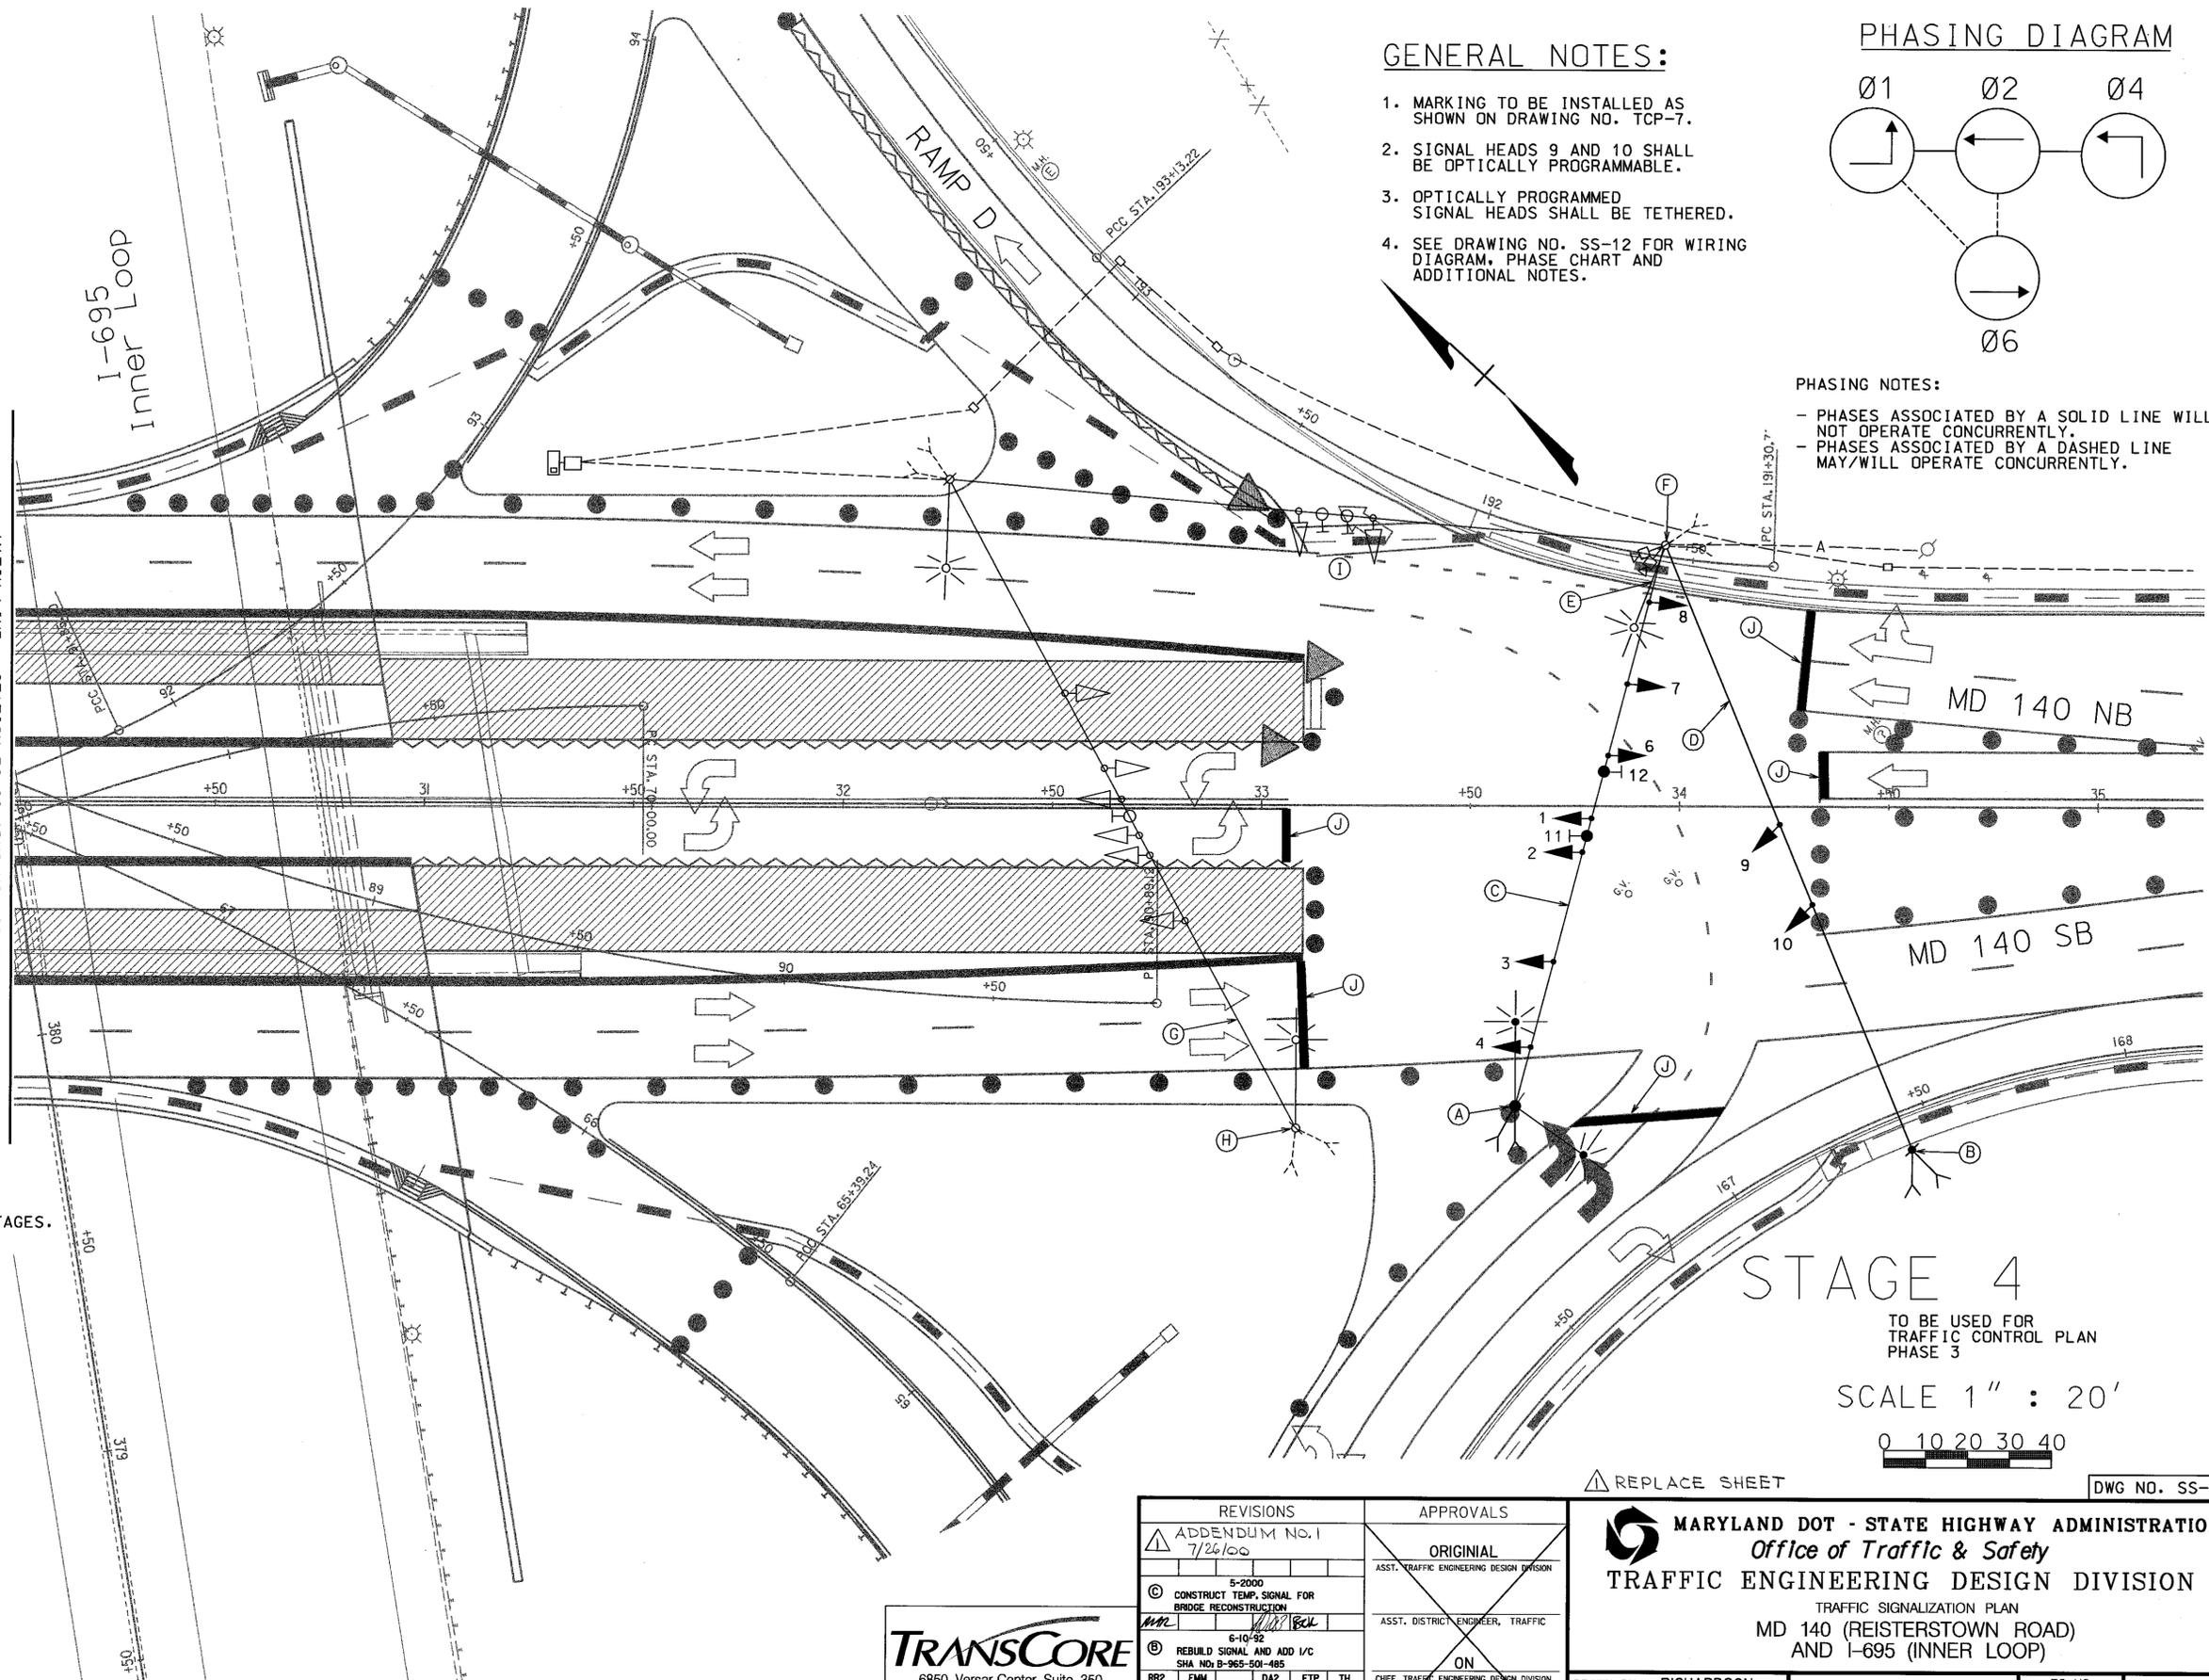

STAGE 4

TO BE USED FOR TRAFFIC CONTROL PLAN PHASE 3

SCALE 1" : 20'



REPLACE SHEET

DWG NO. SS-11

TRANSCORE
 6850 Versar Center, Suite 350
 Springfield Virginia 22151
 Phone: 703-658-4088

REVISIONS		APPROVALS	
ADDENDUM NO. 1 7/26/00		ORIGINAL	
5-2000 CONSTRUCT TEMP. SIGNAL FOR BRIDGE RECONSTRUCTION		ASST. TRAFFIC ENGINEERING DESIGN DIVISION	
6-10-92 REBUILD SIGNAL AND ADD 1/2 SHA. NO. B-965-501-485		ASST. DISTRICT ENGINEER, TRAFFIC	
AS-BUILT 12-12-73		ON	
		FILE	

MARYLAND DOT - STATE HIGHWAY ADMINISTRATION
 Office of Traffic & Safety
 TRAFFIC ENGINEERING DESIGN DIVISION
 TRAFFIC SIGNALIZATION PLAN
 MD 140 (REISTERSTOWN ROAD)
 AND I-695 (INNER LOOP)

DRAWN BY: RICHARDSON	F.A.P. NO.	TS NO.
CHECKED BY:	S.H.A. NO.	930 C - X4
SCALE: 1"=20'	COUNTY: BALTIMORE	T.I.M.S. NO.
DATE: 6-5-73	LOG MILE: 03014001.95	D-115

SHEET NO. 203 OF 256