


MD 144 IS ASSUMED TO RUN EAST, WEST.

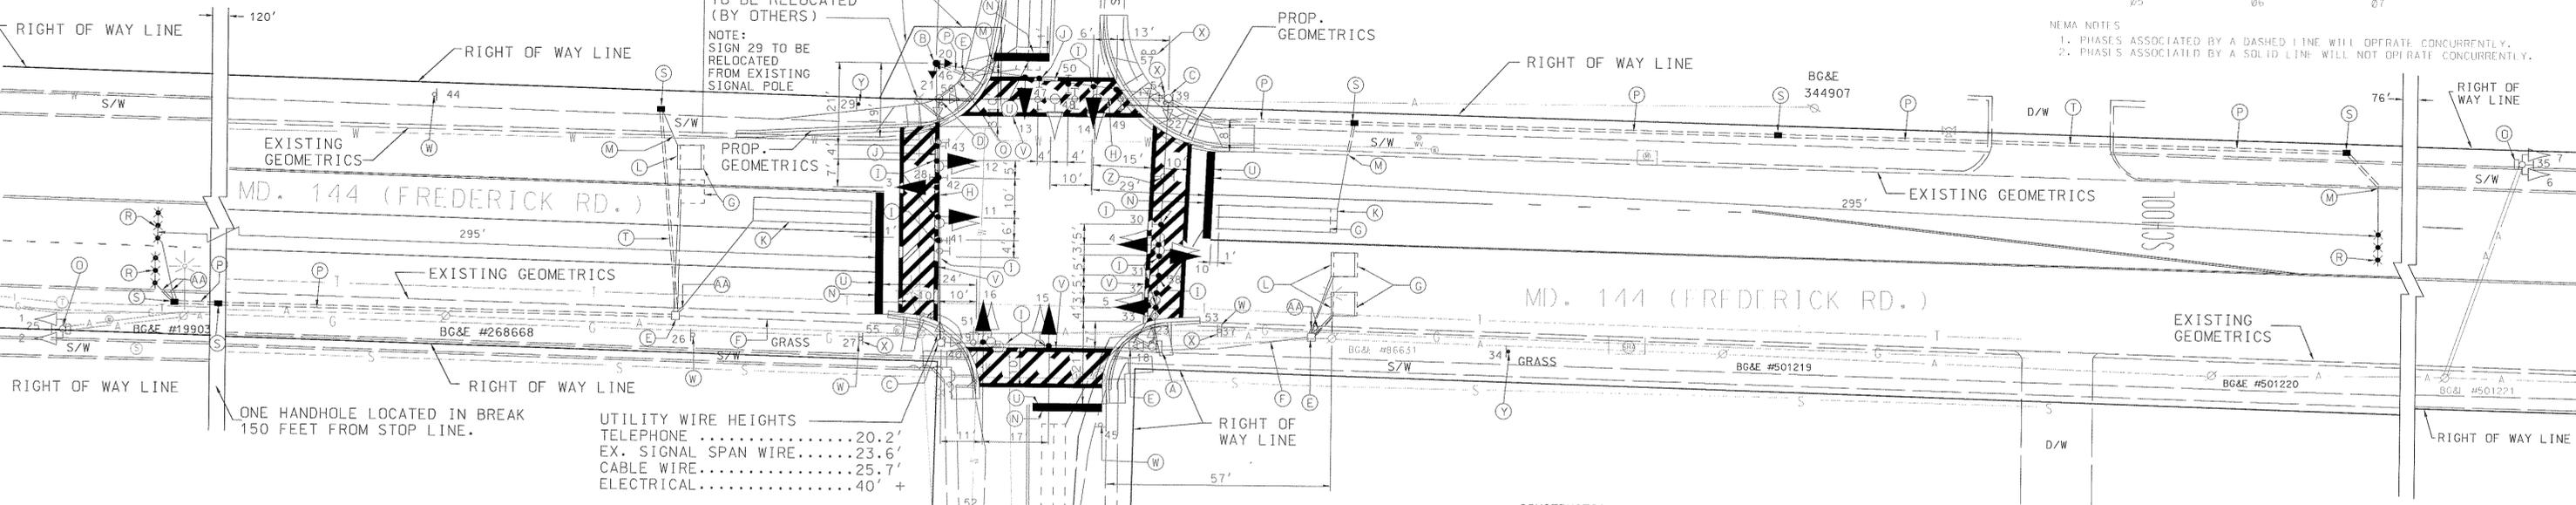


UTILITY WIRE HEIGHTS  
 TELEPHONE .....20.2'  
 EX. SIGNAL SPAN WIRE.....23.6'  
 CABLE WIRE.....25.7'  
 ELECTRICAL.....40' +

#### CONSTRUCTION DETAILS

- (A) EXISTING STRAIN POLE WITH POLE MOUNTED CONTROLLER TO REMAIN. ADD CABINET EXTENSION BASE TO CONTROLLER.
- (B) INSTALL 12" X 30' GALVANIZED STEEL STRAIN POLE AND SCHOOL CROSS WALK SIGN WITH TWO-WAY PEDESTRAIN SIGNAL HEADS AND PUSH BUTTON AND SIGN. (NOTE: 1-3 INCH SCHEDULE 80, 90 DEGREE PVC CONDUIT BEND, 4-1 3/4" X 96" ANCHOR BOLTS.
- (C) EXISTING STRAIN POLE TO REMAIN.
- (D) REMOVE EXISTING STRAIN POLE INCLUDING PEDESTRIAN SIGNAL HEADS.
- (E) EXISTING HAND HOLE TO REMAIN.
- (F) EXISTING CONDUIT TO REMAIN.
- (G) DISCONNECT EXISTING LOOP DETECTOR.
- (H) REMOVE EXISTING SPAN WIRE SIGNAL HEADS AND SIGNS.
- (I) INSTALL SIGNAL HEADS AND SIGNS-SPAN WIRE MOUNT TETHER 5 SECTION SIGNALS AND SIGNS TO BOTTOM SPAN WIRE.
- (J) INSTALL STEEL SPAN WIRE-3/8" DIAMETER W/ 1/4" Ø TETHER WIRE.
- (K) INSTALL 6'X30' LOOP DETECTOR ENCASED IN 1/4" FLEXIBLE TUBING (3-6-3 TURNS).
- (L) INSTALL 6'X6' LOOP DETECTOR ENCASED IN 1/4" FLEXIBLE TUBING (4 TURNS).
- (M) INSTALL 1 INCH GALVANIZED DETECTOR SLEEVE.
- (N) INSTALL 24 INCH WHITE PAVEMENT MARKING (STOP LINE).
- (O) EXISTING SIGNAL EQUIPMENT TO REMAIN.
- (P) INSTALL 3" SCHEDULE 80 PVC-TRENCHED.
- (Q) ABANDON EXISTING CONDUIT.
- (R) INSTALL MICROLOOP TRIPLE PROBE SET 500' LEAD IN.
- (S) INSTALL PROPOSED HANDHOLE.
- (T) INSTALL 3" SCHEDULE 80 PVC - BORED.
- (U) REMOVE EXISTING STRIPING (STOP LINE).
- (V) INSTALL 12 INCH WHITE PAVEMENT MARKING (CROSS WALK).
- (W) EXISTING GROUND MOUNT SIGN TO REMAIN.
- (X) REMOVE EXISTING GROUND MOUNT SIGN.
- (Y) INSTALL GROUND MOUNT SIGN.
- (Z) REMOVE EXISTING OVERHEAD SIGN.
- (AA) INSTALL 1 INCH LIQUID TIGHT FLEXIBLE NON-METALLIC CONDUIT FOR DETECTOR SLEEVE.

#### GENERAL NOTES

1. PAVEMENT MARKINGS ARE NOT TO BE INSTALLED UNTIL LOOP DETECTORS AND CONDUIT INSTALLATION ARE COMPLETE.
2. THE CONTRACTOR SHALL CONFIRM GEOMETRICS PRIOR TO THE INSTALLATION OF THE SIGNAL EQUIPMENT.
3. PAVEMENT MARKINGS ARE PROPOSED AND SHALL BE INSTALLED BY THE CONTRACTOR IN ACCORDANCE WITH S.H.A. STANDARDS.
4. SEE PAVEMENT MARKING SHEET FOR ADDITIONAL STRIPING.
5. STREET NAME AND ROUTE MARKER SIGNS ARE TO BE INSTALLED PARRALLEL TO THE ROADWAY.
6. ALL SIGNAL EQUIPMENT TO BE INSTALLED TO FINAL GRADE.
7. ALL UNDER GROUND OVERHEAD UTILITIES SHOWN ON THESE PLANS ARE SCHEMATIC AND MAY NOT BE COMPLETE. THE CONTRACTOR SHALL NOTIFY MISS UTILITY PRIOR TO THE CONSTRUCTION SO THAT ALL UTILITIES MAY BE LOCATED IN THE FIELD. IF THE CONTRACTOR PERCEIVES THAT A CONFLICT BETWEEN UTILITIES AND THE TRAFFIC SIGNAL WILL OCCUR, THE CONTRACTOR SHALL NOTIFY THE PROJECT ENGINEER IMMEDIATELY SO THAT THE CONFLICT MAY BE RESOLVED.

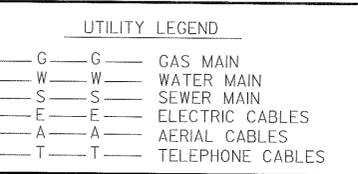

<b>REVISIONS</b> (F) INSTALL NEW STRAIN POLE IN N/W QUADRANT. QUE TO GEO. IMPR. REDUCE LOOPSS. SHA. BA3635176 3/00 (E) 11/84-INSTALLED H.I.B.'S ON E/B & W/B MD. 144 & N/B MD. 166 SHA 4855-25087025 WM DJD DAZ ETP TH D. 08/94		<b>APPROVALS</b> ORIGINAL NOTED ON FILE CHIEF, TRAFFIC ENGINEERING DESIGN DIVISION DIRECTOR, TRAFFIC & SAFETY	
<b>DESCRIPTION</b> (C) ASBUILT/RECONSTRUCT ADD NEW CABINET, SIGNALS AND WIRING 9/91 MCL DJD DAZ ETP TH		<b>DATE</b> 9-19-91	

<b>MARYLAND DOT - STATE HIGHWAY ADMINISTRATION</b> Office of Traffic & Safety <b>TRAFFIC ENGINEERING DESIGN DIVISION</b> MD. 144 & MD. 166/ ENTRANCE TO HILLCREST ELEM. SCHOOL			
DRAWN BY: MELODY COOK CHECKED BY: BA3635176 SCALE: 1"=20' DATE: 9-19-91	T.A.P. NO. BA3635176 S.H.A. NO. BALTIMORE COUNTY: BALTIMORE LOC. FILE: 03014402 72	TS NO. TS-3191 F T.I.M.S. NO. 0810 SHEET NO. 7 of 8	SEE TITLE SHEET