
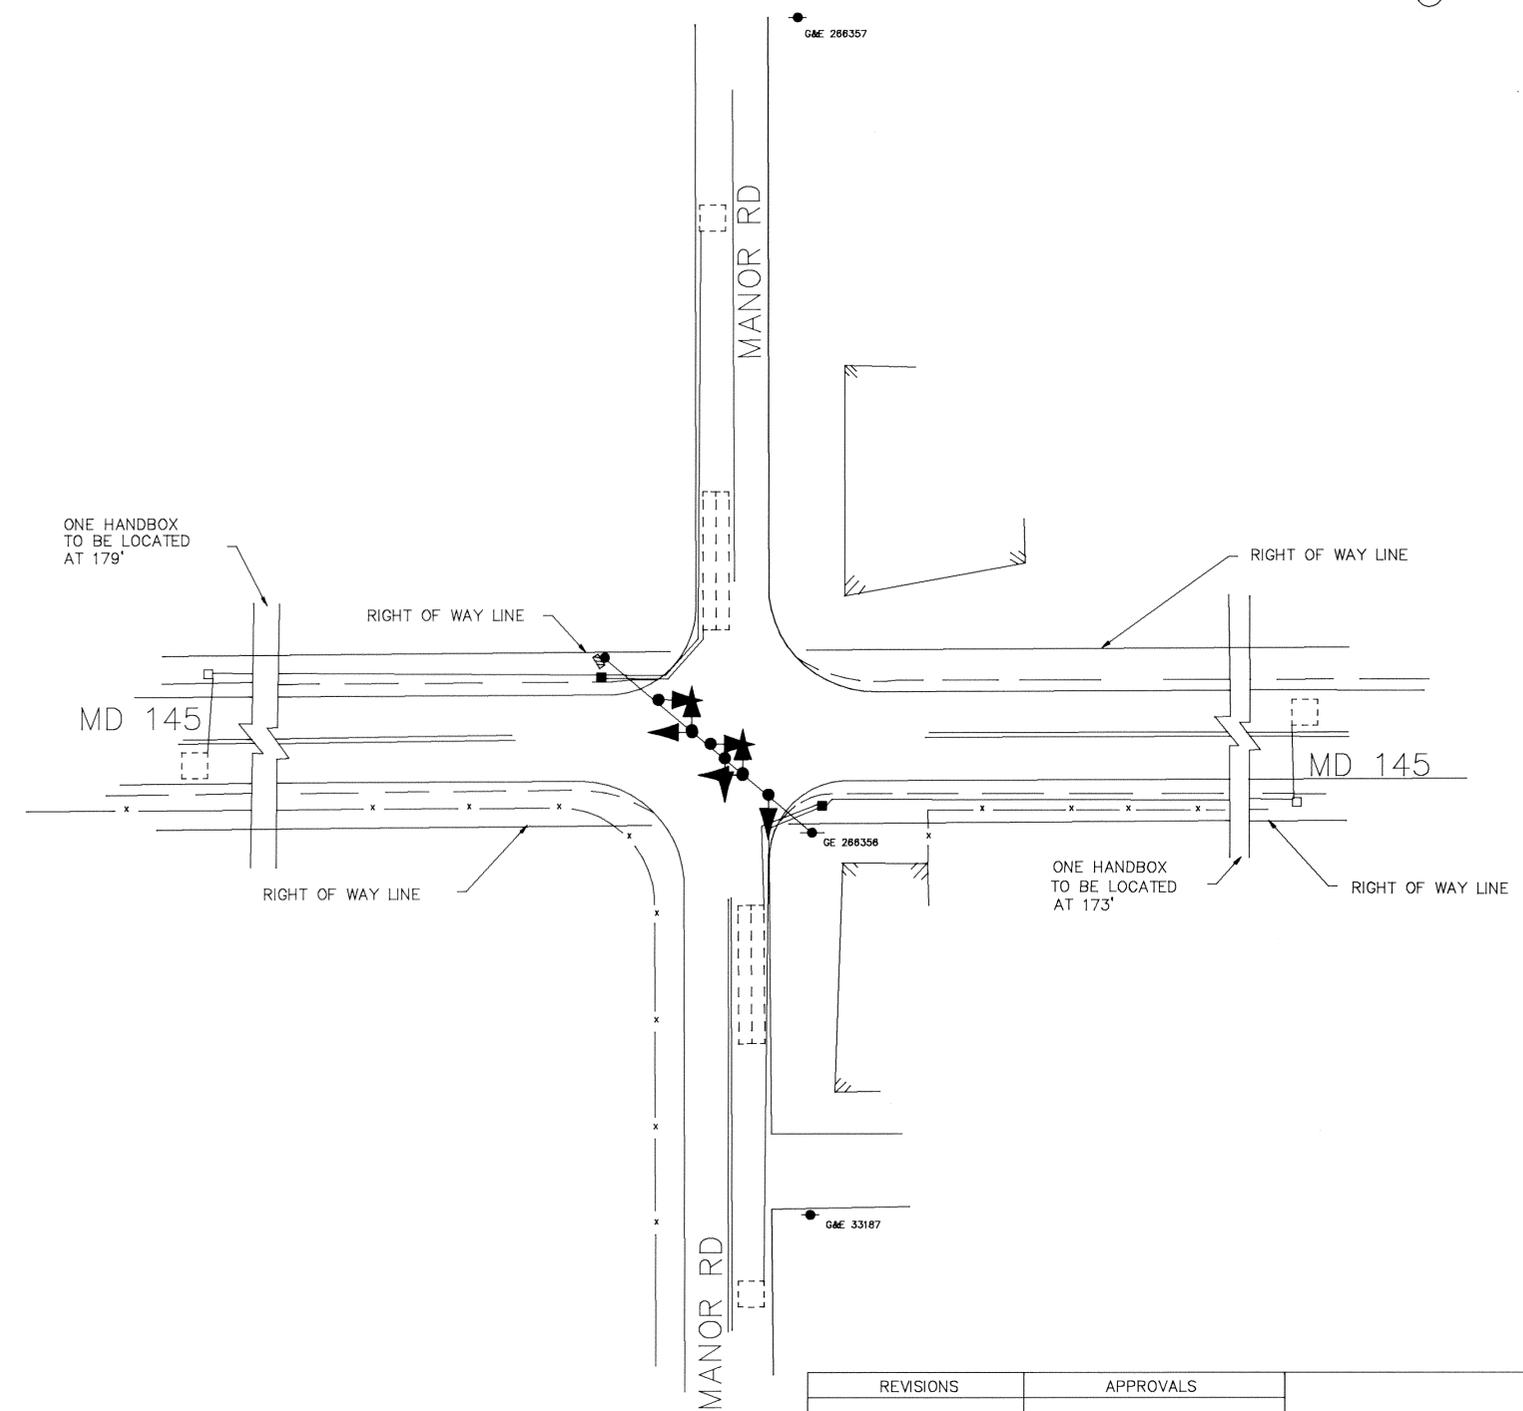
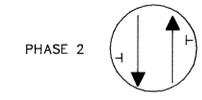


F. H. WA. REGION NO.	STATE	FED. AID PROJ. NO.	SHEET NO.	TOTAL SHEETS
3	MD.			

ALL 8" SIGNALS  
1-8

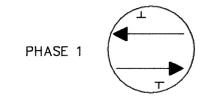

REVISIONS B 6-18-83 CONVERT FLASHER TO NORMAL SIGNAL OPERATION AW-679-501-085 A 5-28-74 ASBUILT B-214X-475 FWR		APPROVALS CHIEF, DESIGN SECTION ASST. DISTRICT ENGINEER, TRAFFIC CHIEF, BUREAU OF TRAFFIC ENGINEERING DEPUTY CHIEF ENGINEER, OFFICE OF TRAFFIC		MARYLAND DEPARTMENT OF TRANSPORTATION STATE HIGHWAY ADMINISTRATION - OFFICE OF TRAFFIC BUREAU OF TRAFFIC ENGINEERING	
DRAWN BY THE KID DES. BY: CHK. BY: WILLIAM F. FITCH		MD 145 @ MANOR ROAD COUNTY: BALTIMORE		DATE: 11-13-72 SCALE: 1"=20' F.A.P. NO.: S.H.A. NO. B-214X-475	
				TS/FILE NO. 784 B SHEET NO. OF	

03014506.93