
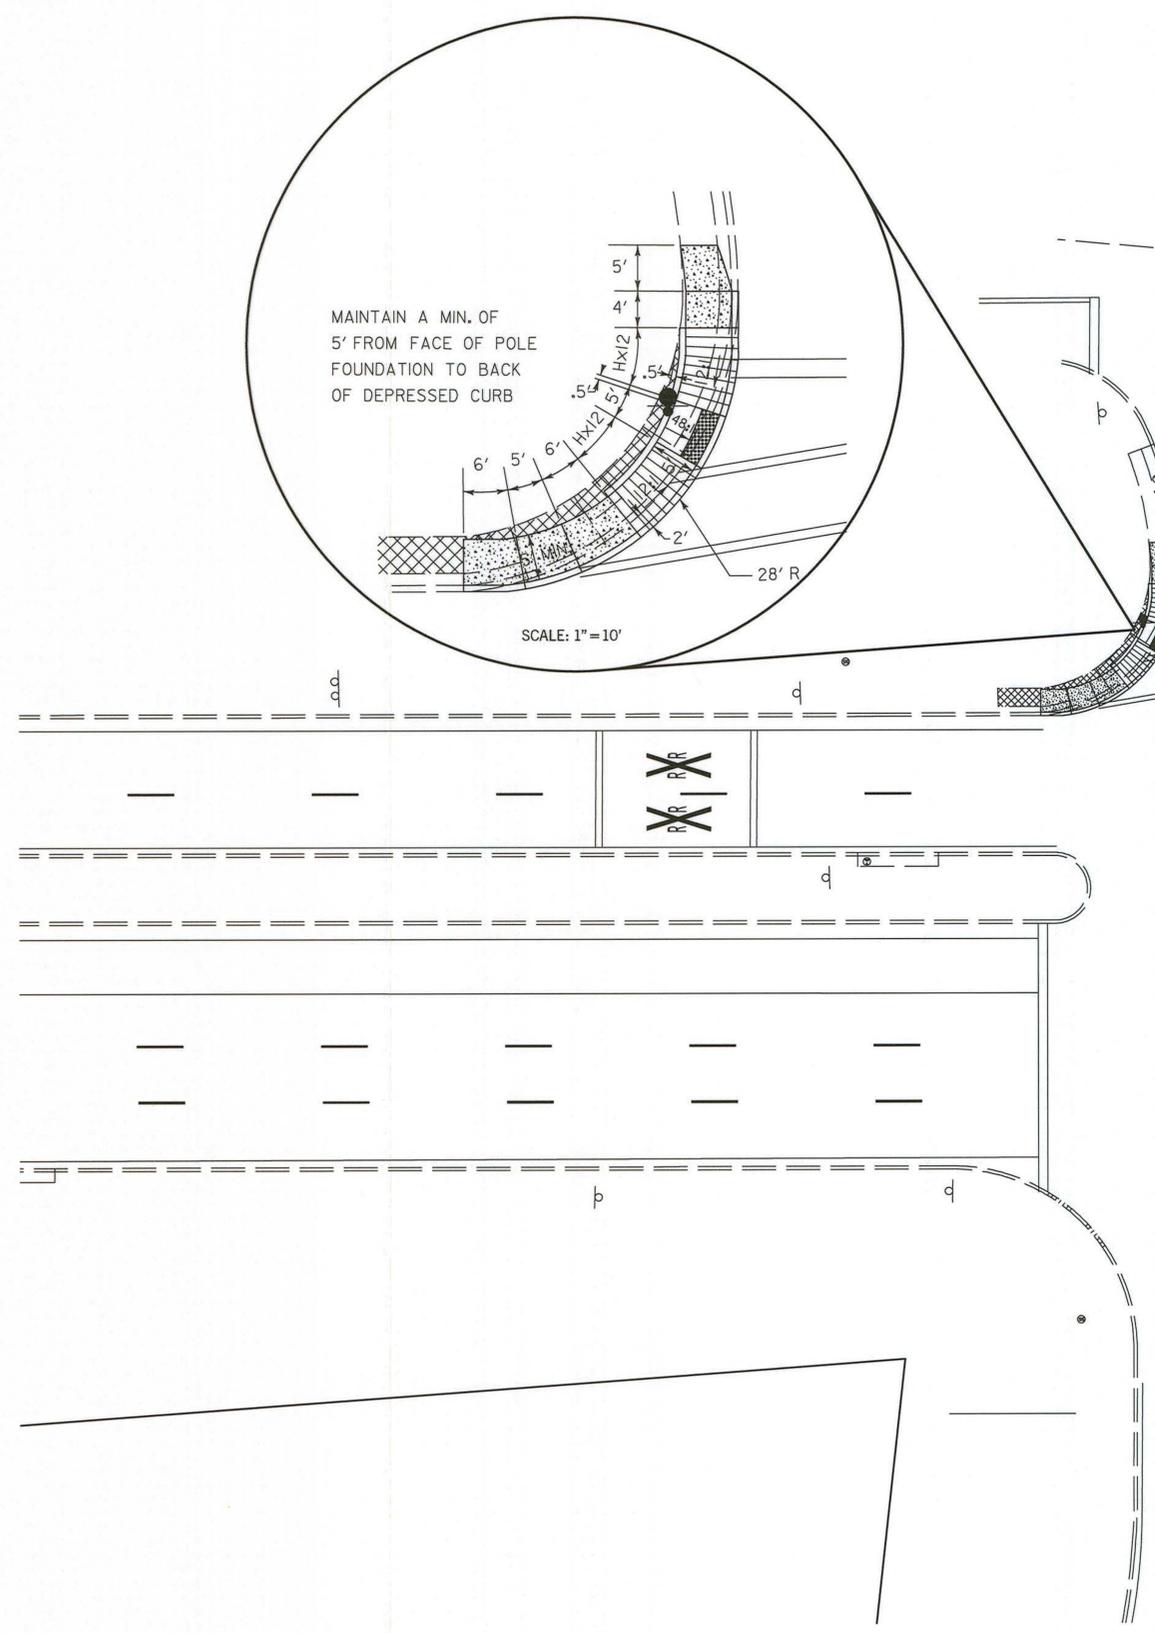
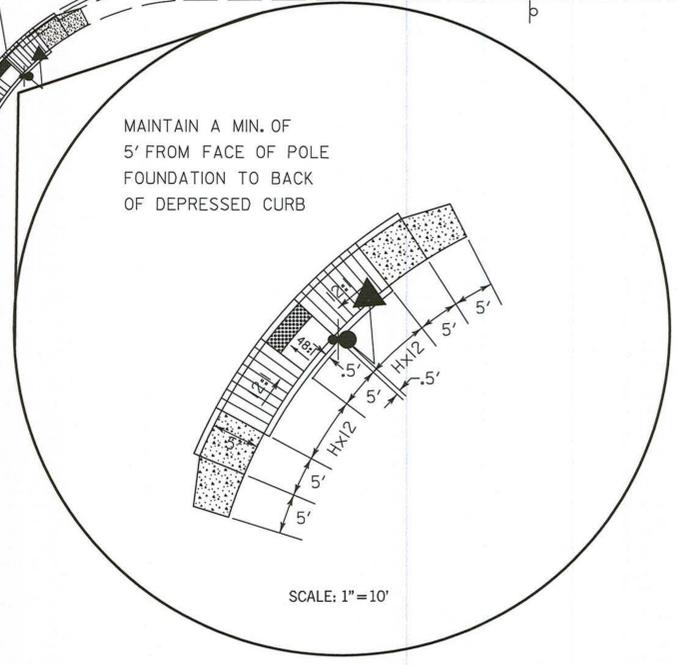
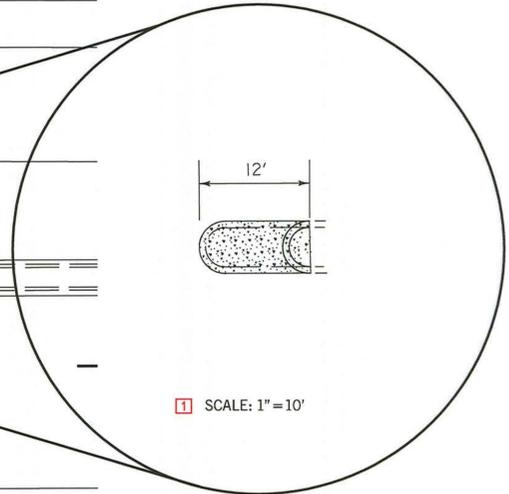
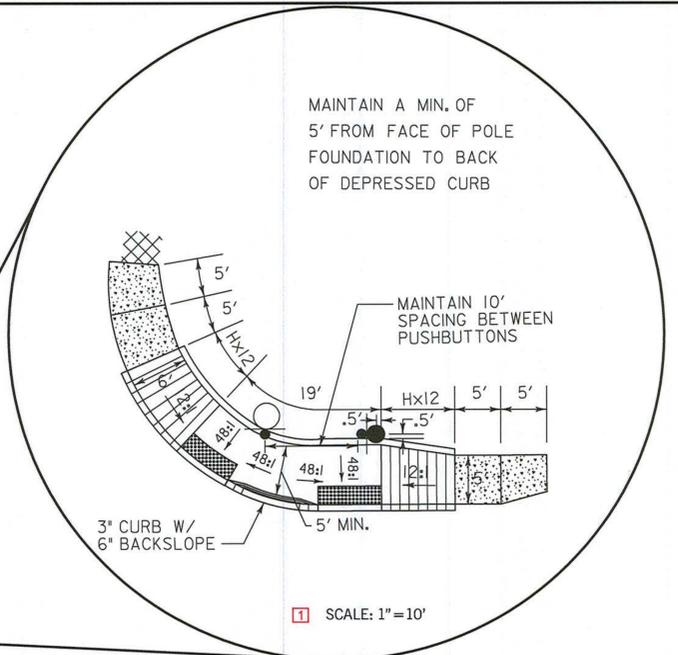


DIMENSION DIAGRAM  
SCALE: 1" = 20'

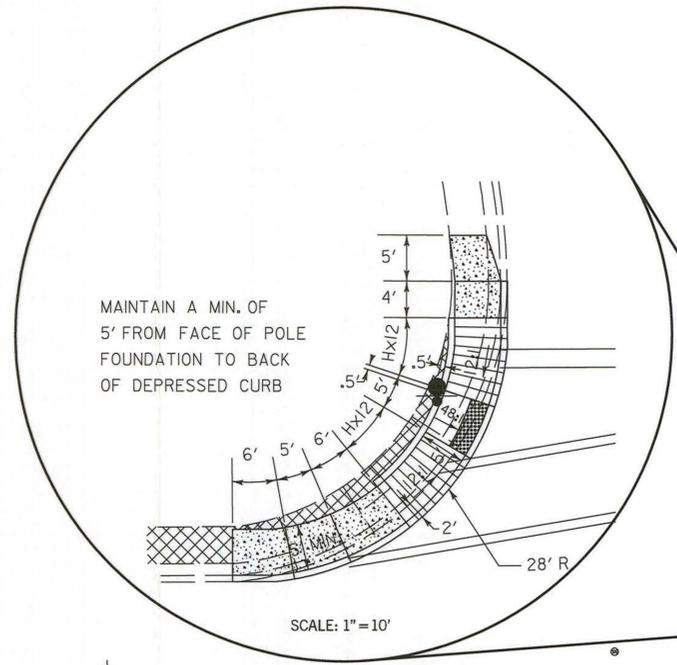

*[Signature]* 8-27-12  
 1 REDLINE REVISION NO. 1  
 REVISED ADA RAMP  
 8/21/2012

STATE OF MARYLAND DEPARTMENT OF TRANSPORTATION STATE HIGHWAY ADMINISTRATION OFFICE OF TRAFFIC & SAFETY TRAFFIC ENGINEERING DESIGN DIVISION MD 5 at Nike Drive /Mattawoman Drive Waldorf, Maryland	
<b>GENERAL INFORMATION SHEET</b>	
SCALE 1" = 20' ADVERTISED DATE _____	CONTRACT NO. XY2245185
DESIGNED BY B. Donoway	COUNTY Charles
DRAWN BY B. Donoway	LOGMILE 08000513.37
CHECKED BY N. Leary	TIMS NO. L334
F.A.P. NO. SEE TITLE SHEET	TOD NO. _____
TS NO. 3558 C	DRAWING TSP-2 OF 3 SHEET NO. 2 OF 3

**WR&A**  
 WHITMAN, REQUARDT  
 & ASSOCIATES, LLP  
 801 South Caroline Street, Baltimore, Maryland 21231

BY: bdonoway