
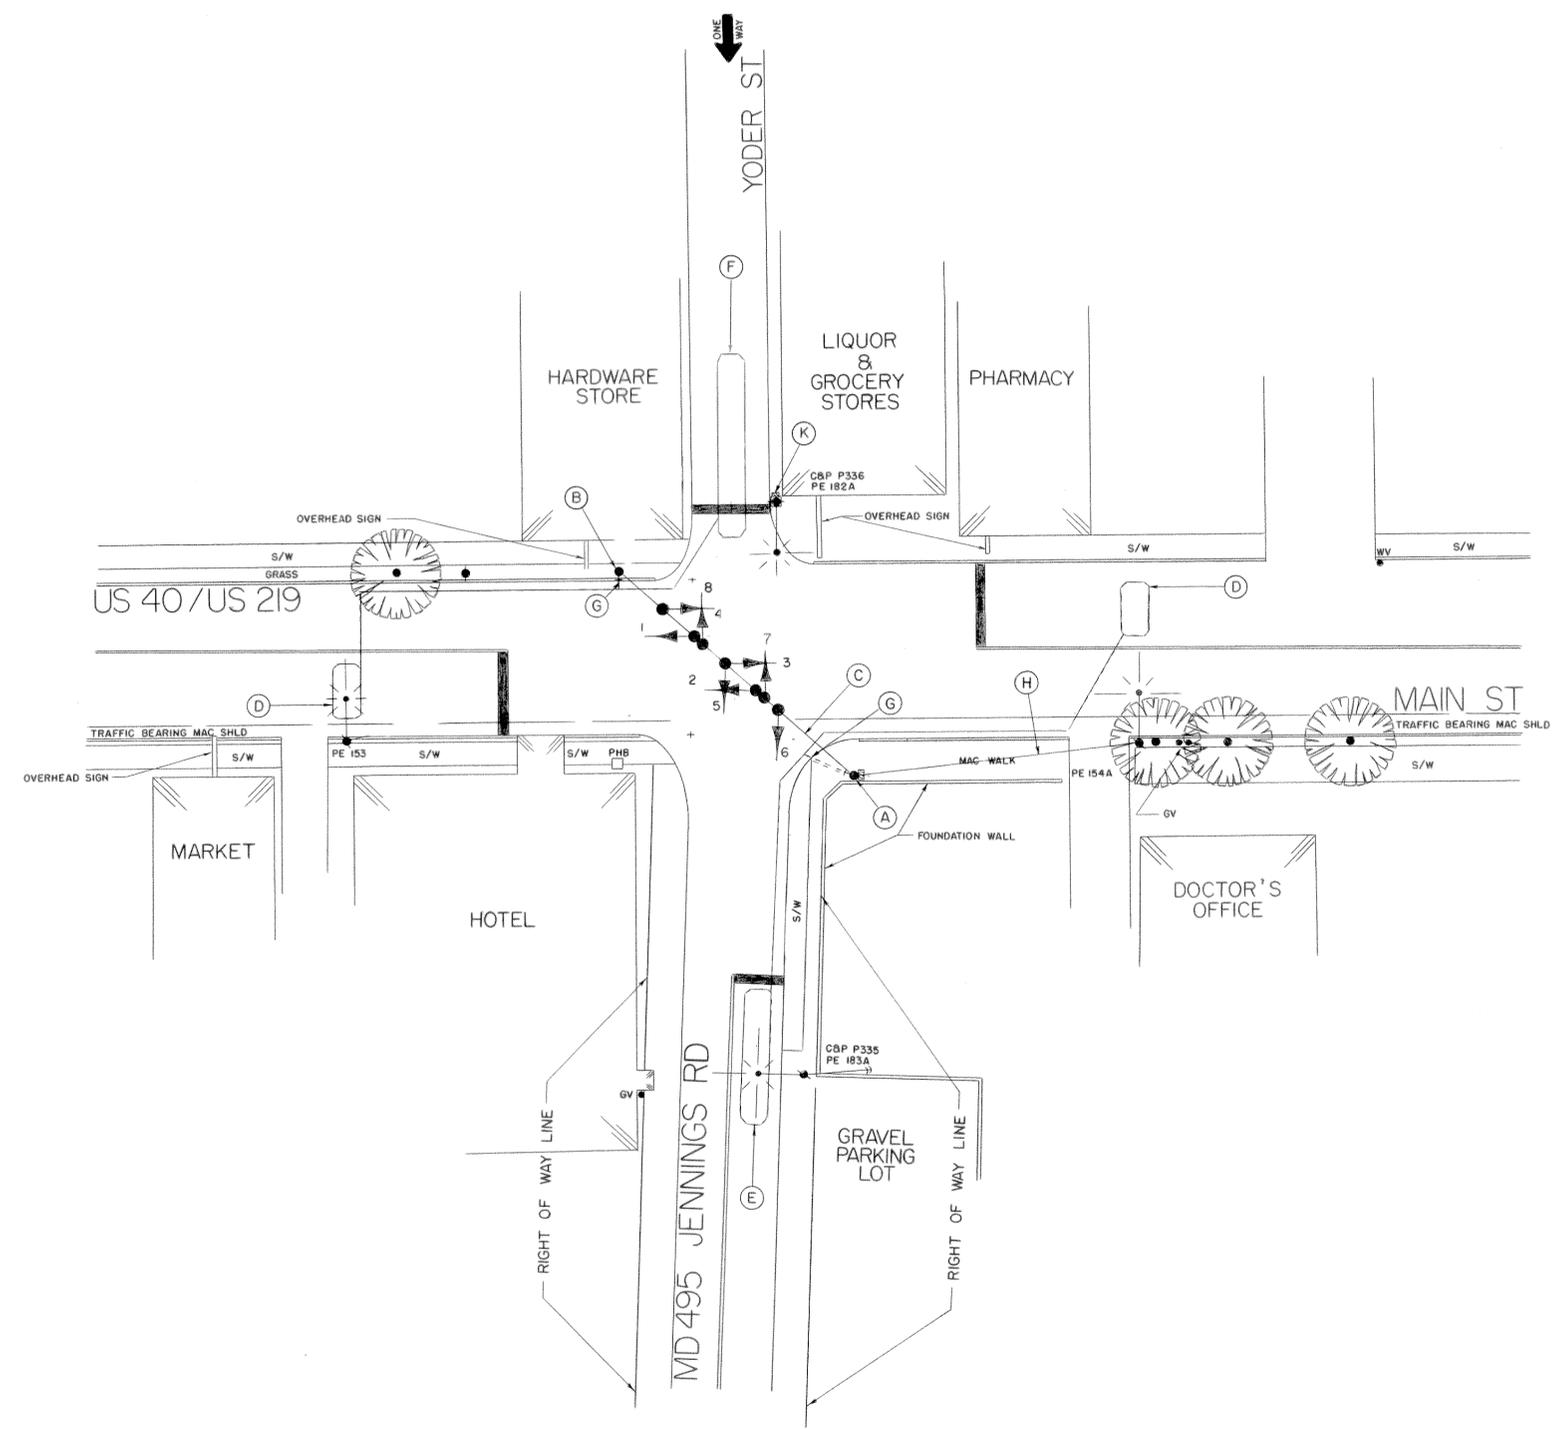


8" SIGNALS  
1-8  
R  
Y  
G

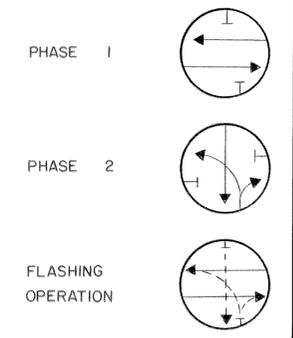

*Gene R. Shaul* 4/7/75  
APPROVAL: REGIONAL TRAFFIC ENGINEER

4/14/75 *Edward T. Pankas Jr.*  
APPROVAL: CHIEF BUREAU OF TRAFFIC ENGINEERING

*Gene R. Shaul* 4/5/75  
APPROVAL: ASST. CHIEF ENGINEER TRAFFIC

A	ASBUILT	11-19-75	
		G-394X-000-685	
WDB			
REVISIONS			

STATE OF MARYLAND  
DEPARTMENT OF TRANSPORTATION  
STATE HIGHWAY ADMINISTRATION  
TRAFFIC DIVISION - BUREAU OF TRAFFIC ENGINEERING  
  
US 40 & MD 495

SCALE 1"=20' DATE 1-21-75 CONTRACT NO.

DRAWN BY: R. BRITTON COUNTY: GARRETT

DESIGNED BY: *Edward T. Pankas Jr.* SIGNAL NO.: 11108

CHECKED BY: *A. Budnick* 4/14/75 DRAWING NO. TS-1268A