

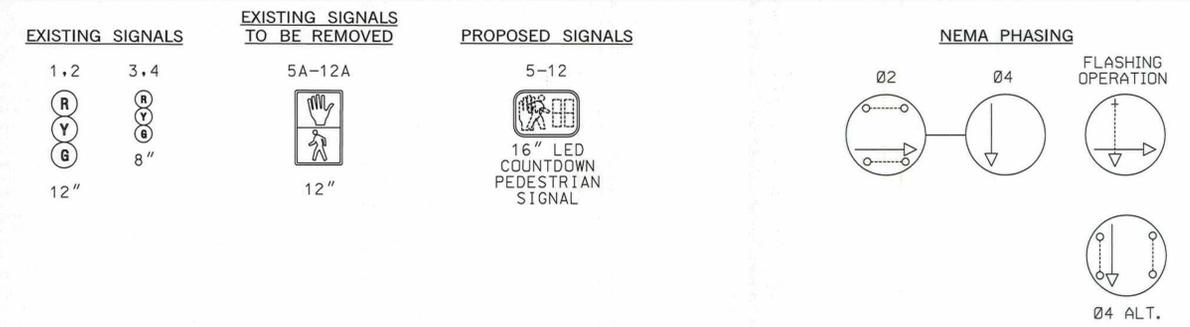


MD 924 IS ASSUMED TO RUN IN A NORTH-SOUTH DIRECTION

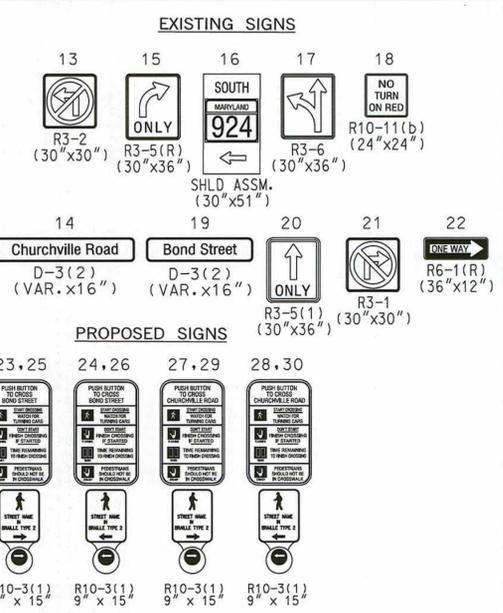

NOTE: PHASES ASSOCIATED BY A DASHED LINE WILL OPERATE CONCURRENTLY. PHASES ASSOCIATED BY A SOLID LINE WILL NOT OPERATE CONCURRENTLY.

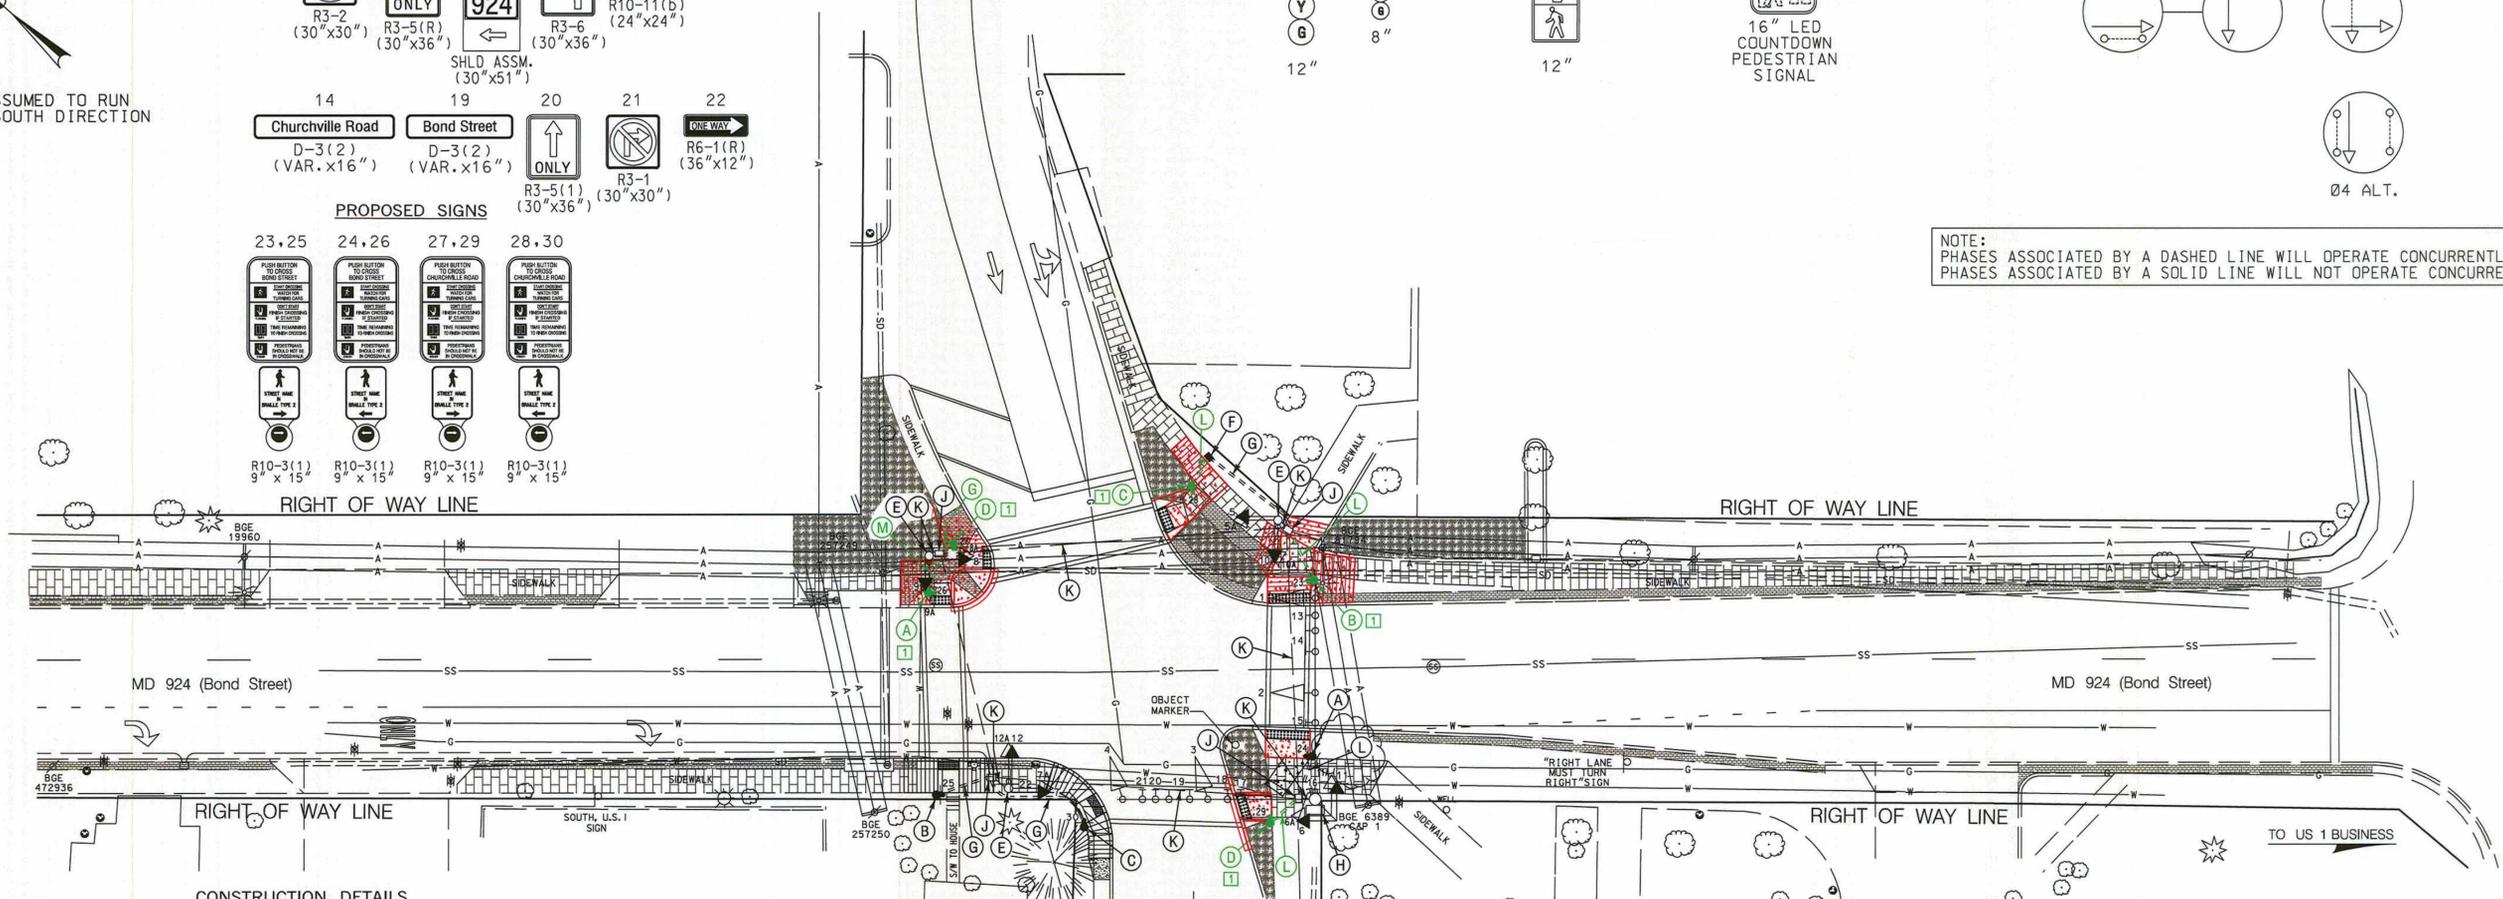

- CONSTRUCTION DETAILS**
- INSTALL CONCRETE FOUNDATION WITH 5 FT. STEEL PEDESTAL POLE WITH MODIFIED BREAKAWAY BASE STANDARD NO. MD 801.01-01, AUDIBLE/TACTILE PEDESTRIAN PUSHBUTTON INSTALLED WITH VIBRATING ARROW POINTING LEFT AND R10-3(1) SIGN. (SIGN TO READ "PUSH BUTTON TO CROSS BOND STREET"). (INSTALL 1-3 IN. SCHEDULE 80, 90 DEGREE PVC ELECTRICAL CONDUIT BEND IN PEDESTAL BASE).
 - INSTALL CONCRETE FOUNDATION WITH 5 FT. STEEL PEDESTAL POLE WITH MODIFIED BREAKAWAY BASE STANDARD NO. MD 801.01-01, AUDIBLE/TACTILE PEDESTRIAN PUSHBUTTON INSTALLED WITH VIBRATING ARROW POINTING RIGHT AND R10-3(1) SIGN. (SIGN TO READ "PUSH BUTTON TO CROSS BOND STREET"). (INSTALL 1-3 IN. SCHEDULE 80, 90 DEGREE PVC ELECTRICAL CONDUIT BEND IN PEDESTAL BASE).
 - INSTALL CONCRETE FOUNDATION WITH 5 FT. STEEL PEDESTAL POLE WITH MODIFIED BREAKAWAY BASE STANDARD NO. MD 801.01-01, AUDIBLE/TACTILE PEDESTRIAN PUSHBUTTON INSTALLED WITH VIBRATING ARROW POINTING LEFT AND R10-3(1) SIGN. (SIGN TO READ "PUSH BUTTON TO CROSS CHURCHVILLE ROAD"). (INSTALL 1-3 IN. SCHEDULE 80, 90 DEGREE PVC ELECTRICAL CONDUIT BEND IN PEDESTAL BASE).
 - INSTALL CONCRETE FOUNDATION WITH 5 FT. STEEL PEDESTAL POLE WITH MODIFIED BREAKAWAY BASE STANDARD NO. MD 801.01-01, AUDIBLE/TACTILE PEDESTRIAN PUSHBUTTON INSTALLED WITH VIBRATING ARROW POINTING RIGHT AND R10-3(1) SIGN. (SIGN TO READ "PUSH BUTTON TO CROSS CHURCHVILLE ROAD"). (INSTALL 1-3 IN. SCHEDULE 80, 90 DEGREE PVC ELECTRICAL CONDUIT BEND IN PEDESTAL BASE).
 - USE EXISTING PEDESTAL POLE. REMOVE EXISTING PEDESTRIAN SIGNAL HEADS, PUSHBUTTON AND R10-4(1) SIGN AND INSTALL NEW L.E.D. COUNTDOWN PEDESTRIAN HEADS. CLEAN EXISTING DRILLED HOLE WITH BRUSH AND SPRAY COLD GALVANIZING COMPOUND ON THE AFFECTED AREA.
 - INSTALL HANDHOLE.
 - INSTALL 3 IN. PVC SCHEDULE 80 ELECTRICAL CONDUIT - TRENCHED.
 - USE EXISTING STEEL POLE AND POLE MOUNTED CABINET AND CONTROLLER. REMOVE EXISTING PEDESTRIAN SIGNAL HEADS, PUSHBUTTON AND R10-4(1) SIGN AND INSTALL NEW L.E.D. COUNTDOWN PEDESTRIAN HEADS. CLEAN EXISTING DRILLED HOLE WITH BRUSH AND SPRAY COLD GALVANIZING COMPOUND ON THE AFFECTED AREA. INSTALL ONE 2 INCH BLIND COUPLING IN BOTTOM OF POLE MOUNTED CABINET BY FIELD DRILLING HOLE INTO EXISTING STRAIN POLE A MINIMUM OF 12 INCHES FROM EXISTING BLIND COUPLING. INSTALL AUDIBLE/TACTILE PEDESTRIAN PUSHBUTTON BASE UNIT.
 - USE EXISTING HANDHOLE.
 - USE EXISTING CONDUIT.
 - REMOVE EXISTING SIDEWALK AND INSTALL 3 IN. PVC SCHEDULE 80 ELECTRICAL CONDUIT - TRENCHED. REPLACE 5 INCH CONCRETE SIDEWALK.
 - REMOVE EXISTING BRICK PAVERS, INSTALL 3 IN. PVC SCHEDULE 80 ELECTRICAL CONDUIT - TRENCHED AND RESET BRICK PAVERS.

- GENERAL NOTES**
- ALL TRAFFIC SIGNAL FOUNDATIONS SHALL BE INSTALLED AT THE FINAL SIDEWALK OR CURB GRADE FOR CLOSED SECTIONS, HIGHEST ROADWAY PROFILE GRADE FOR OPEN SECTIONS. TO MEET CLEARANCES AS SPECIFIED IN MD 816.03, MD 818.01, MD 818.02, MD 818.04. THE CONTRACTOR SHALL VERIFY ULTIMATE GRADES PRIOR TO THE INSTALLATION OF ALL SIGNAL EQUIPMENT.
 - THE CONTRACTOR SHALL VERIFY ALL UNDERGROUND UTILITIES PRIOR TO INSTALLING PROPOSED SIGNAL EQUIPMENT. IF ANY UTILITY CONFLICTS SHOULD ARISE THE CONTRACTOR SHALL CONTACT THE PROJECT ENGINEER.
 - THE CONTRACTOR SHALL VERIFY ALL PROPOSED POLE AND CABINET LOCATIONS PRIOR TO INSTALLATION.
 - ALL EXISTING TRAFFIC SIGNAL EQUIPMENT REMOVED SHALL BECOME THE PROPERTY OF THE SIGNAL CONTRACTOR UPON COMPLETION OF THE NEW SIGNAL.
 - THE CONTRACTOR SHALL BE RESPONSIBLE FOR TERMINATING ALL SIGNAL CABLES TO THE APPROPRIATE TERMINALS AND PROPERLY LABEL EACH CABLE.
 - REMOVE AND DISPOSE OF ALL UNUSED SIGNAL CABLE.
 - PUSHBUTTONS ARE TO BE LOCATED SO THAT THEY CAN BE ACTIVATED BY A PERSON IN A WHEELCHAIR REACHING LESS THAN 18" FROM A 60" x 60" LEVEL LANDING AREA WITH A CROSS SLOPE OF LESS THAN OR EQUAL TO 2%.
 - THE 10' SEPARATION BETWEEN PUSHBUTTONS IS TO BE MEASURED FROM FACE OF PUSHBUTTON TO FACE OF PUSHBUTTON, NOT CENTER TO CENTER OF POLE.
 - PUSHBUTTON ARROWS ARE TO BE PARALLEL TO THE CROSSING FOR WHICH THEY ARE INTENDED.
 - LOCATION OF ACCESSIBLE PEDESTRIAN SIGNAL PUSHBUTTONS MUST MEET LOCATION REQUIREMENTS OF MUTCD SEC. 4E.09 AND FIG. 4E-2 AND THE NCHRP PUBLICATION, "ACCESSIBLE PEDESTRIAN SIGNALS: GUIDE TO BEST PRACTICE". IF NOT MET, THE CONTRACTOR IS TO STOP WORK ON PUSHBUTTON LOCATIONS UNTIL A DESIGN WAIVER IS OBTAINED, APPROVED BY THE DIRECTOR, OFFICE OF TRAFFIC AND SAFETY.
 - THE CONTRACTOR SHALL REPAIR ANY DAMAGE TO EXISTING SIDEWALKS CAUSED BY THE INSTALLATION OF SIGNAL EQUIPMENT.
 - REFER TO SHEET TSP-5 FOR DIMENSIONS OF SIGNAL EQUIPMENT WITHIN INTERSECTION.

GREENLINE REVISION NO. 1
TEDD'S APPROVAL/DATE

SHA STATE OF MARYLAND
 DEPARTMENT OF TRANSPORTATION
 STATE HIGHWAY ADMINISTRATION
 OFFICE OF TRAFFIC & SAFETY
 TRAFFIC ENGINEERING DESIGN DIVISION
 MD 924 (Bond Street) and MD 22/MD 922E (Churchville Road)
 Bel Air, Maryland

WR&A
 WHITMAN, REQUARDT & ASSOCIATES, LLP
 801 South Caroline Street, Baltimore, Maryland 21231

| | | | |
|---|--|---|---|
| GEOMETRIC LEGEND --- EXISTING --- PROPOSED UTILITY LEGEND --- SD --- STORM DRAIN --- G --- GAS MAIN --- W --- WATER MAIN --- S --- SEWER MAIN --- E --- ELECTRIC CABLES --- A --- AERIAL CABLES --- T --- TELEPHONE CABLES --- F --- FIBER-OPTIC | APPROVALS TEAM LEADER ASST. DIR. CHIEF DIR. CHIEF OFFICE DIRECTOR | REVISIONS (C) ADDED CPS/APS TMS NO. K859 CONTRACT NO. HA3885177 6/15/2011 REDLINE NO. 4 REVISED BASED ON HDD COMMENTS 04/09/1999 DM DCI REDLINE NO. 3 REVISED BASED ON HDD COMMENTS 10/23/1999 DM DCI | TRAFFIC SIGNALIZATION PLAN SCALE 1" = 20' ADVERTISED DATE 7/10/1989 CONTRACT NO. AW-104-501-585 DESIGNED BY G. Simmers COUNTY Harford DRAWN BY G. Simmers LOGMILE 12092405.51 CHECKED BY F.A.P. NO. TOD NO. |
| | | TS NO. 1479 E DRAWING TSP-3 OF 7 SHEET NO. 161 OF 162 | |