



F. H. WA. REGION NO.	STATE	FED. AID PROJ. NO.	SHEET NO.	TOTAL SHEETS
3	MD.		3	18

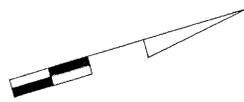


SALISBURY STATE COLLEGE

SALISBURY STATE COLLEGE PARKING LOT

REVISION D

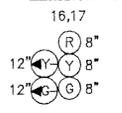



SIGNS

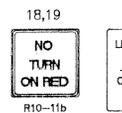

REVISION D




SIGNALS

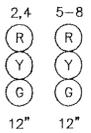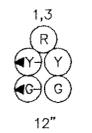


REVISION E



NEMA PHASING

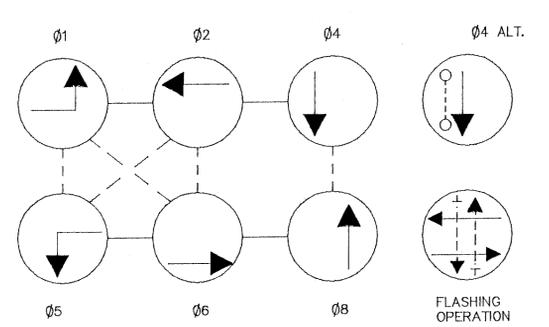

- NEMA PHASING NOTES
1. PHASES ASSOCIATED BY A DASHED LINE WILL OPERATE CONCURRENTLY.
 2. PHASES ASSOCIATED BY A SOLID LINE WILL NOT OPERATE CONCURRENTLY.

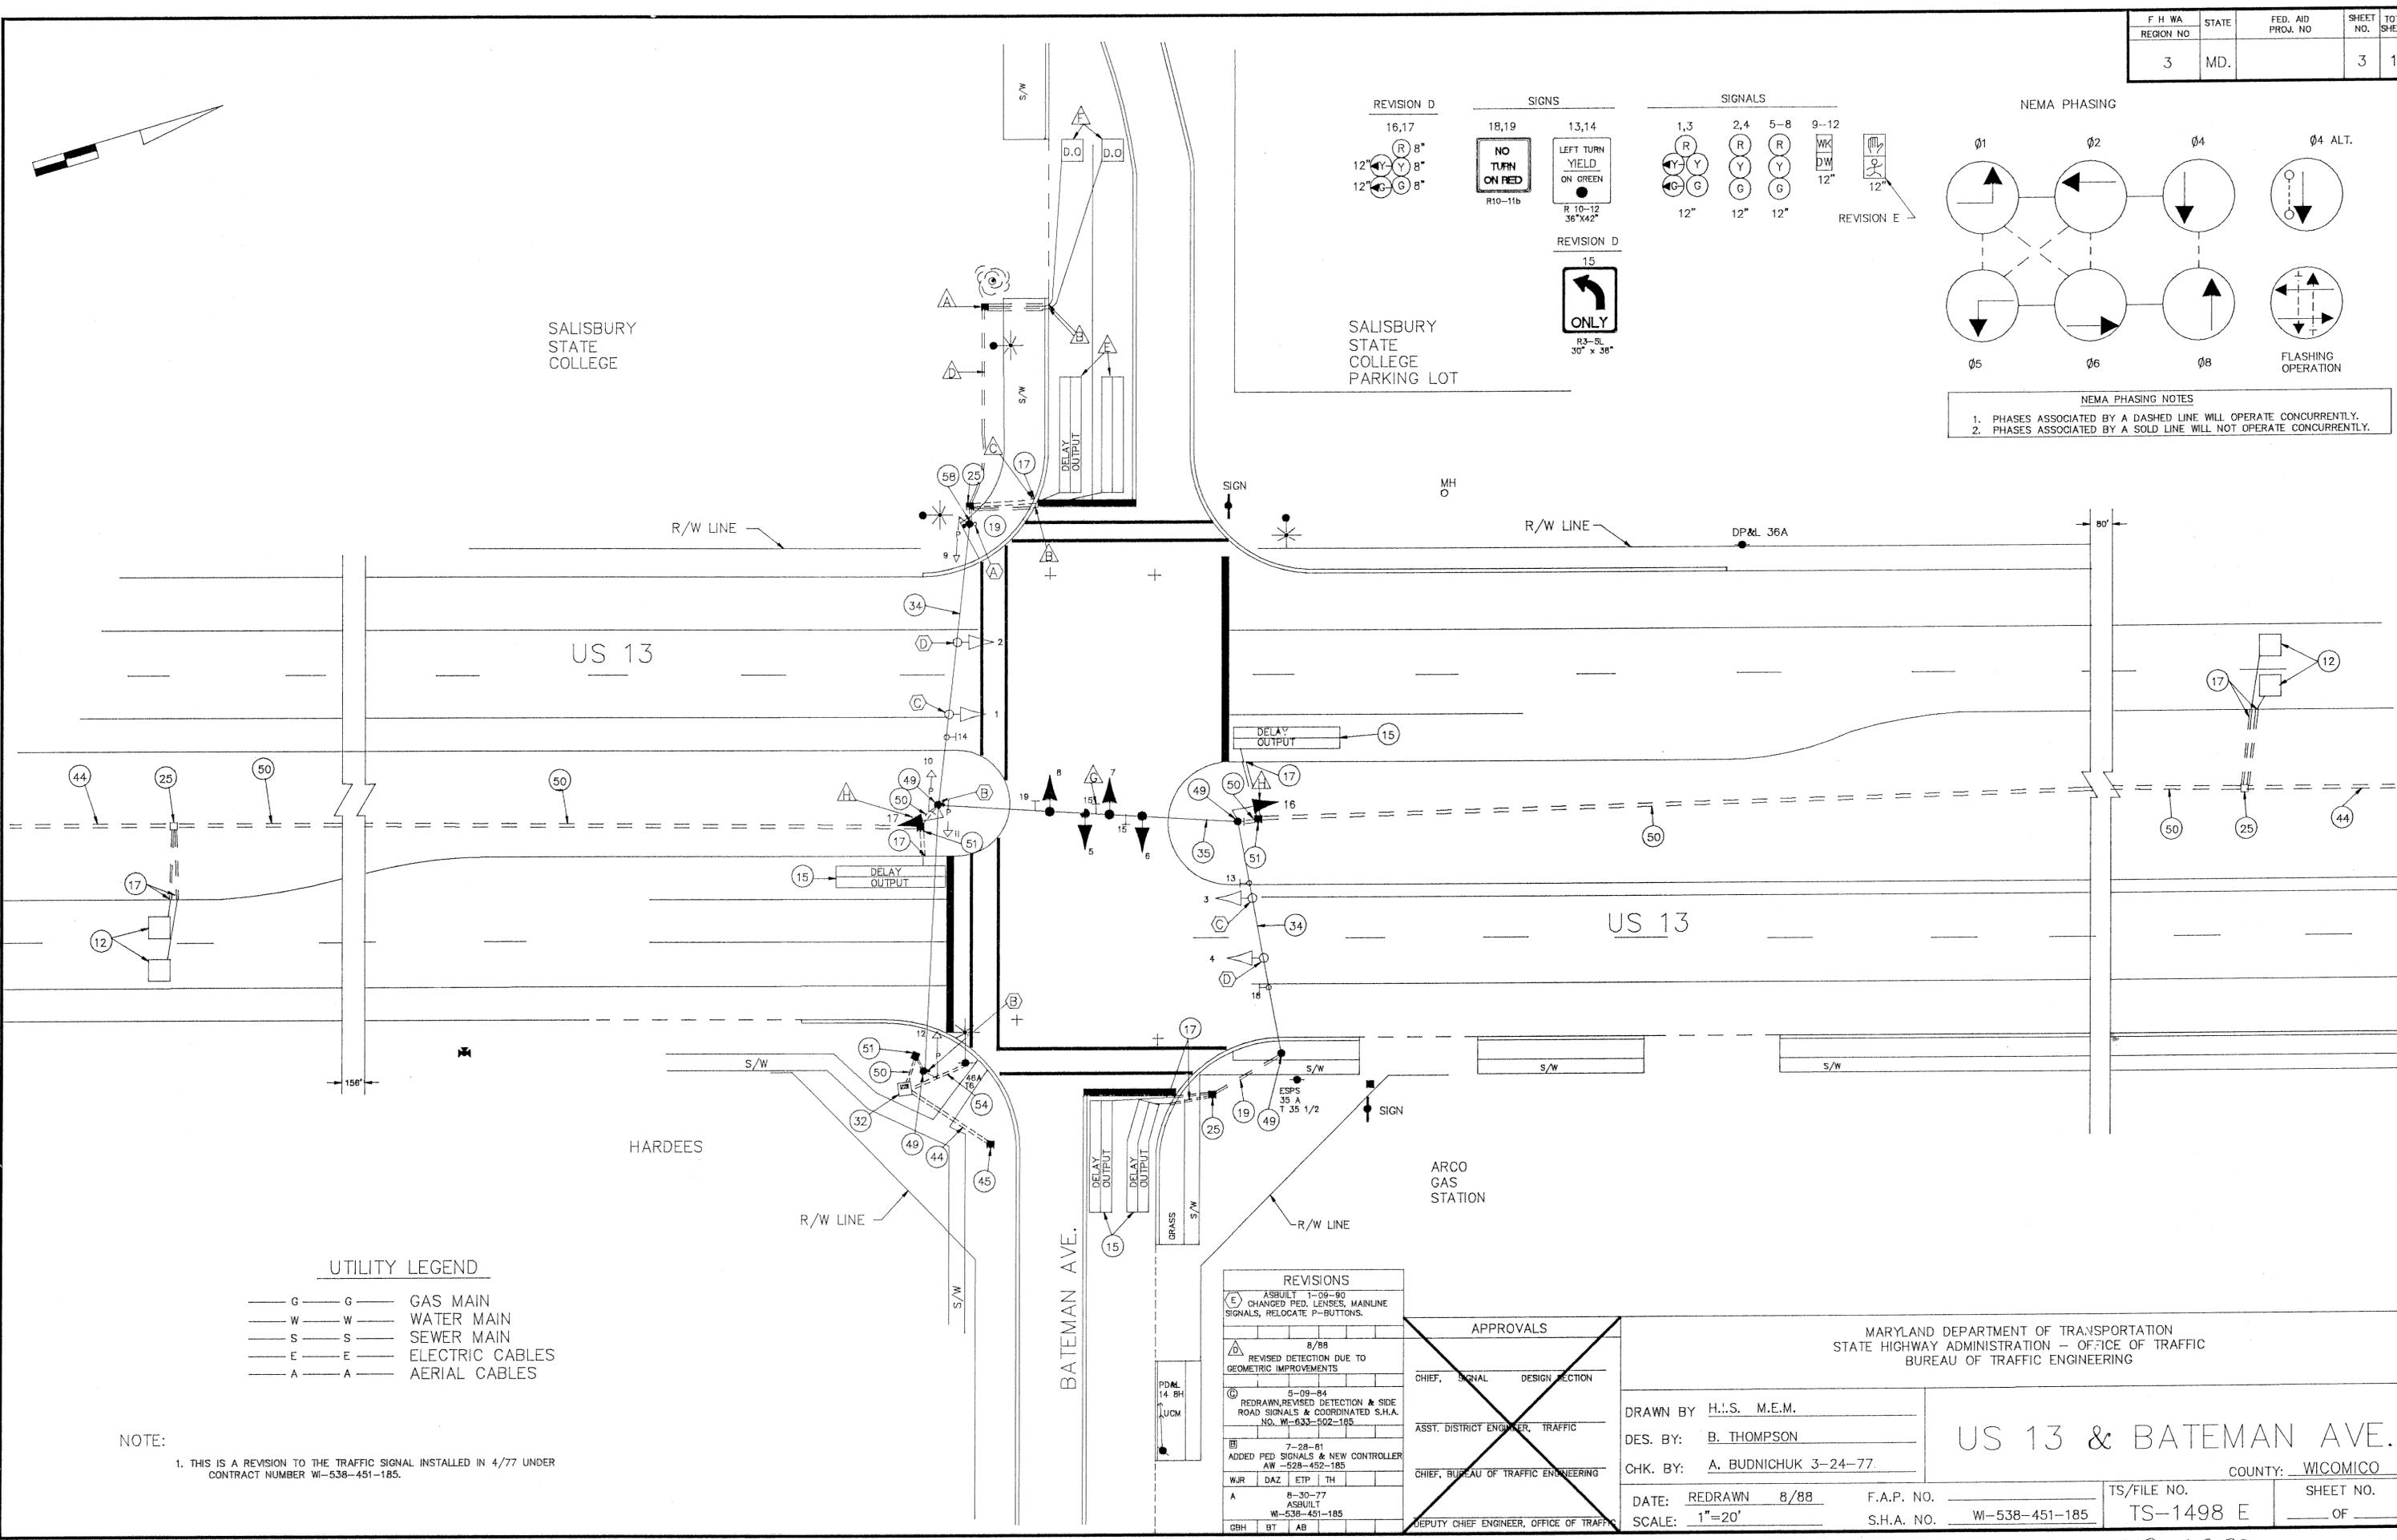

UTILITY LEGEND

- G — G — GAS MAIN
- W — W — WATER MAIN
- S — S — SEWER MAIN
- E — E — ELECTRIC CABLES
- A — A — AERIAL CABLES

NOTE:

1. THIS IS A REVISION TO THE TRAFFIC SIGNAL INSTALLED IN 4/77 UNDER CONTRACT NUMBER WI-538-451-185.

REVISIONS	
(E)	ASBUILT 1-09-90
(E)	CHANGED PED. LENSES, MAINLINE SIGNALS, RELOCATE P-BUTTONS.
(A)	8/88
(A)	REVISED DETECTION DUE TO GEOMETRIC IMPROVEMENTS
(C)	5-09-84
(C)	REDRAWN, REVISED DETECTION & SIDE ROAD SIGNALS & COORDINATED S.H.A. NO. W-633-502-185
(B)	7-78-81
(B)	ADDED PED SIGNALS & NEW CONTROLLER AW-528-452-185
(WJR)	DAZ ETP TH
(A)	8-30-77
(A)	ASBUILT
(A)	W-538-451-185
(GBH)	BT AB

APPROVALS		
CHIEF, SIGNAL DESIGN SECTION		
ASST. DISTRICT ENGINEER, TRAFFIC		
CHIEF, BUREAU OF TRAFFIC ENGINEERING		
DEPUTY CHIEF ENGINEER, OFFICE OF TRAFFIC ENGINEERING		

MARYLAND DEPARTMENT OF TRANSPORTATION
STATE HIGHWAY ADMINISTRATION - OFFICE OF TRAFFIC
BUREAU OF TRAFFIC ENGINEERING

DRAWN BY: H.L.S. M.E.M.
DES. BY: B. THOMPSON
CHK. BY: A. BUDNICHUK 3-24-77

DATE: REDRAWN 8/88
SCALE: 1"=20'

F.A.P. NO. _____
S.H.A. NO. W-538-451-185

US 13 & BATEMAN AVE.

COUNTY: WICOMICO
TS/FILE NO. TS-1498 E
SHEET NO. _____ OF _____

22801303.87