
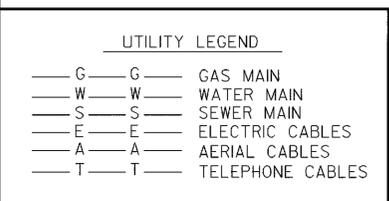


- CONSTRUCTION DETAILS**
- (A) INSTALL NEMA SIZE 6 BASE MOUNTED CONTROLLER AND CABINET WITH INTERSECTION MONITOR, PHONE DROP AND ALL NECESSARY EQUIPMENT.
 - (B) INSTALL 12 IN. x 21 FT. STEEL POLE WITH 38 FT. MAST ARM, SIGNAL HEADS, SIGN AND OPTICOM DETECTOR EYE (NOTE: ONE 3 IN. SCHEDULE 80, 90 DEGREE PVC CONDUIT BEND, 4-2" x 90" ANCHOR BOLTS).
 - (C) INSTALL 12 IN. x 21 FT. STEEL POLE WITH 70 FT. MAST ARM, SIGNAL HEADS, SIGNS (NOTE: ONE 3 IN. SCHEDULE 80, 90 DEGREE PVC CONDUIT BEND, 4-2" x 90" ANCHOR BOLTS).
 - (D) INSTALL NEW SIGNAL HEAD AND WIRING TO EXISTING MAST ARM.
 - (E) INSTALL 12 IN. x 21 FT. STEEL POLE WITH 50 FT. MAST ARM SIGNAL HEADS, SIGNS (NOTE: ONE 3 IN. SCHEDULE 80, 90 DEGREE PVC CONDUIT BEND, 4-2" x 90" ANCHOR BOLTS).
 - (F) INSTALL 6 FT. x 30 FT. LOOP DETECTOR IN 1/2 IN. FLEXIBLE TUBING (3-6-3 TURNS).
 - (G) INSTALL 1 INCH LIQUID TIGHT FLEXIBLE NON-METALLIC CONDUIT FOR DETECTOR SLEEVE.
 - (H) INSTALL 24 INCH WHITE PREFORMED HEAT APPLIED THERMOPLASTIC PAVEMENT MARKING (STOP LINE).
 - (I) EXISTING ELECTRICAL HAND HOLE TO REMAIN.
 - (J) ABANDON EXISTING LOOP WIRE.
 - (K) CAP AND ABANDON EXISTING CONDUIT.
 - (L) ABANDON EXISTING HANDHOLE.
 - (M) UNDERGROUND POWER FEED.
 - (N) INSTALL NEW WIRING IN EXISTING CONDUIT.
 - (O) INSTALL 1 INCH GALVANIZED CONDUIT FOR DETECTOR SLEEVE.
 - (P) INSTALL 4 INCH DIA. PVC CONDUIT SCHEDULE 80 - TRENCHED.
 - (Q) INSTALL 6 FT. x 6 FT. LOOP DETECTOR IN 1/2 IN. FLEXIBLE TUBING (4 TURNS).
 - (R) REMOVE EXISTING GROUND MOUNT SIGN.
 - (S) REMOVE EXISTING CONTROLLER AND CABINET (TO BE DONE LAST).
 - (T) REMOVE EXISTING STRAIN POLE, MAST ARM, SIGNAL HEADS, SIGNS AND WIRING (TO BE DONE LAST).
 - (U) REMOVE AND RELOCATE ROADWAY LIGHTING STRUCTURE.
 - (V) INSTALL 2 INCH DIA. PVC ELECTRICAL CONDUIT SCHEDULE 80 - TRENCHED.
 - (W) INSTALL 4 INCH DIA. PVC ELECTRICAL CONDUIT SCHEDULE 80 - SLOTTED.
 - (X) INSTALL 3 INCH DIA. PVC ELECTRICAL CONDUIT SCHEDULE 80 - TRENCHED.
 - (Y) REMOVE EXISTING SIGNAL HEADS AND SIGNS ON EXISTING SIGNAL STRUCTURE.
 - (Z) INSTALL GROUND MOUNT SIGN.
 - (AA) REMOVE EXISTING PAVEMENT MARKING (STOP LINE).
 - (BB) EXISTING SIGNAL STRUCTURE TO REMAIN.
 - (CC) INSTALL ELECTRICAL HAND HOLE.
 - (DD) INSTALL NEW SIGNAL HEAD ON EXISTING MAST ARM.
 - (EE) INSTALL 5 INCH SOLID WHITE THERMOPLASTIC PAVEMENT MARKING.
 - (FF) INSTALL PREFORMED HEAT APPLIED THERMOPLASTIC PAVEMENT MARKING (ARROW).
 - (GG) INSTALL 3 INCH DIA. PVC ELECTRICAL CONDUIT SCHEDULE 80 - SLOTTED.

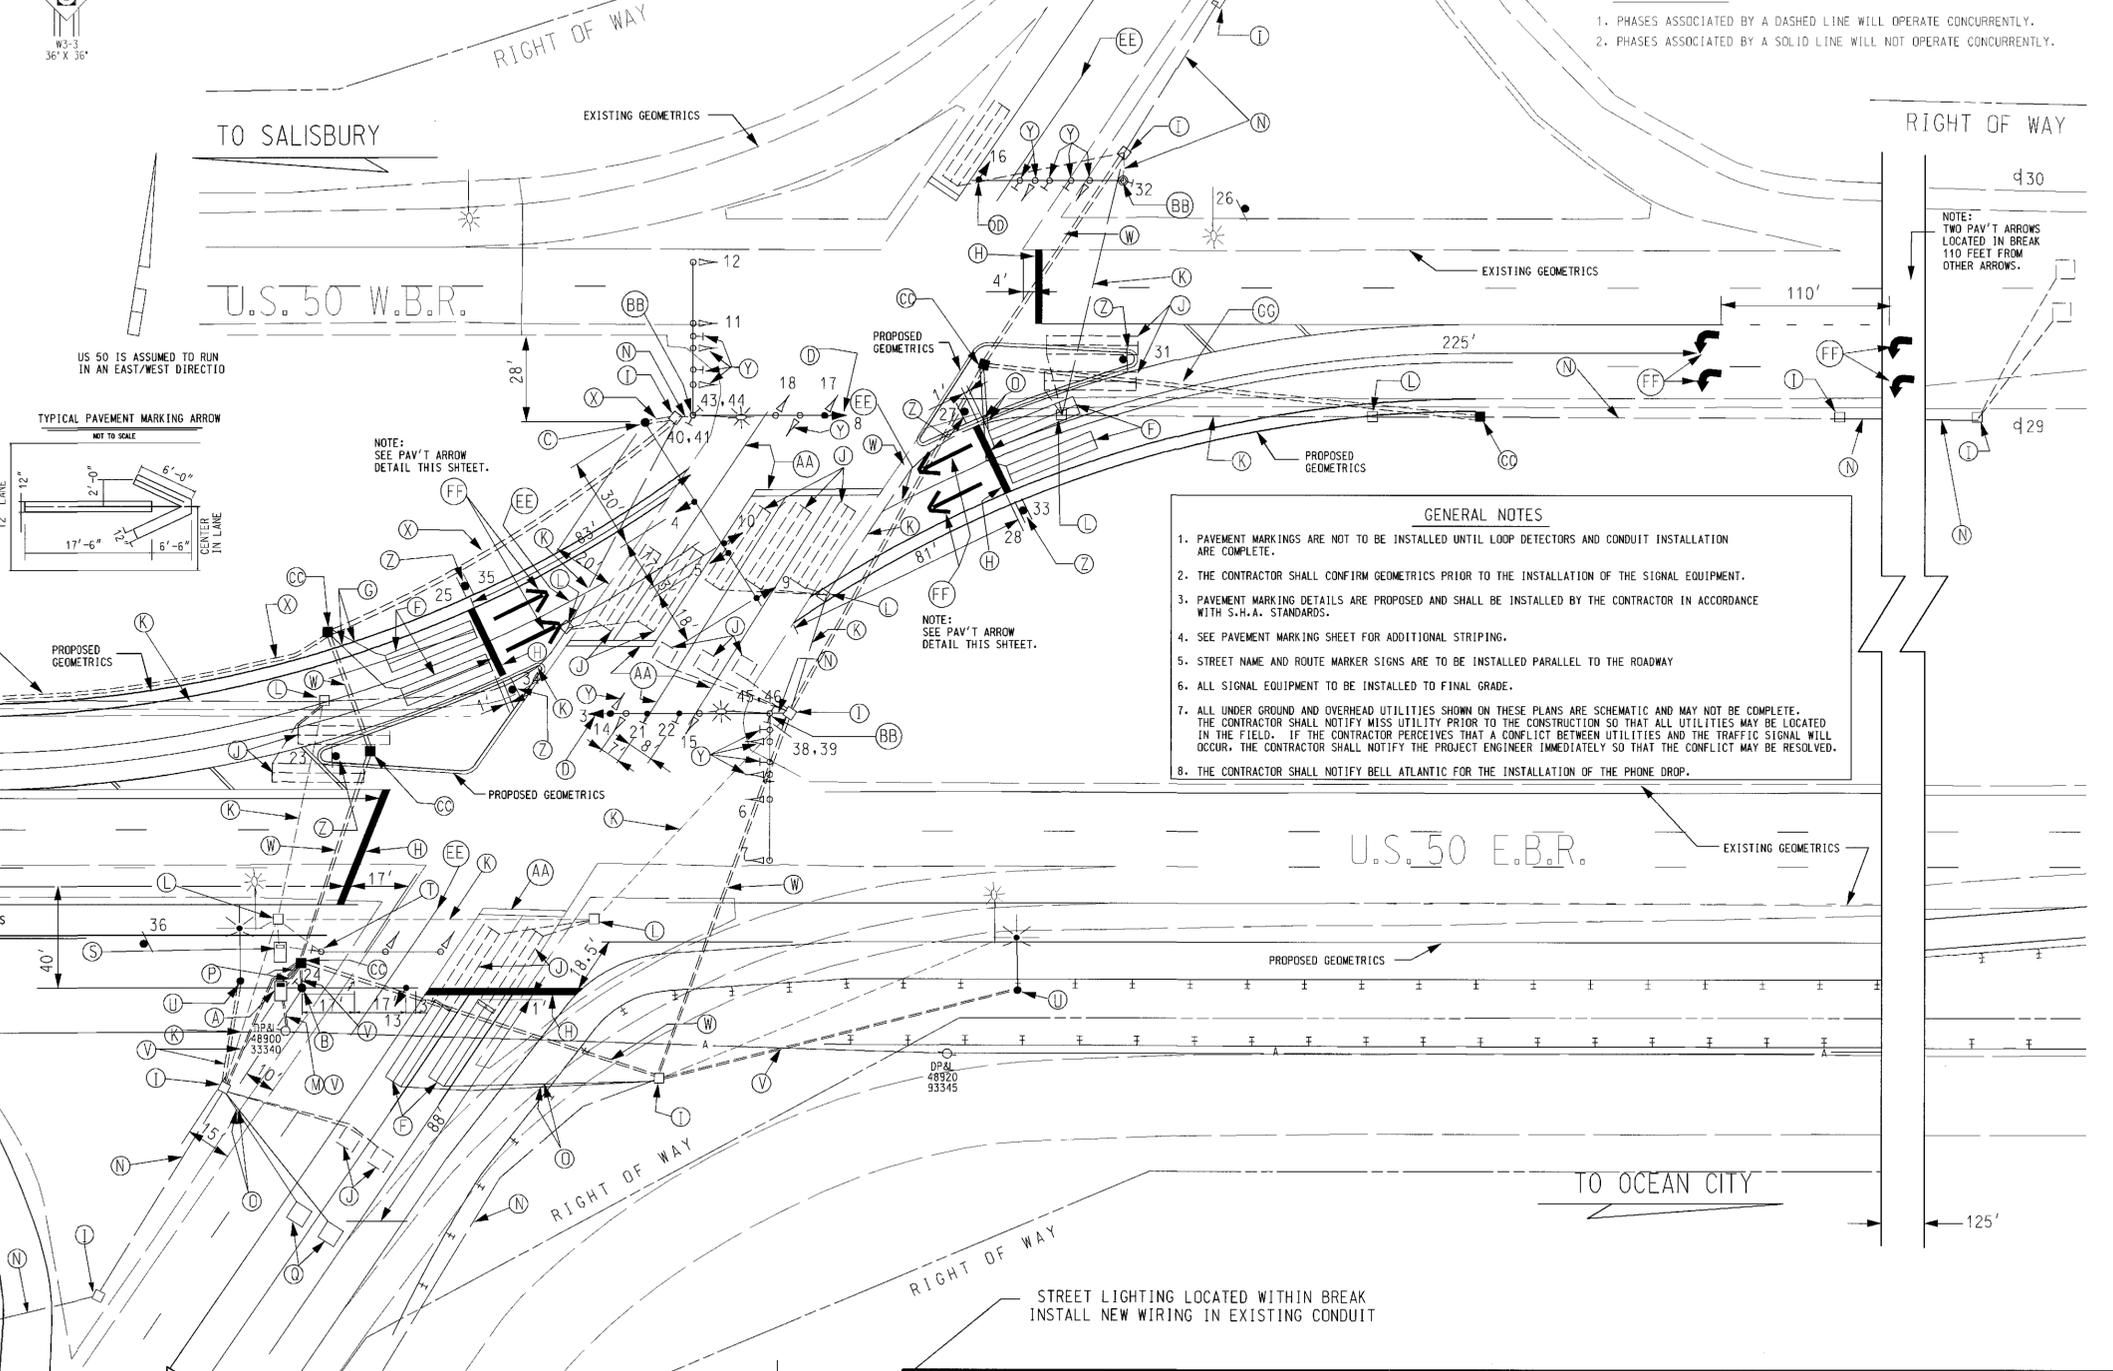

REVISIONS		APPROVALS	
1	REDLINE NO. 1 NEW SHEET ADDED	C/2/01	
2	RELOCATE EQUIPMENT FOR US 50 WIDENING	4-20-01	TEAM LEADER, TRAFFIC ENGINEERING DESIGN DIVISION
3	ADD CONCURRENT SIDE STREET WITH NB LAG	6-15-00	ASST. CHIEF TRAFFIC ENGINEERING DESIGN DIVISION
4	ADD LOOP DETECTORS IN NB AND SB MEDIAN LANES	6-15-00	CHIEF, TRAFFIC ENGINEERING DESIGN DIVISION
5	AS BUILT	6-10-96	DIRECTOR, TRAFFIC & SAFETY

MARYLAND DOT - STATE HIGHWAY ADMINISTRATION
Office of Traffic & Safety
TRAFFIC ENGINEERING DESIGN DIVISION

U.S. 50 AND HOBBS ROAD

REDRAWN BY: C. G. MUNIZ (FOR JMT)	F.A.P. NO.	TS NO.	SHEET NO.
CHECKED BY: M. L. WOLNIAR (FOR JMT)	S.H.A. NO.	TS-3586 (C)	70A of 135
SCALE: 1" = 30'	COUNTY: WICOMICO	T.I.M.S. NO.	
DATE: 06-30-00	LOG MILE: 22005019.99	0036	