



F H WA REGION NO	STATE	FED. AID PROJ. NO	SHEET NO.	TOTAL SHEETS
3	MD.			

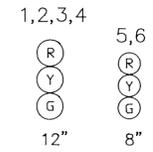


SIGNALS



NEMA PHASING

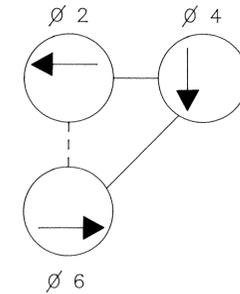


FLASHING OPERATION

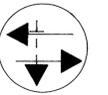


NOTE :

1. PHASES ASSOCIATED WITH DASHED LINES WILL OPERATE CONCURRENTLY.
2. PHASES ASSOCIATED WITH SOLID LINES WILL NOT OPERATE CONCURRENTLY.

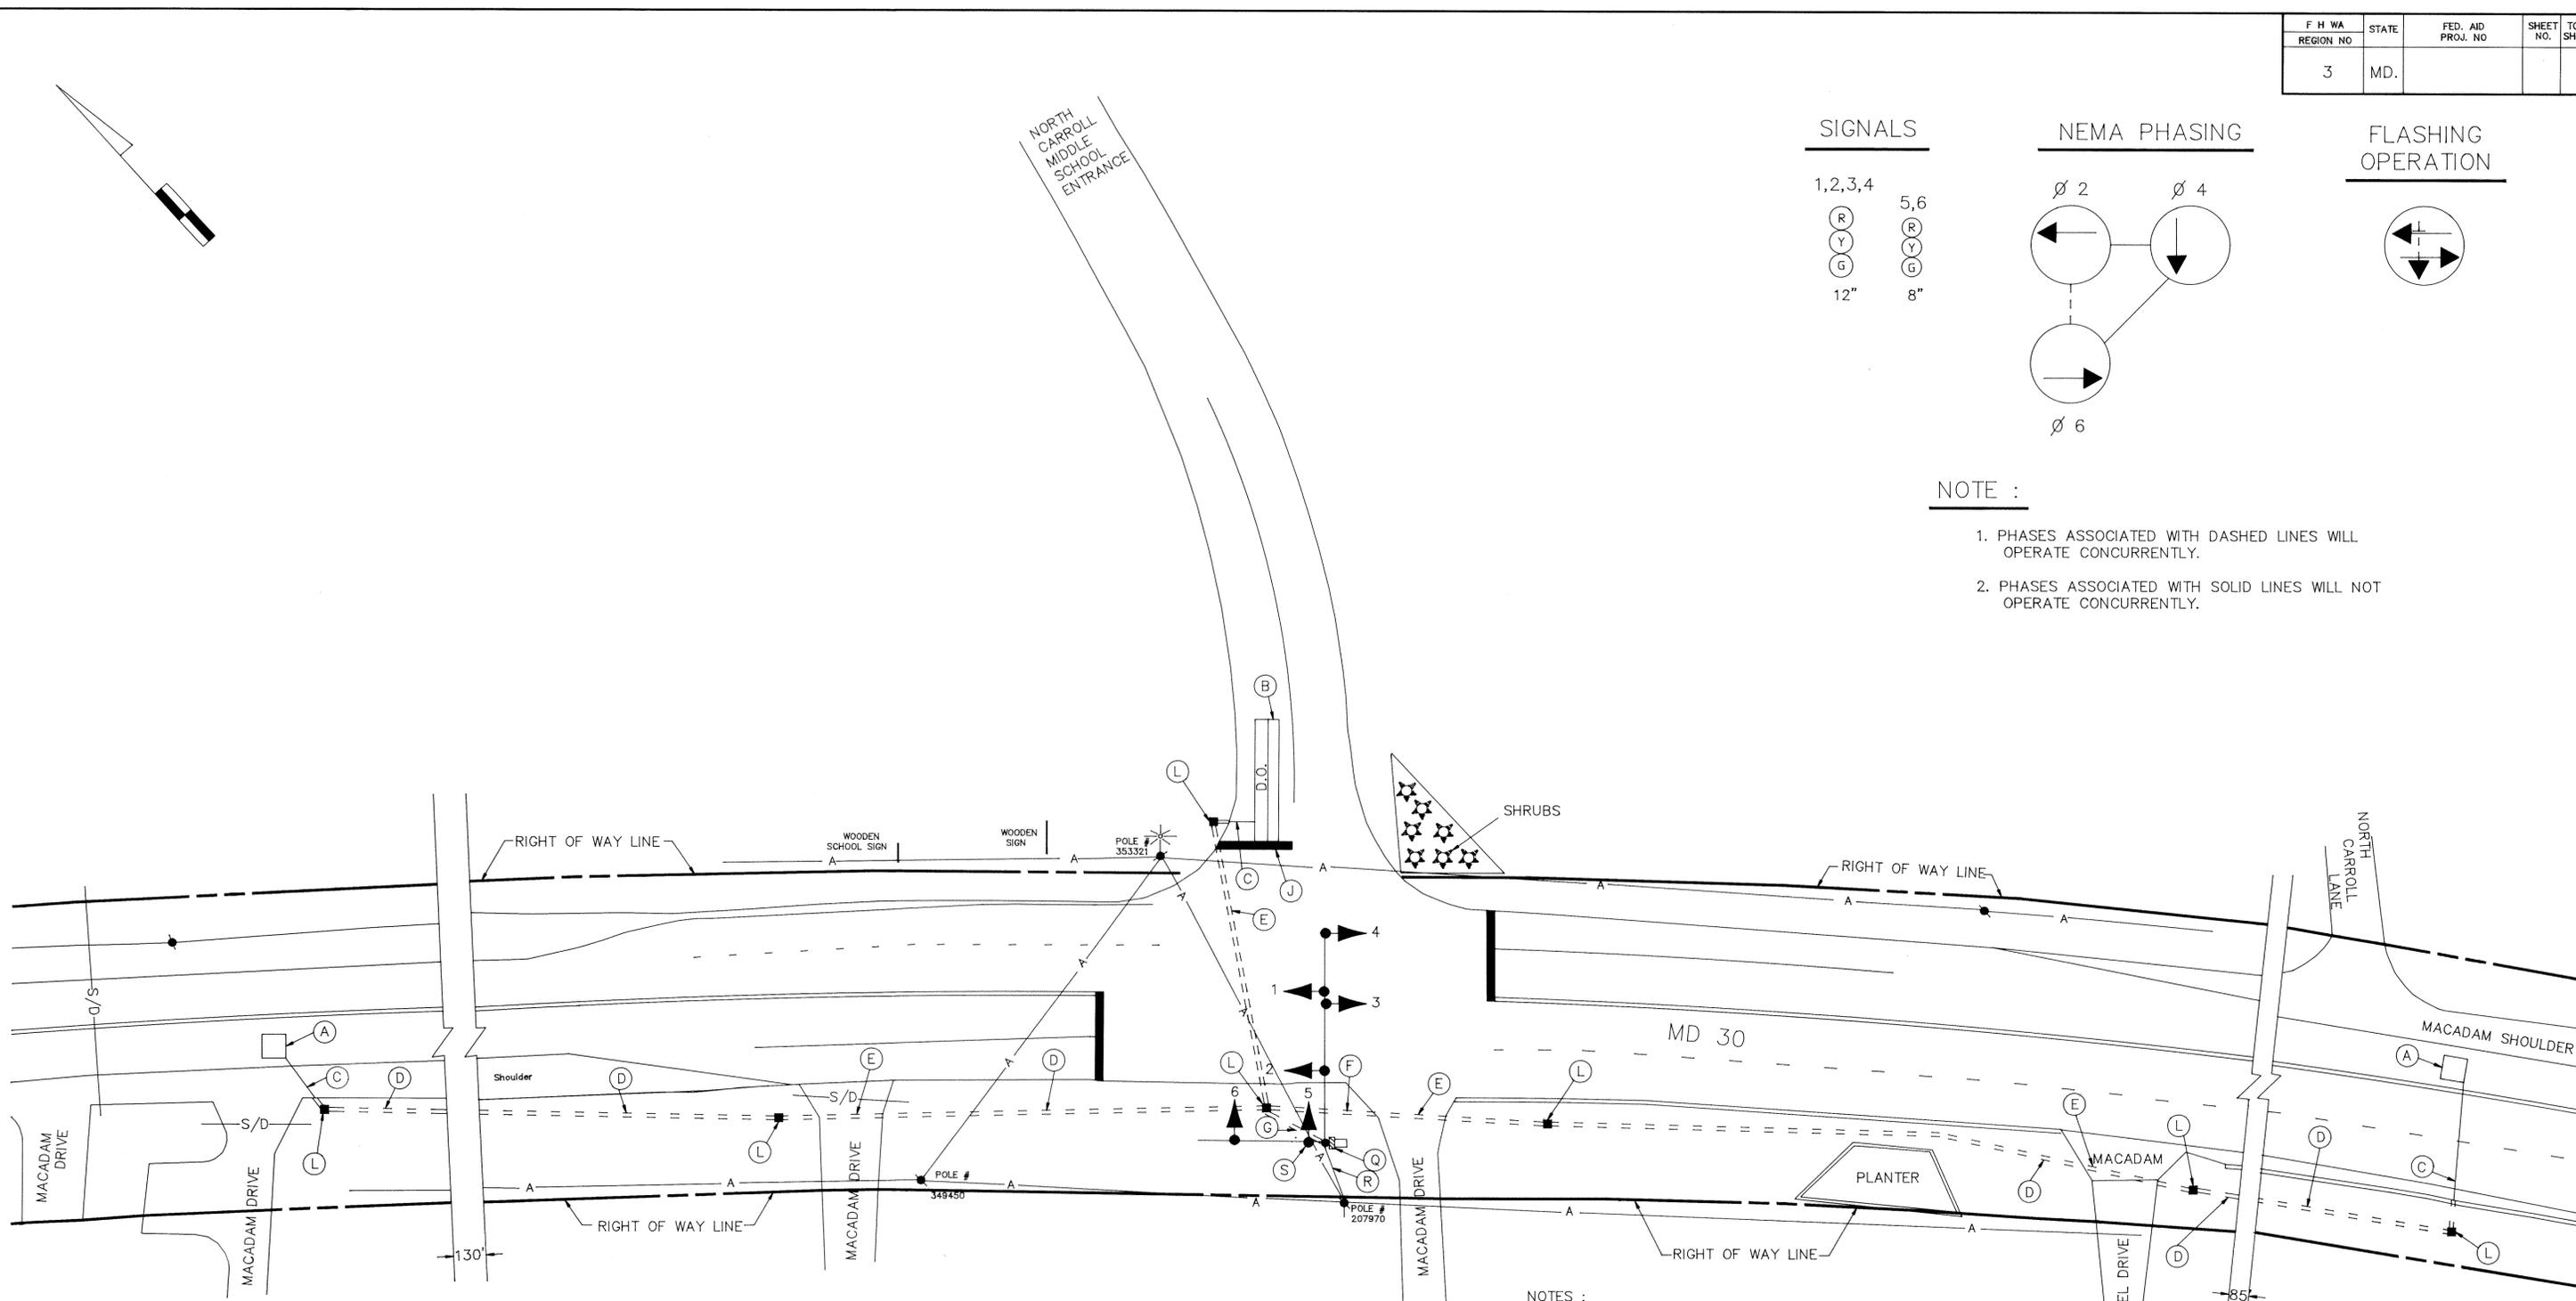

NOTES :

1. "D. O." INDICATES A DELAY-OUTPUT LOOP DETECTOR.
2. ALL UTILITY LOCATIONS SHOWN ON THIS PLAN ARE APPROXIMATE. EXACT LOCATIONS WILL HAVE TO BE CONFIRMED THRU "MISS UTILITY" (1-800-257-7777) BY THE CONTRACTOR.
3. SCALE 1" = 20'

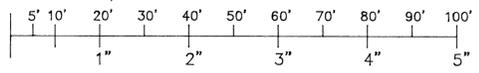

UTILITY LEGEND

- G — G — GAS MAIN
- W — W — WATER MAIN
- S — S — SEWER MAIN
- E — E — ELECTRIC CABLES
- A — A — AERIAL CABLES
- T — T — TELEPHONE CABLES
- S/D — S/D — STORM DRAIN

REVISIONS	APPROVALS
(A) ASBUILT 10/26/90	CHIEF, SIGNAL DESIGN SECTION
LMG [Signature]	ASST. DISTRICT ENGINEER, TRAFFIC
	CHIEF, TRAFFIC ENGINEERING DIVISION
	DEPUTY CHIEF ENGINEER, OFFICE OF TRAFFIC

MDOT — STATE HIGHWAY ADMINISTRATION
Office of Traffic
TRAFFIC ENGINEERING DIVISION SIGNAL # 06003004.75

MD 30 at
NORTH CARROLL MIDDLE SCHOOL
ACAD COUNTY: CARROLL

DRAWN BY: JOHN H. GREEZICKI OF CENTURY ENGINEERING, INC.
DES. BY: REBECCA S. CHRISTMAN OF CENTURY ENGINEERING, INC.
CHK. BY: DENNIS J. DODA, 4/8/88

DATE: 9/25/87 F.A.P. NO. N/A TS/STD. NO. 2383 A SHEET NO. 2 OF 2
SCALE: 1" = 20' S.H.A. NO. OT - 7 - 88

06003004.75