



F.H.W.A. REGION NO.	STATE	FED. AID PROJ. NO.	SHEET NO.	TOTAL SHEETS
3	MD.			

- CONSTRUCTION DETAILS:**
- INSTALL THE PROPOSED SIGNAL HEAD. REMOVE THE EXISTING SIGNAL HEAD.
 - INSTALL THE PROPOSED SIGN ON THE EXISTING SPAN WIRE.
 - INSTALL THE PROPOSED SIGN ON THE EXISTING SIGNAL POLE.
 - USE THE EXISTING SPAN WIRE.
 - INSTALL THE PROPOSED 12" WHITE HEAT APPLIED PERMANENT PREFORMED PAVEMENT MARKINGS. REMOVE THE EXISTING PAVEMENT MARKINGS.
 - INSTALL THE PROPOSED 24" WHITE HEAT APPLIED PERMANENT PREFORMED PAVEMENT MARKINGS. REMOVE THE EXISTING PAVEMENT MARKINGS.

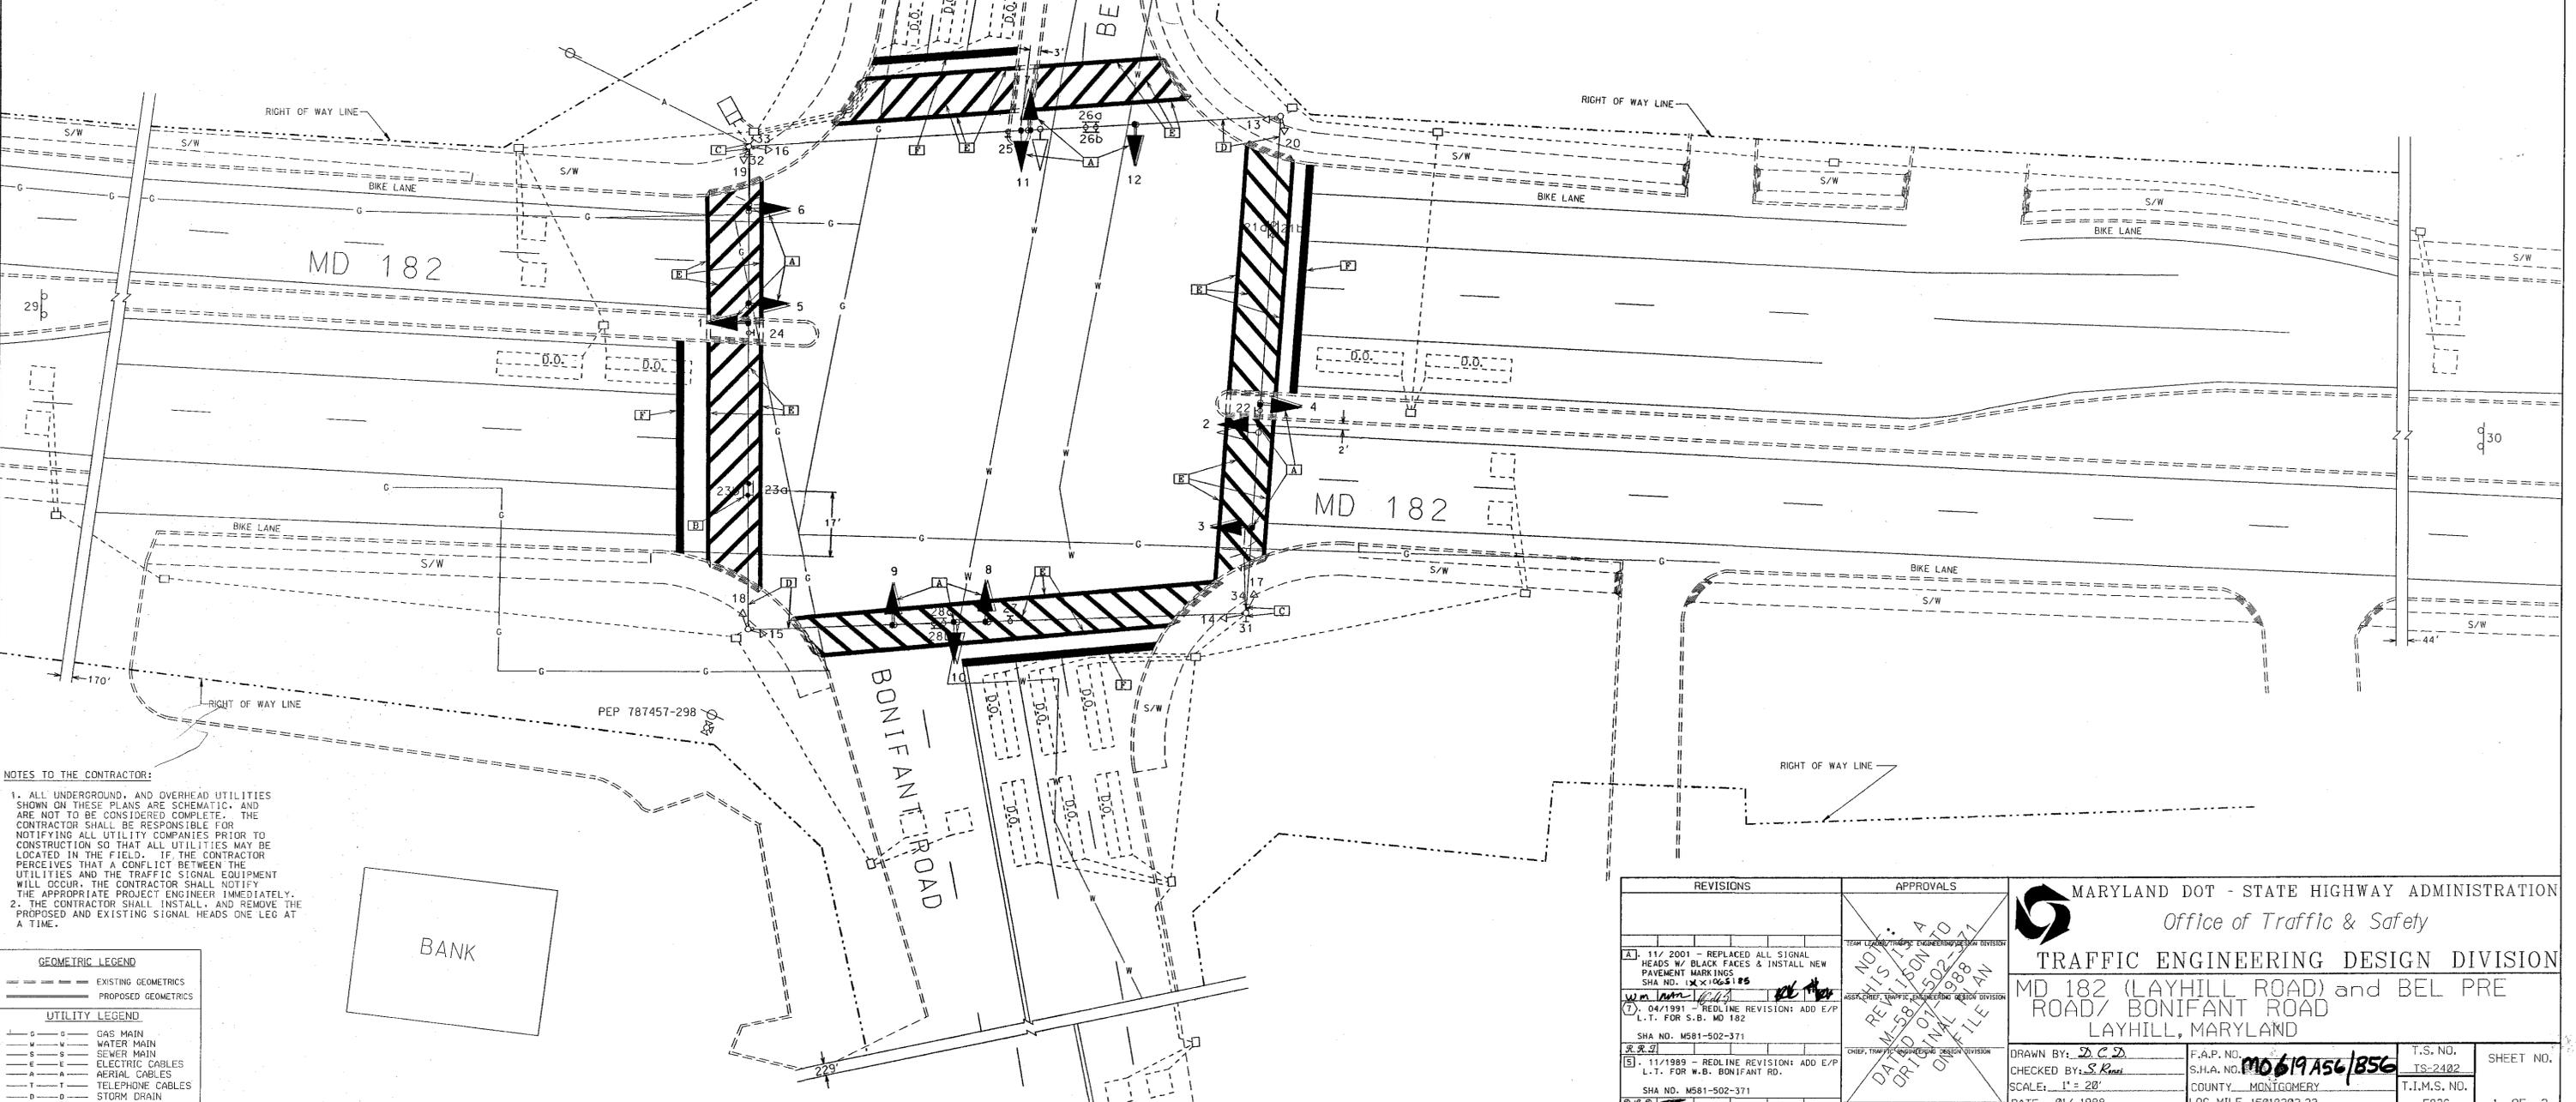

- NOTES TO THE CONTRACTOR:**
- ALL UNDERGROUND, AND OVERHEAD UTILITIES SHOWN ON THESE PLANS ARE SCHEMATIC, AND ARE NOT TO BE CONSIDERED COMPLETE. THE CONTRACTOR SHALL BE RESPONSIBLE FOR NOTIFYING ALL UTILITY COMPANIES PRIOR TO CONSTRUCTION SO THAT ALL UTILITIES MAY BE LOCATED IN THE FIELD. IF THE CONTRACTOR PERCEIVES THAT A CONFLICT BETWEEN THE UTILITIES AND THE TRAFFIC SIGNAL EQUIPMENT WILL OCCUR, THE CONTRACTOR SHALL NOTIFY THE APPROPRIATE PROJECT ENGINEER IMMEDIATELY.
 - THE CONTRACTOR SHALL INSTALL, AND REMOVE THE PROPOSED AND EXISTING SIGNAL HEADS ONE LEG AT A TIME.

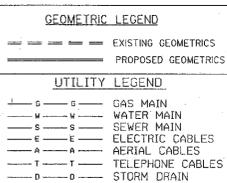

REVISIONS	APPROVALS
<p>A. 11/2001 - REPLACED ALL SIGNAL HEADS W/ BLACK FACES & INSTALL NEW PAVEMENT MARKINGS</p> <p>SHA NO. 13X1065185</p> <p>W.M. [Signature]</p> <p>7. 04/1991 - REDLINE REVISION: ADD E/P L.T. FOR S.B. MD 182</p> <p>SHA NO. M581-502-371</p> <p>5. 11/1989 - REDLINE REVISION: ADD E/P L.T. FOR W.B. BONIFANT RD.</p> <p>SHA NO. M581-502-371</p>	<p>TEAM LEADER/DESIGNER: ENGINEERING DESIGN DIVISION</p> <p>NO. 11/2001</p> <p>REVISED TO</p> <p>M-581-502-371</p> <p>DATE: 01/1988</p> <p>CRITICAL PLAN</p> <p>CHIEF, TRAFFIC ENGINEERING DESIGN DIVISION</p> <p>DIRECTOR, OFFICE OF TRAFFIC & SAFETY</p>

MARYLAND DOT - STATE HIGHWAY ADMINISTRATION

Office of Traffic & Safety

TRAFFIC ENGINEERING DESIGN DIVISION

MD 182 (LAYHILL ROAD) and BEL PRE ROAD/BONIFANT ROAD

LAYHILL, MARYLAND

DRAWN BY: [Signature]

CHECKED BY: [Signature]

SCALE: 1" = 20'

DATE: 01/1988

F.A.P. NO. [Blank]

S.H.A. NO. MD 619A56/B56

COUNTY: MONTGOMERY

LOG MILE: 15018202.23

T.S. NO. TS-2402

T.I.M.S. NO. E836

SHEET NO. 1 OF 2