
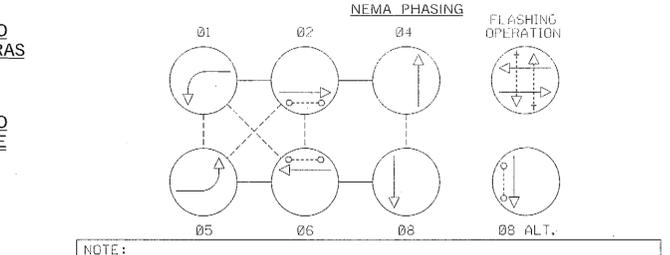
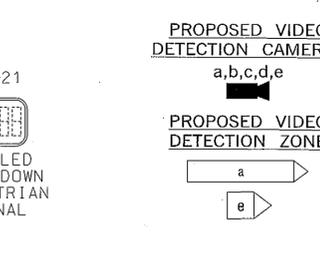
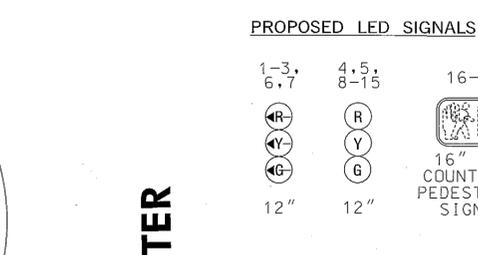
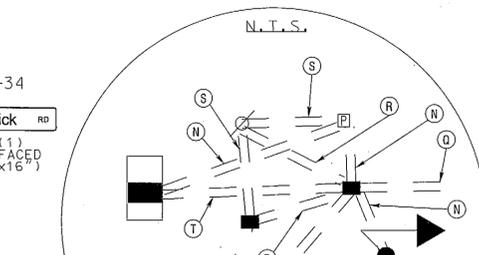
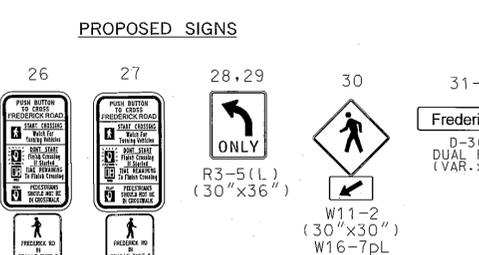


BY: waeschel

DATE: June 1, 2004

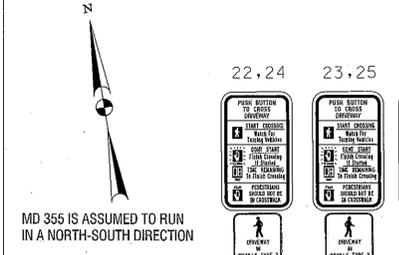

PARSONS BRINCKERHOFF

100 S. Charles Street
Tower 1, 10th Floor
Baltimore, MD 21201
(Ph) 410-787-5050
(Fax) 410-727-4608
http://www.pbworld.com

UTILITY LEGEND

- SD - STORM DRAIN
- G - GAS MAIN
- W - WATER MAIN
- S - SEWER MAIN
- E - ELECTRIC CABLES
- A - AERIAL CABLES
- T - TELEPHONE CABLES
- F - FIBER-OPTIC

APPROVALS

TEAM LEADER: [Signature]

ASSIST. DIV. CHIEF: [Signature]

DIVISION CHIEF: [Signature]

OFFICE DIRECTOR: [Signature]

REVISIONS

NO.	DATE	DESCRIPTION
1	03/22/03	TRAFFIC SIGNAL RECONSTRUCTION
2	03/22/03	AS BUILT & SIGNAL REVISION
3	03/22/03	AS BUILT & SIGNAL REVISION

STATE OF MARYLAND

DEPARTMENT OF TRANSPORTATION

STATE HIGHWAY ADMINISTRATION

OFFICE OF TRAFFIC & SAFETY
TRAFFIC ENGINEERING DESIGN DIVISION

MD 355 AT LOCKHEED MARTIN ENTRANCE

GAITHERSBURG, MD

SIGNALIZATION PLAN SHEET

SCALE 1" = 20' DATE OCTOBER 10, 1989 CONTRACT NO. M-733-003-374

DESIGNED BY: [Name] COUNTY: MONTGOMERY

DRAWN BY: [Name] LOGMILE: 15035515.57

CHECKED BY: [Name] TMS NO.:

F.A.P. NO. [Name] TMS NO.:

TS NO. 47C DRAWING 5G-01 OF 03 SHEET NO. 01 OF 03

PLOTTED: Friday, March 22, 2013 AT 02:46 PM
FILE: T:\17324A-TrafficDesign\Services\TRF\112\Plans\5G-P001_L178_Lockheed.dgn