


BORDER REV. DATE: JUNE 11, 2004


DRILL HOLES

DRILL HOLES

DRILL HOLES

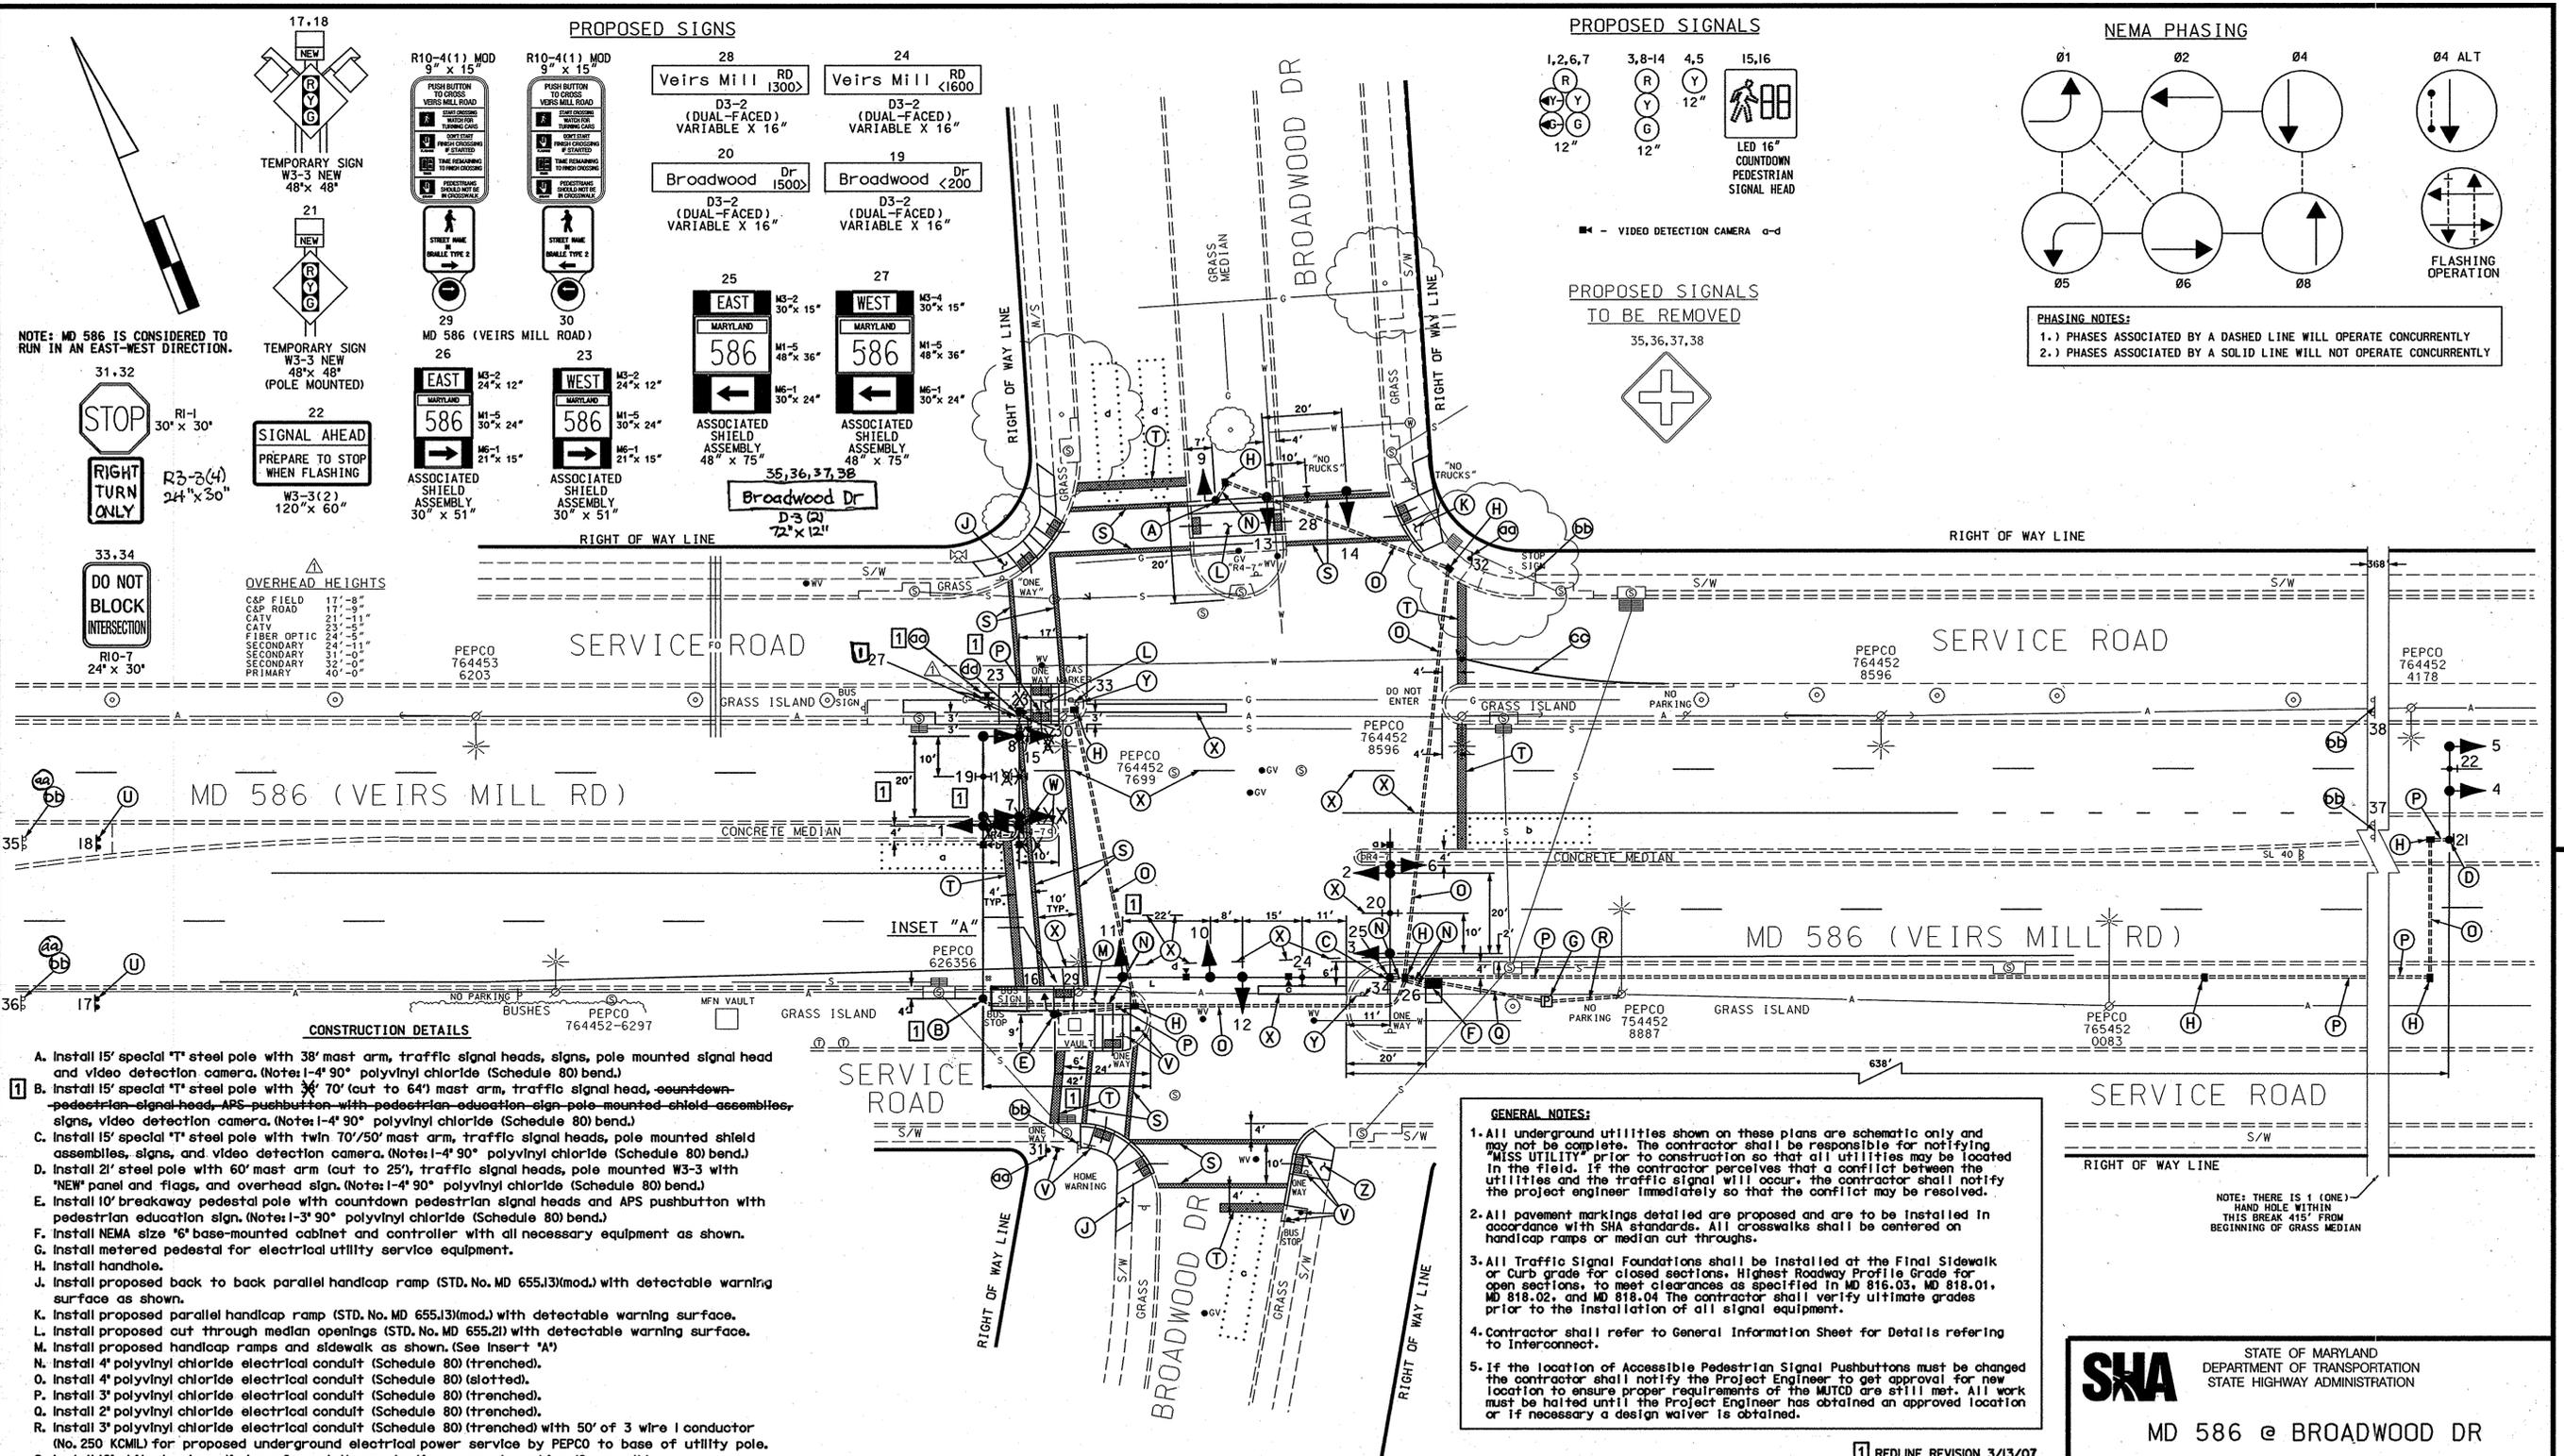

- GENERAL NOTES:**
- All underground utilities shown on these plans are schematic only and may not be complete. The contractor shall be responsible for notifying "MISS UTILITY" prior to construction so that all utilities may be located in the field. If the contractor perceives that a conflict between the utilities and the traffic signal will occur, the contractor shall notify the project engineer immediately so that the conflict may be resolved.
 - All pavement markings detailed are proposed and are to be installed in accordance with SHA standards. All crosswalks shall be centered on handicap ramps or median cut throughs.
 - All Traffic Signal Foundations shall be installed at the Final Sidewalk or Curb grade for closed sections. Highest Roadway Profile Grade for open sections, to meet clearances as specified in MD 816.03, MD 818.01, MD 818.02, and MD 818.04. The contractor shall verify ultimate grades prior to the installation of all signal equipment.
 - Contractor shall refer to General Information Sheet for Details referring to Interconnect.
 - If the location of Accessible Pedestrian Signal Pushbuttons must be changed the contractor shall notify the Project Engineer to get approval for new location to ensure proper requirements of the MUTCD are still met. All work must be halted until the Project Engineer has obtained an approved location or if necessary a design waiver is obtained.

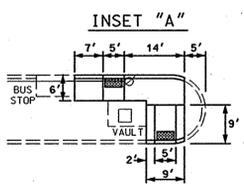

GEOMETRIC LEGEND

PROPOSED
EXISTING

LEGEND OF UNDERGROUND AND OVERHEAD UTILITIES

AERIAL CABLE	—A—A—
ELECTRIC	—E—E—
TELEPHONE	—T—T—
GAS	—G—G—
SEWER	—S—S—
WATER	—W—W—
CABLE TV	—TV—TV—

ST
STREET TRAFFIC STUDIES, LTD.
400 Crain Hwy. N.
Glen Burnie, MD 21061
Ph (410) 590-5500
Fax (410) 590-6637

5075.dgn T-40

APPROVALS	REVISIONS
TEAM LEADER	
ASST. DIV. CHIEF	
DIVISION CHIEF	
OFFICE DIRECTOR	

1 REDLINE REVISION 3/13/07
TEDD APPROVAL

SHA STATE OF MARYLAND
DEPARTMENT OF TRANSPORTATION
STATE HIGHWAY ADMINISTRATION

MD 586 @ BROADWOOD DR
ROCKVILLE, MARYLAND

TRAFFIC SIGNAL

SCALE 1" = 20' DATE 11-20-06 CONTRACT NO. AT9105185

DESIGNED BY JAMES ALLEN JR. COUNTY MONTGOMERY
DRAWN BY D.A. NIES LOGMILE 15058600.79
CHECKED BY TIMS NO. H772
F.A.P. NO. AC-NHG-STP6-000A(176)E TOD NO.

TS NO. 4510 DRAWING NO. 1 OF 3 SHEET NO. OF

15000-15058600.79-06 3/13/2007 8:35:12 AM