
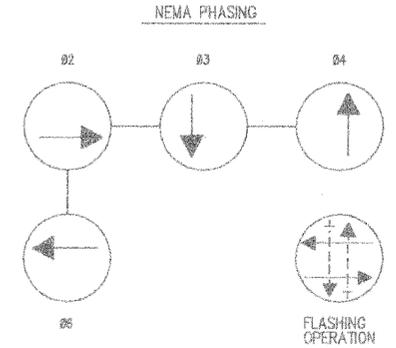
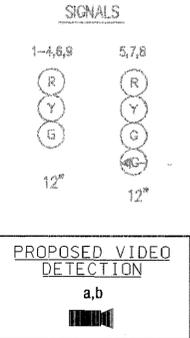
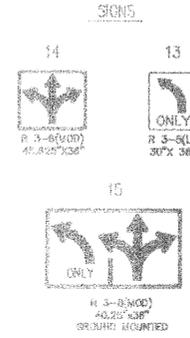


F H WA REGION NO	STATE	FED. AID PROJ. NO	SHEET NO.	TOTAL SHEETS
3	MD.			

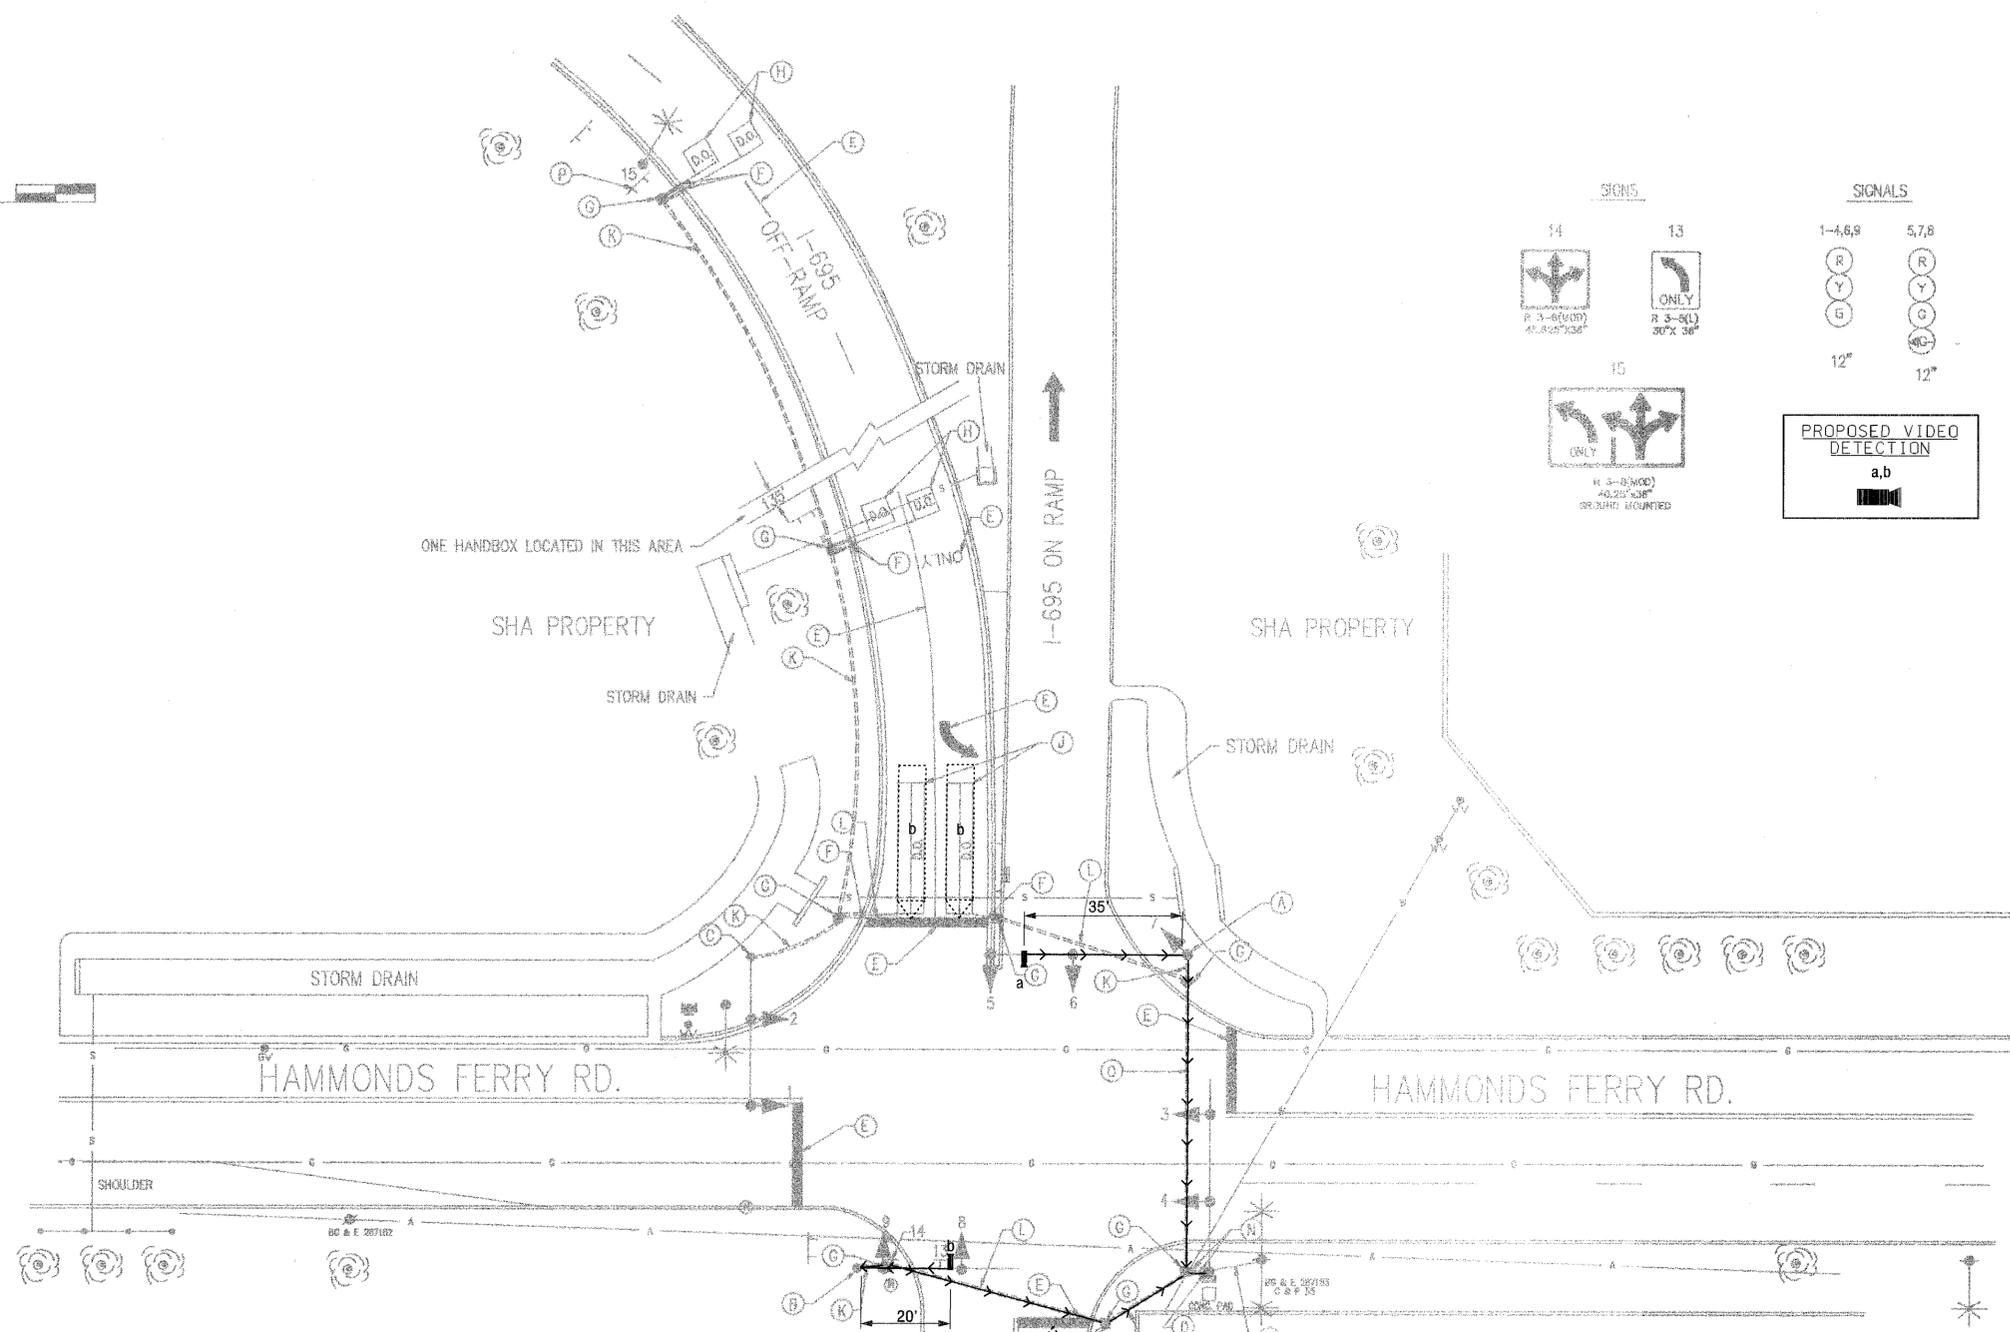


PHASING NOTES

1. Phases associated by a solid line will not operate concurrently.
2. Phases associated by a dashed line will operate concurrently.

- GENERAL NOTES**
1. VIDEO CAMERA LOCATION / ALIGNING SHALL BE COORDINATED WITH THE SHA ENGINEER.
 2. THE CONTRACTOR SHALL CONTACT SHA TO SCHEDULE RETROFITTING OF THE CONTROLLER EQUIPMENT IN ORDER TO OPERATE VIDEO DETECTION EQUIPMENT.
 3. THE CONTRACTOR SHALL BE RESPONSIBLE FOR TERMINATING ALL VIDEO DETECTION CAMERA CABLES TO THE APPROPRIATE TERMINALS AND PROPERLY LABEL EACH CABLE SO THAT SHA FORCES CAN MAKE THE FINAL CONNECTIONS.
 4. THE INSTALLATION OF PROPOSED VIDEO DETECTION EQUIPMENT SHALL NECESSITATE THE REMOVAL OF EXISTING CABLES ASSOCIATED WITH THE PRESENCE LOOP DETECTORS BEING REPLACED BY VIDEO DETECTION.
 5. ALL EXISTING TRAFFIC SIGNAL EQUIPMENT REMOVED SHALL BECOME THE PROPERTY OF THE SIGNAL CONTRACTOR UPON COMPLETION OF THE SIGNAL MODIFICATIONS.
 6. ALL UNUSED SIGNAL CABLES SHALL BE REMOVED AND DISPOSED.

B. EQUIPMENT TO BE FURNISHED AND/OR INSTALLED BY THE CONTRACTOR.			
ITEM NO.	DESCRIPTION	UNITS	QUANTITY
8019	VIDEO DETECTION CAMERA	EA	2
8020	CONTROL CABLE, 250 FOOT VIDEO DETECTION CAMERA TO CONTROLLER	EA	2

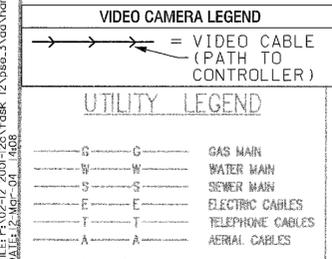

REVISIONS

(A)	12-10-90	AS-BUILT
-----	----------	----------

APPROVALS

INSTALL VIDEO DETECTION
SHA No. AT308185
3/15/04

ORIGINAL ON FILE

SHA #: A0348A5/BS4 TCD #: AT308-08

MDOT - STATE HIGHWAY ADMINISTRATION
Office of Traffic
TRAFFIC ENGINEERING DIVISION

SIGNAL # 02069502.74

DRAWN BY: TEKIE MESKEL
DES. BY: TEKIE MESKEL
CHK. BY: D. DODA

DATE: 06/90 F.A.P. NO. _____
SCALE: 1" = 20' S.H.A. NO. _____

HAMMONDS FERRY ROAD & I-695 OFF-RAMP
COUNTY: ANNE ARUNDEL

TS/STD. NO. 2645 X B SHEET NO. 1 OF 1

FILE: V:\02-12-2001-024 Task: P:\user_3\voa\hammonds695r-amp.dgn DATE: 12-10-90 14:08

02069502.74