

DRILL HOLES

DRILL HOLES

DRILL HOLES

ARUNDEL MILLS CIRCLE IS ASSUMED TO RUN IN AN EAST-WEST DIRECTION

MATCH LINE SEE ARUNDEL MILLS CIRCLE AND WAL MART

- CONSTRUCTION DETAILS**
- INSTALL 27 FT. MAST ARM POLE WITH A 70 FT. MAST ARM, SIGNAL HEADS, SIGNS, PEDESTRIAN SIGNAL, PUSHBUTTON-SIGN, VIDEO DETECTION CAMERAS, AND 15 FT. STREET LIGHTING ARM WITH 250 WATT HPSV LUMINAIRE (NOTE: INSTALL 2-3 IN. SCHEDULE 80, 90 DEGREE CONDUIT BENDS)
  - INSTALL 27 FT. MAST ARM POLE WITH A 90 FT. MAST ARM, SIGNAL HEADS, SIGNS, PEDESTRIAN PUSHBUTTON, SIGNAL HEAD AND SIGN (NOTE: INSTALL 2-3 IN. SCHEDULE 80, 90 DEGREE CONDUIT BENDS)
  - USE EXISTING BASE MOUNTED CABINET AND CONTROLLER. INSTALL TWO VIDEO INTERFACE UNITS
  - INSTALL ELECTRICAL HANDHOLE
  - INSTALL 1 IN. GALVANIZED STEEL CONDUIT - DETECTOR SLEEVE
  - INSTALL 3 IN. SCHEDULE 80 RIGID PVC ELECTRICAL CONDUIT - TRENCHED
  - INSTALL 4 IN. SCHEDULE 80 RIGID PVC ELECTRICAL CONDUIT - BORED
  - INSTALL 4 IN. SCHEDULE 80 RIGID PVC ELECTRICAL CONDUIT - TRENCHED
  - INSTALL 5 IN. SKIP WHITE HEAT APPLIED PERMANENT PREFORMED THERMOPLASTIC PAVEMENT MARKING LINE (10 FT. LINE - 30 FT. GAP)
  - INSTALL MICRO-LOOP PROBE
  - INSTALL 5 IN. SOLID WHITE HEAT APPLIED PERMANENT PREFORMED THERMOPLASTIC PAVEMENT MARKING LINE
  - INSTALL 5 IN. SKIP WHITE HEAT APPLIED PERMANENT PREFORMED THERMOPLASTIC PAVEMENT MARKING LINE (3 FT. LINE - 9 FT. GAP)
  - INSTALL 10 IN. SOLID WHITE HEAT APPLIED PERMANENT PREFORMED THERMOPLASTIC PAVEMENT MARKING LINE
  - INSTALL 24 IN. SOLID WHITE HEAT APPLIED PERMANENT PREFORMED THERMOPLASTIC PAVEMENT MARKING LINE
  - INSTALL WHITE HEAT APPLIED PERMANENT PREFORMED THERMOPLASTIC PAVEMENT MARKING ARROW. SEE TABLE FOR LOCATION
  - INSTALL 3 IN. SCHEDULE 80 RIGID PVC ELECTRICAL CONDUIT - BORED
  - INSTALL 12 IN. SOLID WHITE HEAT APPLIED PERMANENT PREFORMED THERMOPLASTIC PAVEMENT MARKING LINE
  - INSTALL 5 IN. SOLID YELLOW HEAT APPLIED PERMANENT PREFORMED THERMOPLASTIC PAVEMENT MARKING LINE
  - USE EXISTING DETECTION
  - USE EXISTING HANDHOLE
  - USE EXISTING CONDUIT
  - REMOVE EXISTING HANDHOLE
  - CAP AND ABANDON EXISTING CONDUIT
  - INSTALL VIDEO DETECTION CAMERA ON EXISTING MAST ARM
  - REMOVE EXISTING SIGN AND INSTALL NEW SIGN AS SHOWN
  - INSTALL NEW SIGNAL HEADS, PEDESTRIAN SIGNAL HEAD AND VIDEO DETECTION CAMERA. REMOVE EXISTING SIGNAL HEADS, PEDESTRIAN PUSHBUTTON AND SIGN FROM EXISTING POLE
  - INSTALL 10 FT. BREAKAWAY PEDESTAL POLE WITH PUSHBUTTON AND SIGN. CUT TO 5 FT., CLEAN, GALVANIZE AND CAP. (NOTE: INSTALL 1-3 IN. SCHEDULE 80, 90 DEGREE CONDUIT BEND)
  - INSTALL R3-8a SIGN ON TWO 4 IN. X 4 IN. WOOD SUPPORTS
  - REMOVE EXISTING POLE, MAST ARM AND ALL ASSOCIATED EQUIPMENT
  - USE EXISTING HANDHOLE. ADJUST TO FINAL GRADE
  - ABANDON EXISTING HANDHOLE
  - REMOVE EXISTING SIGN FROM MAST ARM
  - REMOVE EXISTING PEDESTAL POLE AND ALL ASSOCIATED EQUIPMENT
  - INSTALL 10 FT. BREAKAWAY PEDESTAL POLE WITH PUSHBUTTON, PEDESTRIAN SIGNAL HEAD AND SIGN. CUT TO 5 FT., CLEAN, GALVANIZE AND CAP. (NOTE: INSTALL 1-3 IN. SCHEDULE 80, 90 DEGREE CONDUIT BEND)
  - INSTALL W3-3 SIGN WITH NEW PANEL APPROXIMATELY 300 FT. IN ADVANCE OF THE INTERSECTION ON ONE 4 IN. X 6 IN. WOOD SUPPORT. THE SIGN IS FOR THE FIRST CASINO GARAGE SIGNAL.


**UTILITY LEGEND**

AERIAL CABLE	A
ELECTRICAL	E
TELEPHONE	T
GAS	G
SEWER	S
WATER	W
CABLE TV	TV

**GEOMETRIC LEGEND**


EXISTING	---
PROPOSED	---

**PROPOSED SIGNS**

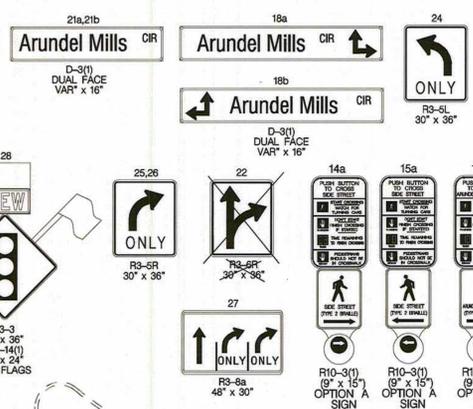


**COSTCO ACCESS**

**PROPOSED L.E.D. SIGNALS**

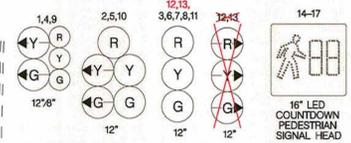

NOTE: SIGNAL INDICATIONS NO. 5,6 AND 11 SHALL BE INSTALLED IN EXISTING LOCATIONS

**EXISTING SIGNS**

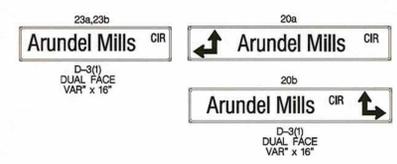


**PROPOSED VIDEO DETECTION CAMERA**



**EXISTING SIGN (TO BE REMOVED)**



**NEMA PHASING**

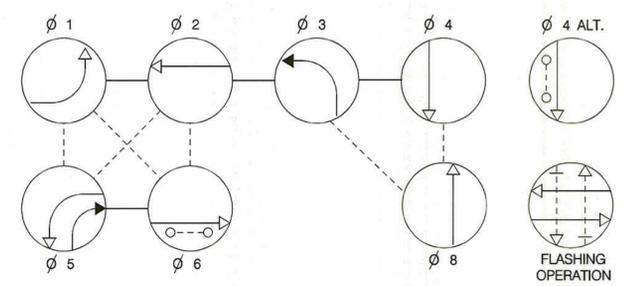

**PHASING NOTES:**

- PHASES ASSOCIATED BY A SOLID LINE WILL NOT OPERATE CONCURRENTLY.
- PHASES ASSOCIATED BY A DASHED LINE MAY OPERATE CONCURRENTLY.

ARUNDEL MILLS CIRCLE

MATCH LINE SEE ARUNDEL MILLS CIRCLE BETWEEN COSTCO AND MILLS DRIVE

**NORTBOUND ARUNDEL MILLS CIRCLE LANE DROP SIGNING AND PAVEMENT MARKING LOCATION TABLE**

TRAFFIC CONTROL DEVICE	DISTANCE FROM STOP BAR
RIGHT ARROWS	50'
LEFT ARROW	50'
ONLY	100'
RIGHT ARROWS	150'
LEFT ARROW	150'
ONLY	200'
RIGHT ARROW	250'
R3-8(F) SIGN	250'

**RED LINE REVISION NO. 3**  
May 23, 2012  
Revise Signal Heads  
TEDD Approval: *[Signature]*

**GENERAL NOTES**

- THE LOCATION OF PROPOSED GEOMETRICS MUST BE CONFIRMED PRIOR TO THE INSTALLATION OF SIGNAL EQUIPMENT.
- ALL UNDERGROUND AND OVERHEAD UTILITIES SHOWN ON THESE PLANS ARE SCHEMATIC ONLY AND MAY NOT BE COMPLETE. THE CONTRACTOR SHALL BE RESPONSIBLE FOR NOTIFYING MISS UTILITY PRIOR TO THE CONSTRUCTION SO THAT ALL UTILITIES MAY BE LOCATED IN THE FIELD. IF THE CONTRACTOR PERCEIVES THAT A CONFLICT BETWEEN UTILITIES AND THE TRAFFIC SIGNAL WILL OCCUR, THE CONTRACTOR SHALL NOTIFY THE PROJECT ENGINEER IMMEDIATELY SO THAT THE CONFLICT MAY BE RESOLVED.
- ALL TRAFFIC SIGNAL FOUNDATIONS SHALL BE INSTALLED AT THE FINAL SIDEWALK OR CURB GRADE FOR CLOSED SECTIONS. HIGHEST ROADWAY PROFILE GRADE FOR OPEN SECTIONS, TO MEET CLEARANCES AS SPECIFIED IN MD 816.03, MD 818.01, MD 818.02, MD 818.04. THE CONTRACTOR SHALL VERIFY ULTIMATE GRADES PRIOR TO THE INSTALLATION OF ALL SIGNAL EQUIPMENT.
- DISCONNECT AND ABANDON ALL EXISTING DETECTION

**EASTBOUND ARUNDEL MILLS CIRCLE LANE DROP SIGNING AND PAVEMENT MARKING LOCATION TABLE**

TRAFFIC CONTROL DEVICE	DISTANCE FROM PAINT GORE
ARROWS	50'
R3-8a SIGN	50'
ONLY	110'
ARROWS	170'
R3-8a SIGN	170'
R3-7(2)(F) CASINO SIGN	325'

**SHA** STATE OF MARYLAND  
DEPARTMENT OF TRANSPORTATION  
STATE HIGHWAY ADMINISTRATION  
OFFICE OF TRAFFIC & SAFETY  
TRAFFIC ENGINEERING DESIGN DIVISION  
**ARUNDEL MILLS CIRCLE AND COSTCO**  
HANOVER, MARYLAND

**TRAFFIC CONCEPTS, INC.**  
325 Gambrills Road  
Suite B  
Gambrills, MD 21054  
(410) 923-7101  
FAX: (410) 923-6473  
EMAIL: TRAFFIC@TRAFFIC-CONCEPTS.COM

APPROVALS	REVISIONS
TEAM LEADER	
ASST. DIV. CHIEF	
DIVISION ENGINEER	
OFFICE DIRECTOR	

**TRAFFIC SIGNALIZATION PLAN**

SCALE 1"=20' DATE 6-23-11 CONTRACT NO. BW996M82

DESIGNED BY	J.K. SCHMID	COUNTY	ANNE ARUNDEL
DRAWN BY	J.K. SCHMID	LOGMILE	02550100.00
CHECKED BY	T. ZAYDEL	T.I.M.S. NO.	K-976
F.A.P. NO.	NA	TOD NO.	

DRAWING NO. TS-3963 A SHEET NO. 1 OF 2

FILE PATH: Z:\2400\2475\Signals\Arundel Mills C@Costco\redline.dgn  
DATE: Wednesday, May 23, 2012 AT 02:32 PM