




BURGER REV. DATE: March 12 2008 07

DRILL HOLES

DRILL HOLES

DRILL HOLES

BY: Aaron Hottenstein Division: P068 Highway Traff GMA Emp

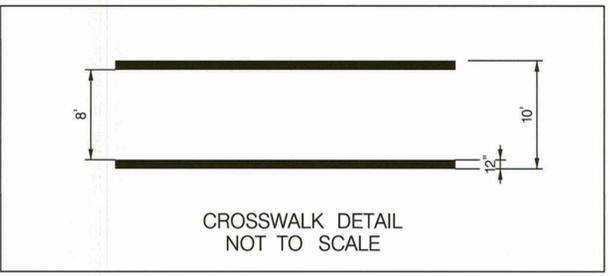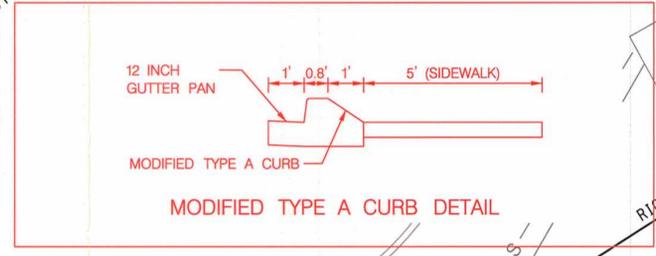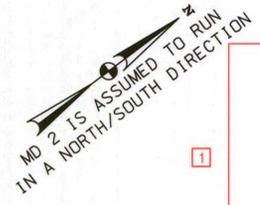

SOUTHDOWN ROAD

MD 2 (SOLOMONS ISLAND ROAD) (SBL)

MD 2 (SOLOMONS ISLAND ROAD) (NBL)

1 INSTALL 3' MODIFIED TYPE A CURB, SEE DETAIL.

REMOVE EXISTING BRICK AND RESET AS NEEDED.

EXISTING TRAFFIC SIGNAL EASEMENT

CONSTRUCTION DETAILS

- (A) INSTALL NEW SIDEWALK AND RAMP (STANDARD NOS. 655.12 AND 655.40).
- (B) INSTALL MODIFIED TYPE A CURB (0 TO 8 INCH HEIGHT).
- (C) INSTALL STANDARD TYPE A CURB AND GUTTER.
- (D) INSTALL NEW 5 INCH CONCRETE SIDEWALK.
- (E) RESET DECORATIVE BRICK SIDEWALK.
- (F) REMOVE EXISTING SIDEWALK.

1 REDLINE NO. 1
[Signature] 6-13-13
 NAME DATE

KCI TECHNOLOGIES
 ENGINEERS
 PLANNERS
 SCIENTISTS
 CONSTRUCTION MANAGERS
 936 RIDGEBROOK ROAD
 SPARKS, MARYLAND 21152
 TELEPHONE (410) 316-7800
 FAX (410) 316-7818

SHA STATE OF MARYLAND
 DEPARTMENT OF TRANSPORTATION
 STATE HIGHWAY ADMINISTRATION
 OFFICE OF TRAFFIC & SAFETY
 TRAFFIC ENGINEERING DESIGN DIVISION
 MD 2 (SOLOMONS ISLAND ROAD) AT
 SOUTHDOWN ROAD
 EDGEWATER, MARYLAND

TRAFFIC SIGNAL PLAN DETAIL

SCALE 1" = 10' ADVERTISED DATE JANUARY 2013 CONTRACT NO. XY1395185

DESIGNED BY JVB/AMH OF KCI COUNTY ANNE ARUNDEL
 DRAWN BY JVB OF KCI LOGMILE 02000216.89
 CHECKED BY JFL OF KCI TIMS NO. L652
 F.A.P. NO. TOD NO.

TS NO. 1817-C DRAWING SG-2 OF 3 SHEET NO. 5 OF 21

PLOTTED: 10:53 AM on Thursday, May 30, 2013
 FILE: M:\2009\01060619.81\drawings\p068-P002_MD2Detail.dgn