





BORDER REV. DATE: M08112720807

DRILL HOLES

DRILL HOLES

DRILL HOLES

BY: Aaron Hottenstein Division: P068 Highway Traff GMA Emp

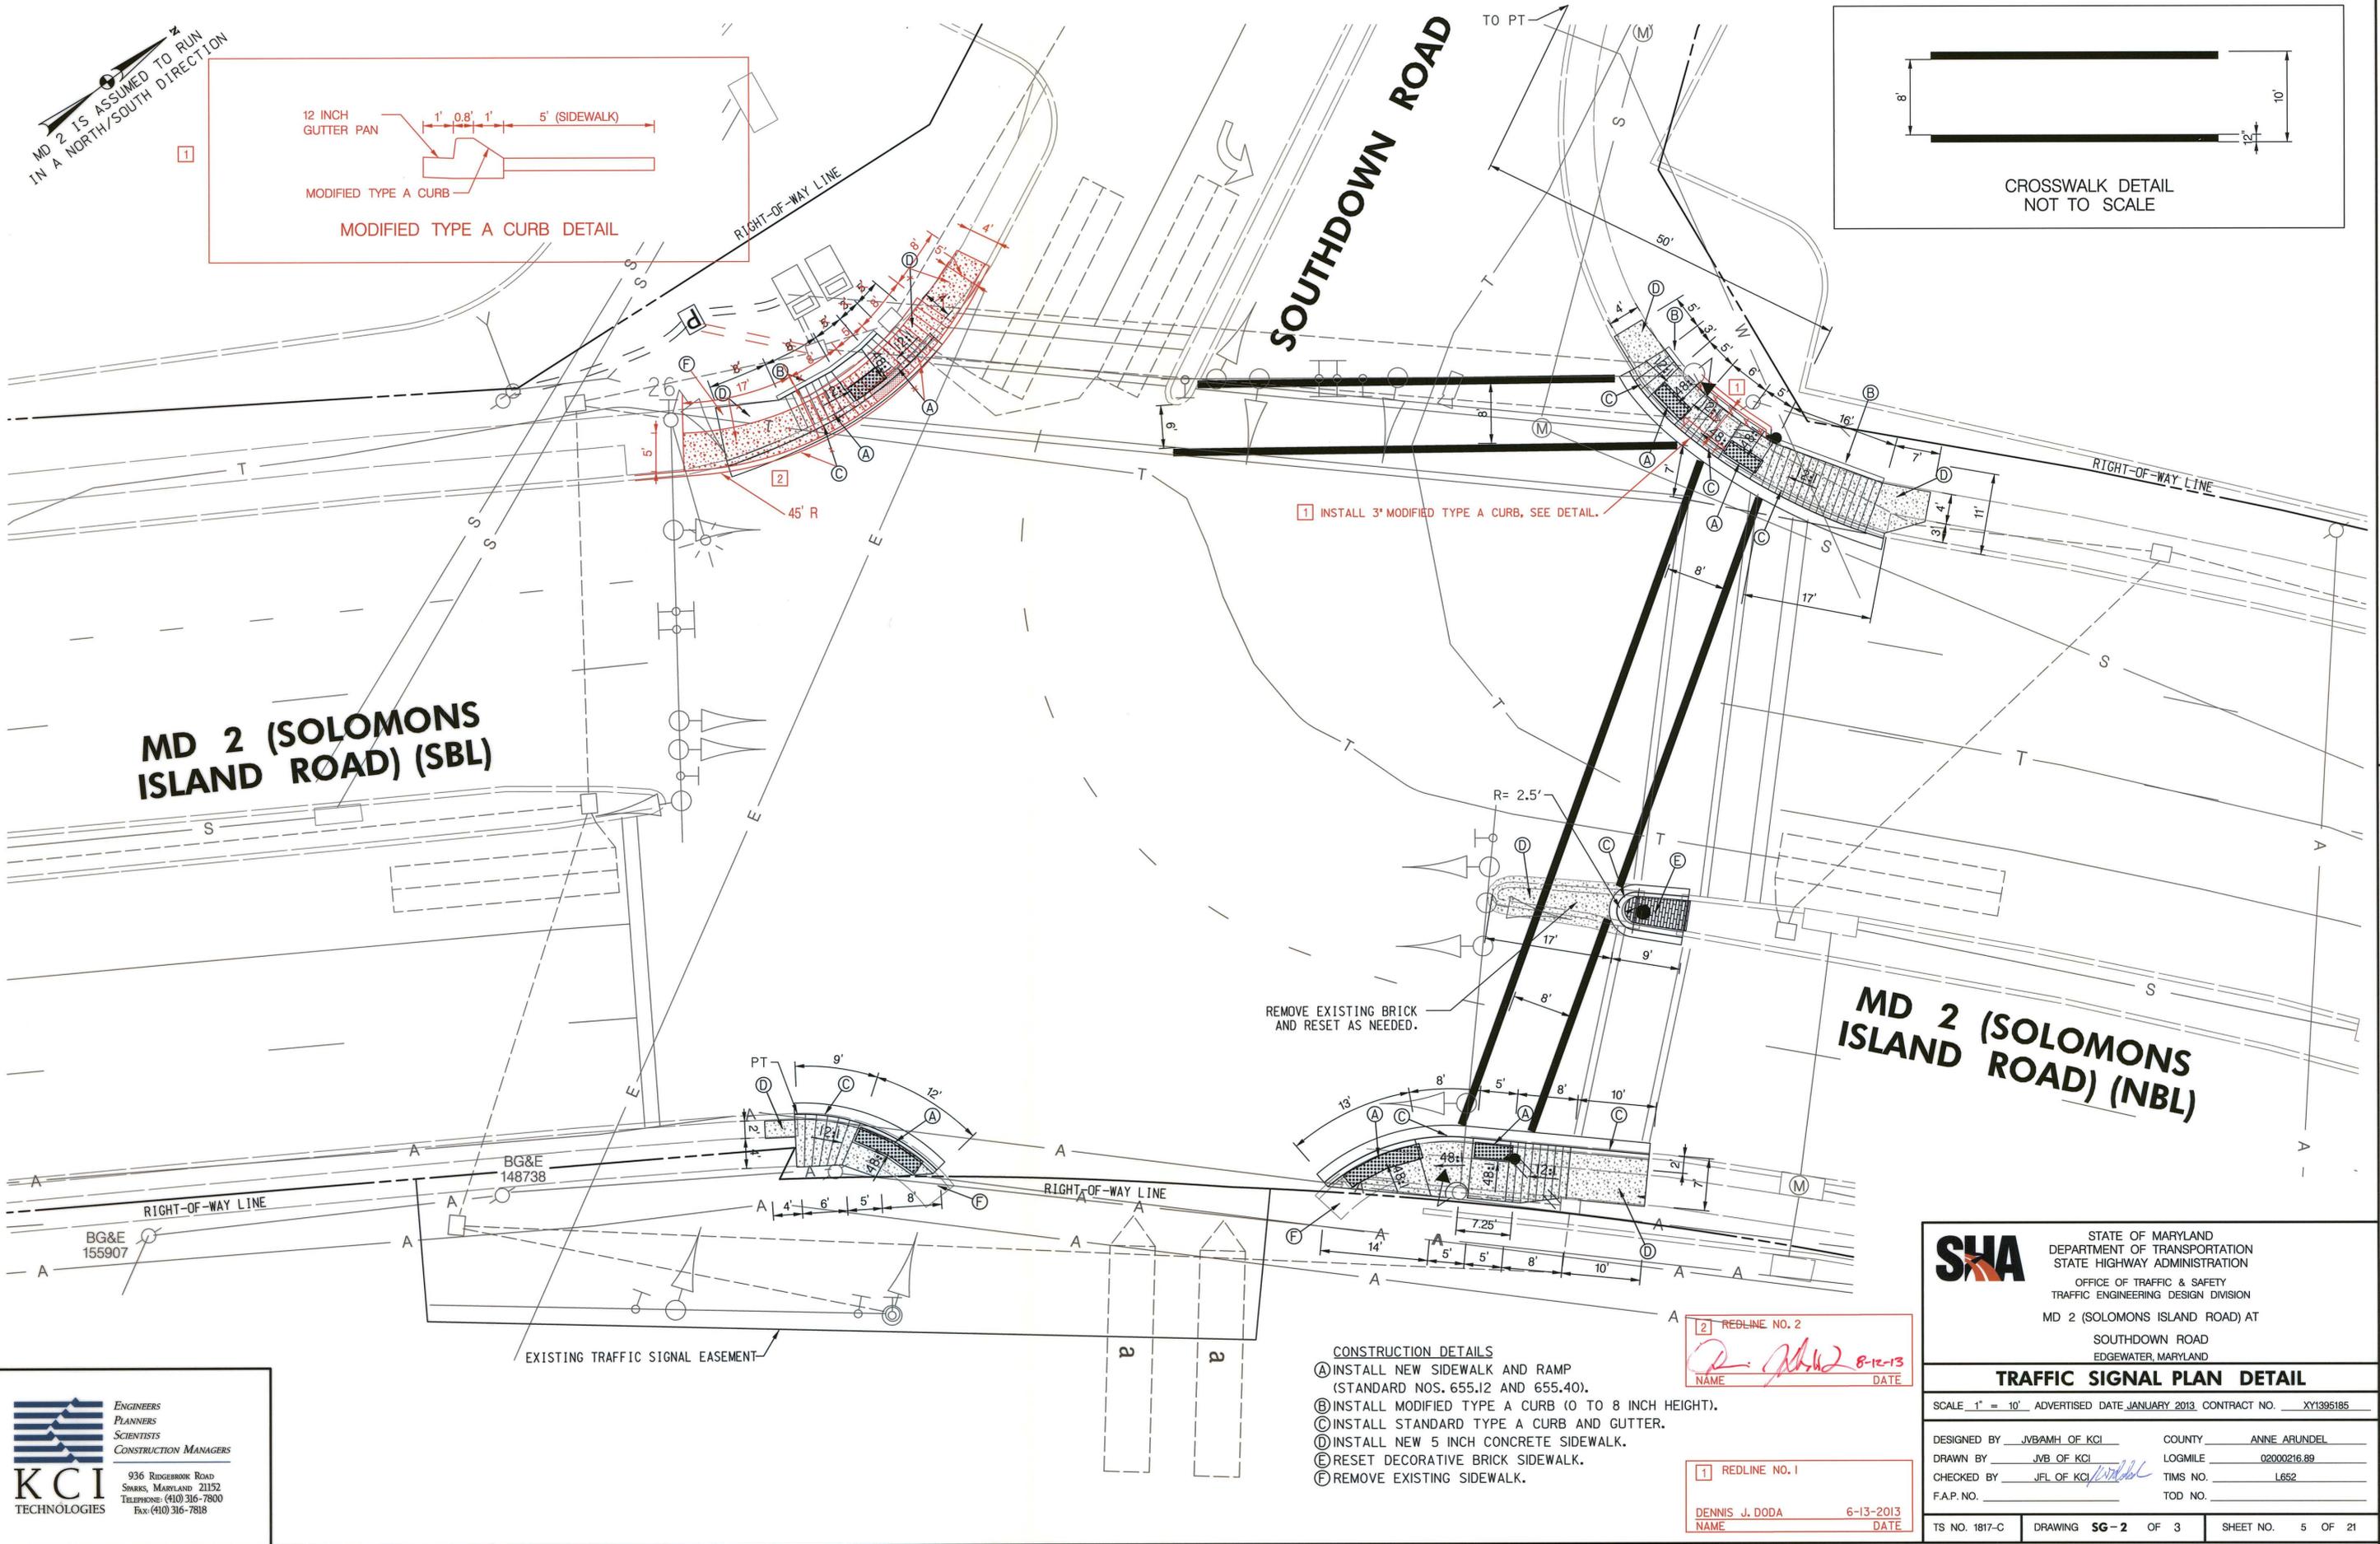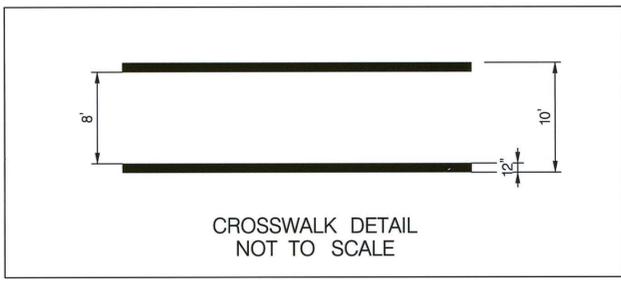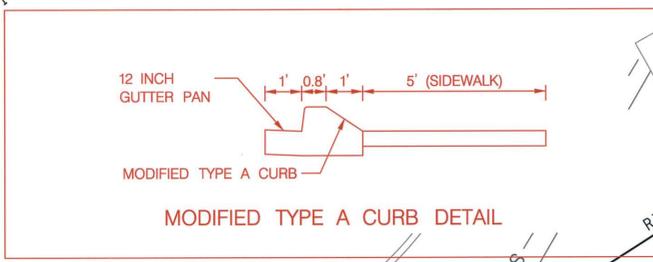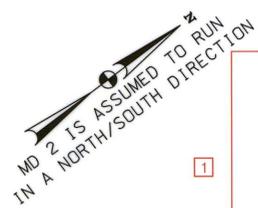

**KCI TECHNOLOGIES**  
 ENGINEERS  
 PLANNERS  
 SCIENTISTS  
 CONSTRUCTION MANAGERS  
 936 RIDGEBROOK ROAD  
 SPARKS, MARYLAND 21152  
 TELEPHONE: (410) 316-7800  
 FAX: (410) 316-7818

- CONSTRUCTION DETAILS**
- (A) INSTALL NEW SIDEWALK AND RAMP (STANDARD NOS. 655.12 AND 655.40).
  - (B) INSTALL MODIFIED TYPE A CURB (0 TO 8 INCH HEIGHT).
  - (C) INSTALL STANDARD TYPE A CURB AND GUTTER.
  - (D) INSTALL NEW 5 INCH CONCRETE SIDEWALK.
  - (E) RESET DECORATIVE BRICK SIDEWALK.
  - (F) REMOVE EXISTING SIDEWALK.

**[2] REDLINE NO. 2**  
*Dennis J. Doda* 8-12-13  
 NAME DATE

**[1] REDLINE NO. 1**  
 DENNIS J. DODA 6-13-2013  
 NAME DATE

**SHA** STATE OF MARYLAND  
 DEPARTMENT OF TRANSPORTATION  
 STATE HIGHWAY ADMINISTRATION  
 OFFICE OF TRAFFIC & SAFETY  
 TRAFFIC ENGINEERING DESIGN DIVISION  
 MD 2 (SOLOMONS ISLAND ROAD) AT  
 SOUTHDOWN ROAD  
 EDGEWATER, MARYLAND

**TRAFFIC SIGNAL PLAN DETAIL**

SCALE 1" = 10' ADVERTISED DATE JANUARY 2013 CONTRACT NO. XY1395185

DESIGNED BY JVB/AMH OF KCI COUNTY ANNE ARUNDEL  
 DRAWN BY JVB OF KCI LOGMILE 02000216.89  
 CHECKED BY JFL OF KCI TIMS NO. L652  
 F.A.P. NO. TOD NO.

TS NO. 1817-C DRAWING **SG-2** OF 3 SHEET NO. 5 OF 21