


DRILL HOLES

DRILL HOLES

DRILL HOLES

BORDER REV. DATE: JUN 11, 2004

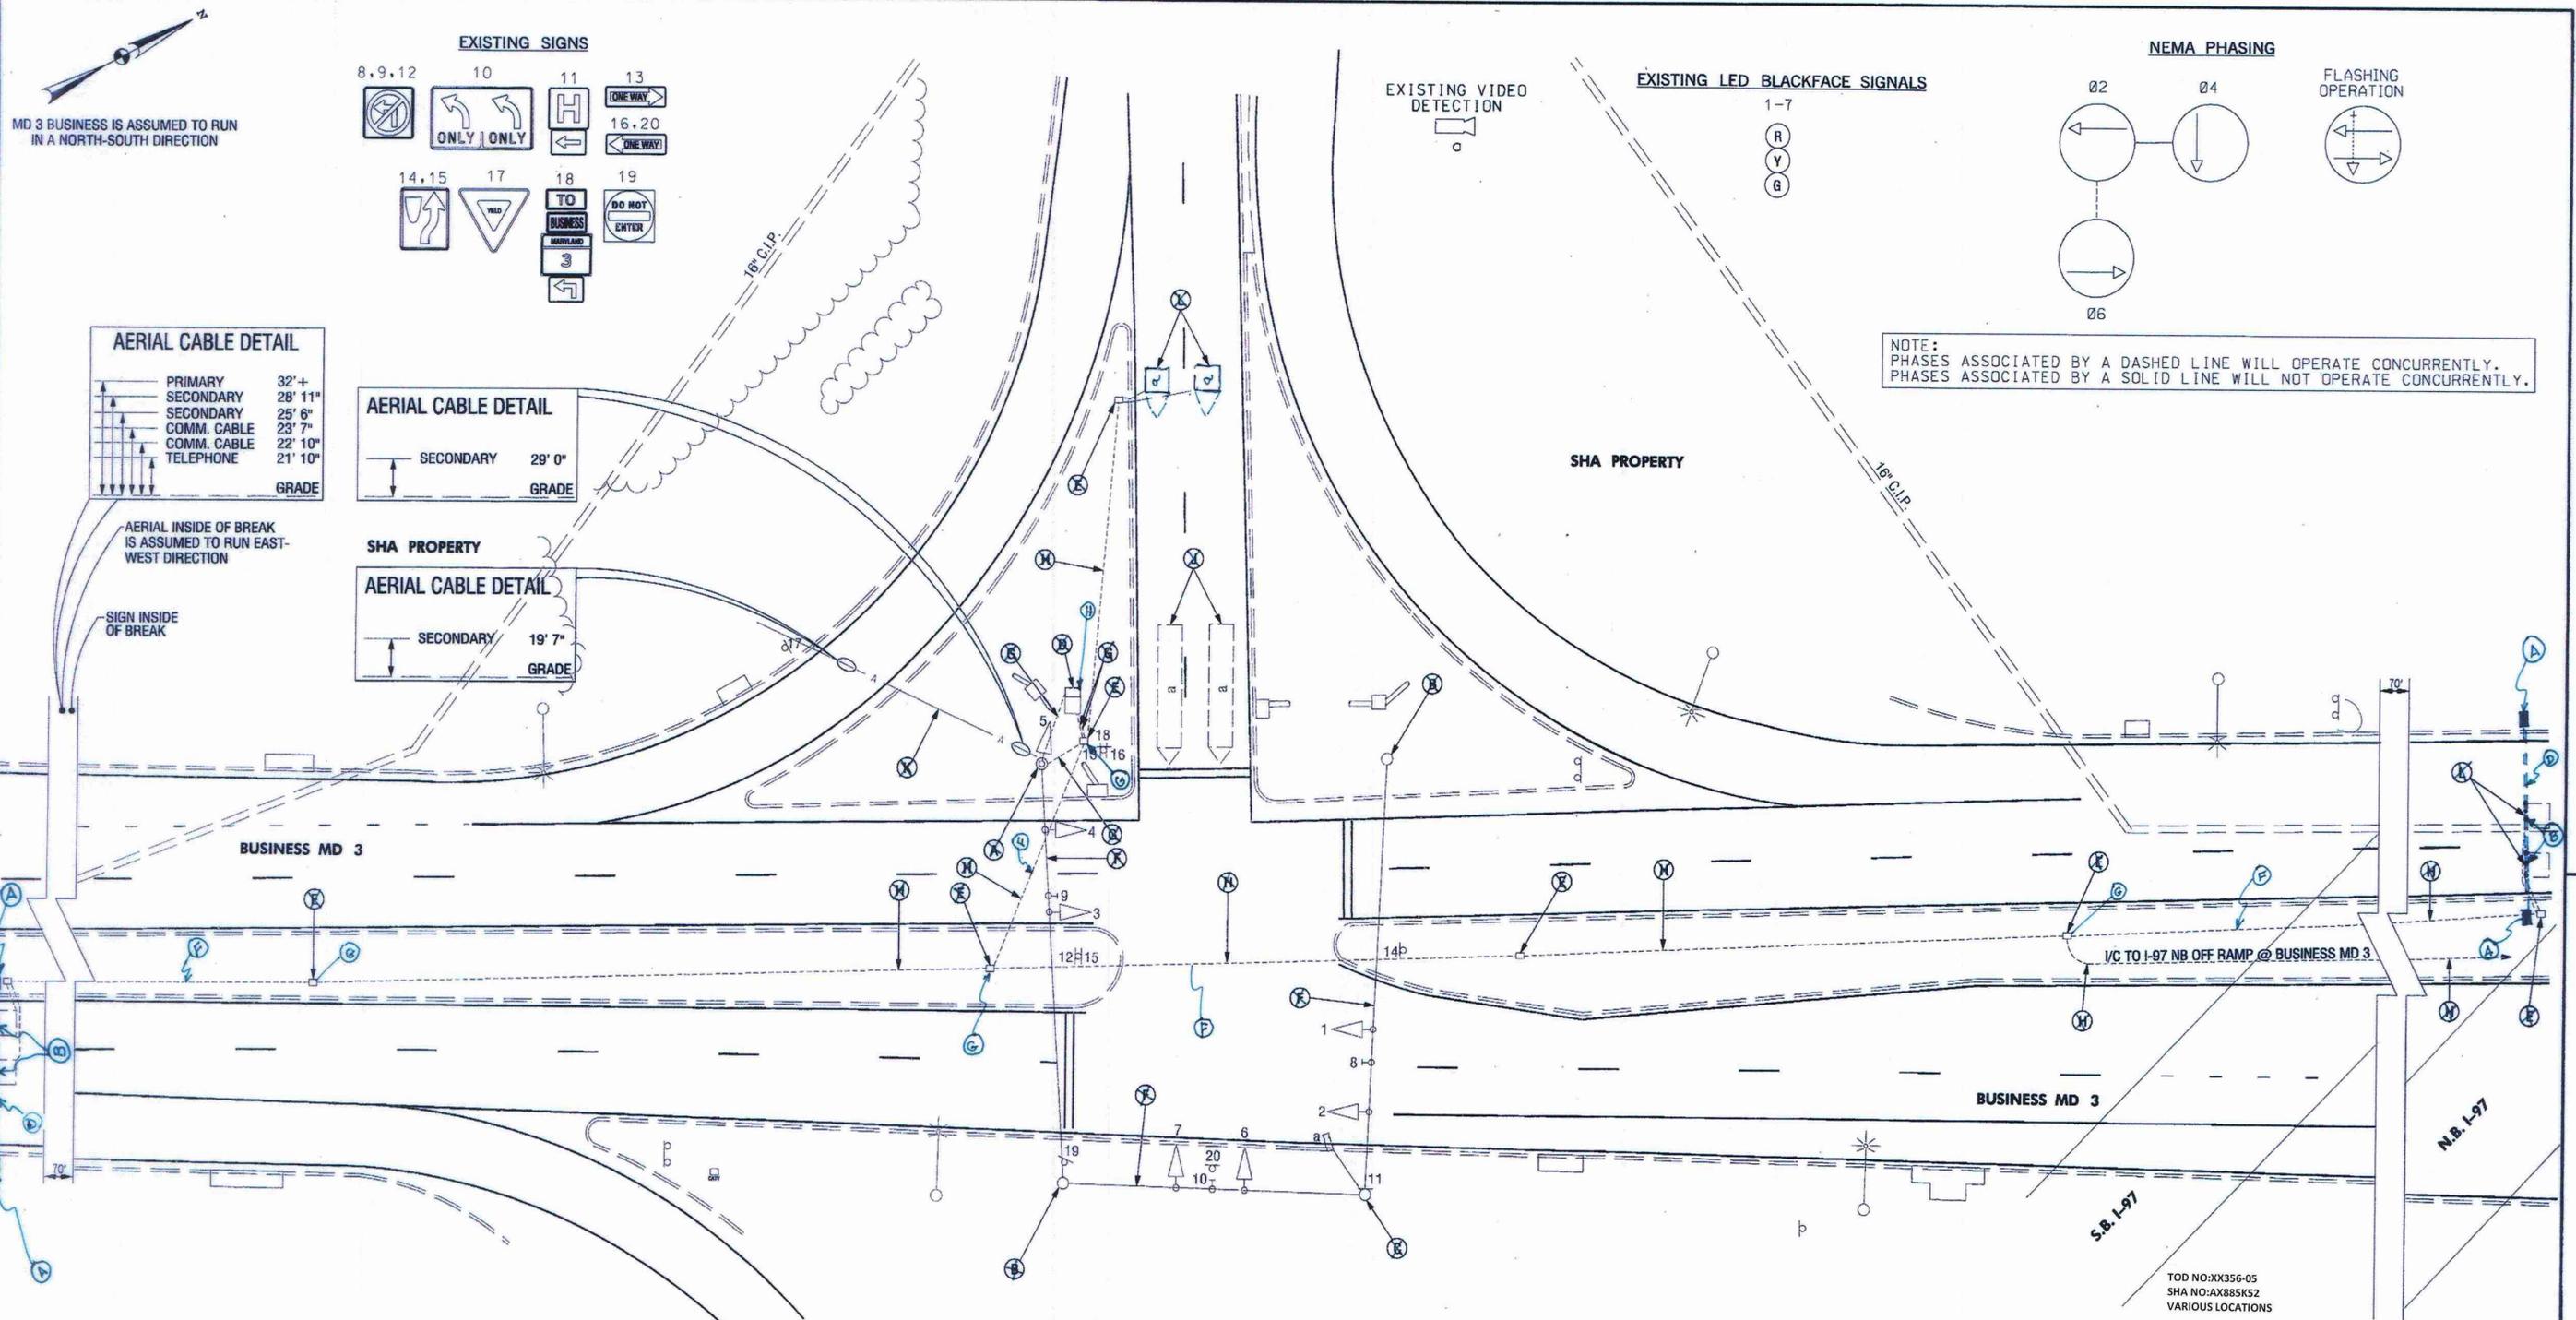

REVISIONS	
©	Traffic Signal Detection Upgrade - J630 09/17/2009 XX356168
B	SHA No. XX4486185 TMS No. J431X 7/2/2009 UPGRADE ALL TRAFFIC SIGNAL HEADS TO LED AND INSTALL NEAR-SIDE SIGNAL
A	INSTALL VIDEO DETECTION SHA No. AT308195 9/5/04

TRAFFIC SIGNAL PLAN			
SCALE	1" = 20'	DATE	NOVEMBER 1986
DESIGNED BY	PAH	COUNTY	ANNE ARUNDEL
DRAWN BY	CLD	LOGMILE	0.44 @ 2.9902800300.44
CHECKED BY	DJD	T.I.M.S. NO.	
F.A.P. NO.	I-97-1(12)	TOD NO.	
TS NO.	2193C	DRAWING	1 OF 1
		SHEET NO.	OF

SABRA, WANG & ASSOCIATES, INC.
1504 JOH AVENUE
SUITE 160
BALTIMORE, MD 21227
(410) 737-6564
WWW.SABRA-WANG.COM

PLOTTED: Tuesday, May 26, 2009 AT 01:50 PM
FILE: R:\2004\45 SHA BCS 2004-028 TEDD Traffic\Task 70 MD 3 Bus at SB I-97\Dgn\MD3BUS@97SRamp_Asbuilt.dgn