



MD 175 (ANNAPOLIS ROAD) IS ASSUMED TO RUN IN AN EAST-WEST DIRECTION.

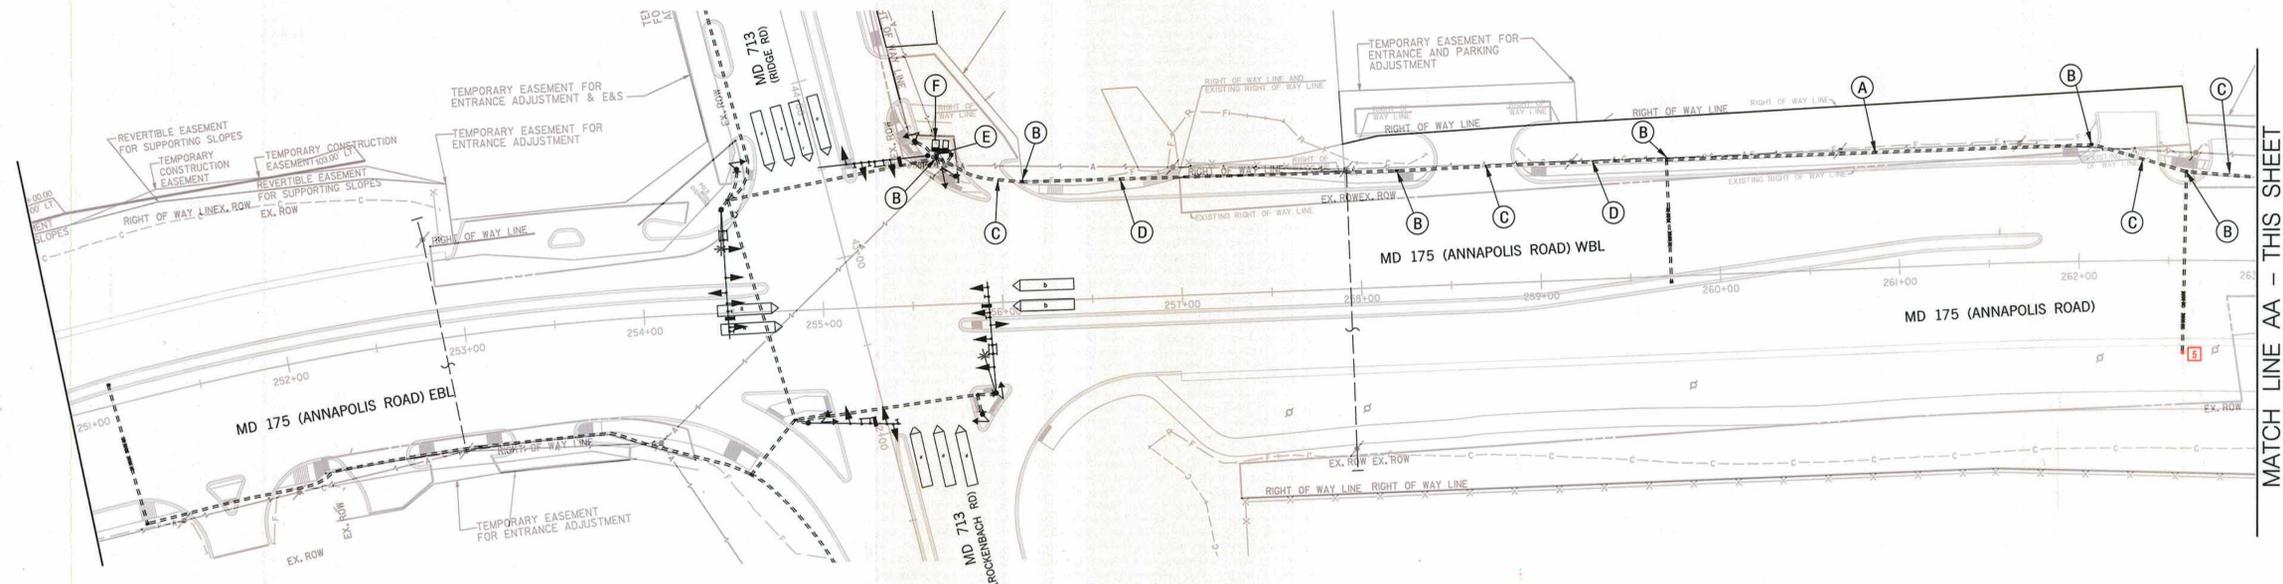

MATCH LINE AA - THIS SHEET

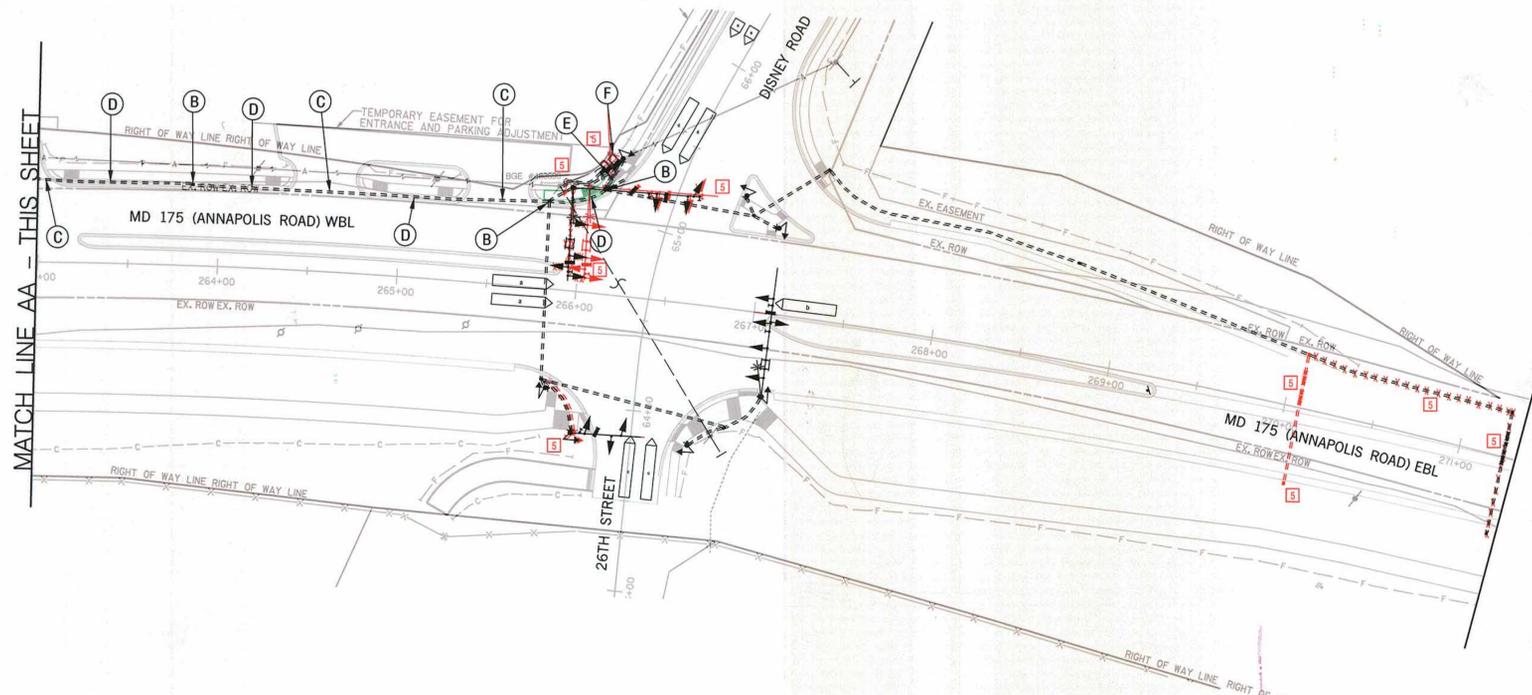

MATCH LINE AA - THIS SHEET

GENERAL NOTES

1. THE CONTRACTOR SHALL VERIFY ALL UNDERGROUND UTILITIES PRIOR TO INSTALLING PROPOSED CONDUIT RUNS. IF ANY UTILITY CONFLICTS SHOULD ARISE, THE CONTRACTOR SHALL CONTACT THE PROJECT ENGINEER.
2. THE CONTRACTOR SHALL BE RESPONSIBLE FOR REMOVING UNUSED CABLES FROM EXISTING HANDHOLES AND CONDUITS UTILIZED FOR THE INTERCONNECT RUN.

EQUIPMENT LIST "B"

B. EQUIPMENT TO BE FURNISHED AND/OR INSTALLED BY THE CONTRACTOR

CATEGORY CODE	QUANTITY	DESCRIPTION
805135	240 LF	3" SCHEDULE 80 RIGID PVC CONDUIT - TRENCHED
822002	1430 LF	12 PAIR COMMUNICATION CABLE - JELLYFILLED

CONSTRUCTION DETAILS

- INSTALL 3" SCHEDULE 80 RIGID PVC CONDUIT (TRENCHED). INSTALL 12-PAIR COMMUNICATION CABLE.
- USE PROPOSED HANDHOLE (SEE SIGNAL PLAN) FOR INSTALLATION OF 12-PAIR COMMUNICATION CABLE
- USE PROPOSED 3" SCHEDULE 80 RIGID PVC CONDUIT-SLOTTED (SEE SIGNAL PLAN) FOR INSTALLATION OF 12-PAIR COMMUNICATION CABLE.
- USE PROPOSED 3" SCHEDULE 80 RIGID PVC CONDUIT-TRENCHED (SEE SIGNAL PLAN) FOR INSTALLATION OF 12-PAIR COMMUNICATION CABLE.
- USE PROPOSED 4" SCHEDULE 80 RIGID PVC CONDUIT-TRENCHED (SEE SIGNAL PLAN) FOR INSTALLATION OF 12-PAIR COMMUNICATION CABLE.
- USE PROPOSED BASE MOUNTED CABINET AND CONTROLLER. CONNECT 12-PAIR COMMUNICATION CABLE TO PROPOSED CONTROLLER (SEE SIGNAL PLAN).

UTILITY LEGEND

— G —	GAS MAIN
— W —	WATER MAIN
— S —	SEWER MAIN
— E —	ELECTRIC CABLES
— A —	AERIAL CABLES
— T —	TELEPHONE CABLES

REDLINE REVISION NO. 5
MD 175 AT DISNEY ROAD; REVISED POLE LOCATIONS IN THE NW QUADRANT
1/2/2013

SHA STATE OF MARYLAND
DEPARTMENT OF TRANSPORTATION
STATE HIGHWAY ADMINISTRATION
OFFICE OF TRAFFIC & SAFETY
TRAFFIC ENGINEERING DESIGN DIVISION
MD 175 (ANNAPOLIS ROAD) AT
MD 713 AND 26TH STREET/DISNEY ROAD
HANOVER, FORT MEADE, MD

CENTURY ENGINEERING
CONSULTING ENGINEERS - PLANNERS
10710 GILROY ROAD
HUNT VALLEY, MD 21031
23299.36: 27257.25

APPROVALS	REVISIONS
TEAM LEADER	
ASST. DIV. CHIEF	
DIVISION CHIEF	
OFFICE DIRECTOR	

TRAFFIC SIGNAL INTERCONNECT PLAN

SCALE 1" = 50' ADVERTISED DATE OCTOBER 2010 CONTRACT NO. AA5805370

DESIGNED BY	ENB	COUNTY	ANNE ARUNDEL
DRAWN BY	ENB	LOGMILE	02017506.83 TO 02017507.50
CHECKED BY	NR /MR	TIMS NO.	J-988 & J-969
F.A.P. NO.	ACPLHD-STP-TIP-3617(1)E	TOD NO.	

TS NO. 1295D1959D DRAWING **SG - 05** OF 5 SHEET NO. 151 OF 195