


DRILL HOLES

DRILL HOLES

DRILL HOLES


BORDER REV. DATE: June 1, 2004

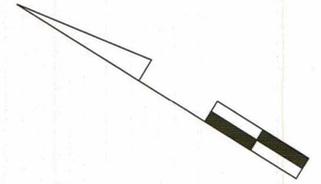

MATCH LINE "A"
SEE SHEET 2 OF 7

MATCH LINE "B"
SEE SHEET 4 OF 7

PROPOSED WIRELESS
TELEMETRY ANTENNA

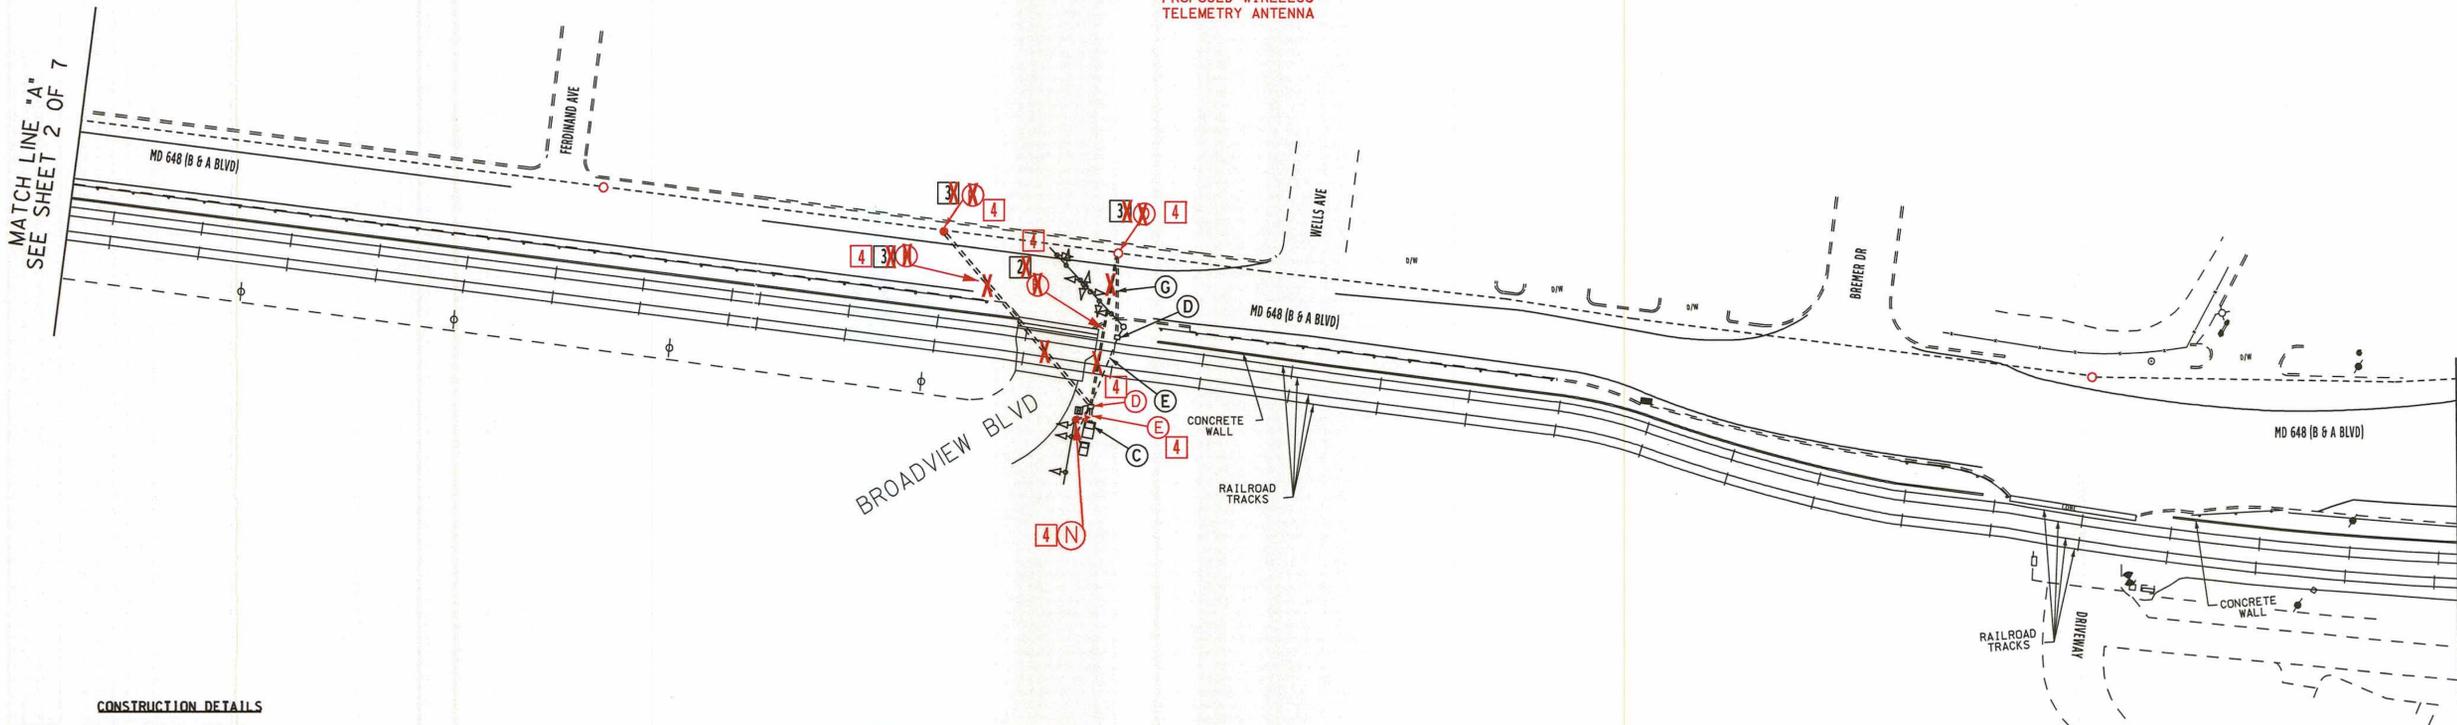

CONSTRUCTION DETAILS


- C. Use existing base mounted cabinet.
- D. Use existing handhole.
- E. Use existing conduit.
- F. Install manhole (See Roadway Patch Detail on this sheet.)
- G. Install 3" polyvinyl chloride electrical conduit (Schedule 80) (bored).

4 H. Install 4" polyvinyl chloride electrical conduit (Schedule 80) (bored). **X**

4 I. Install manhole (See Roadway Patch Detail on this sheet.) **X**

4 N. INSTALL WIRELESS TELEMETRY ANTENNA ON SIGNAL POLE UPRIGHT AND ROUTE CABLE TO EXISTING CABINET

ROADWAY PATCH DETAIL WITH
MANHOLE STANDARD NO. MD 811.04

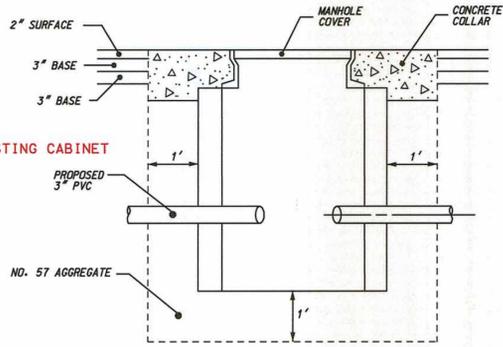


CONSTRUCTION NOTE:
1. No. 57 Aggregate shall be used with installation of all manholes (with 2-HMA lifts of 3" and a 2" surface).

GENERAL NOTES:

1. All underground utilities shown on these plans are schematic only and may not be complete. The contractor shall be responsible for notifying "MISS UTILITY" prior to construction so that all utilities may be located in the field. If the contractor perceives that a conflict between the utilities and the traffic signal will occur, the contractor shall notify the project engineer immediately so that the conflict may be resolved.

GEOMETRIC LEGEND	
PROPOSED	---
EXISTING	---
LEGEND OF UNDERGROUND AND OVERHEAD UTILITIES	
AERIAL CABLE	—A—A—
ELECTRIC	—E—E—
TELEPHONE	—T—T—
GAS	—G—G—
SEWER	—S—S—
WATER	—W—W—
CABLE TV	—TV—TV—

REDLINE #4 7/26/2013 APPROVED *Dennis Doda* 7-29-13
DENNIS DODA, TEAM LEADER, TEDD

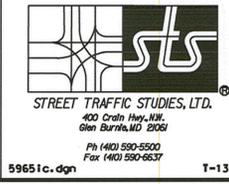

APPROVALS	REVISIONS
TEAM LEADER	
ASST. DIV. CHIEF	
DIVISION CHIEF	
OFFICE DIRECTOR	

SHA STATE OF MARYLAND
DEPARTMENT OF TRANSPORTATION
STATE HIGHWAY ADMINISTRATION

MD 648 (B & A BLVD): FROM WELLHAM
AVE TO MD 176 (DORSEY RD)
FERNDAL, MD

INTERCONNECT PLAN		XX6475185
SCALE 1" = 50'	DATE 11-16-11	CONTRACT NO. XX6315185
DESIGNED BY RRZ	COUNTY ANNE ARUNDEL	
DRAWN BY D.A.NIES	LOGMILE	
CHECKED BY	TMS NO. G799	
F.A.P. NO.	TOD NO.	
TS NO. 12555	DRAWING NO. 3 OF 7	SHEET NO. OF

PLOTTED: #DATE#
FILE: #FILE#