


DRILL HOLES

DRILL HOLES

DRILL HOLES

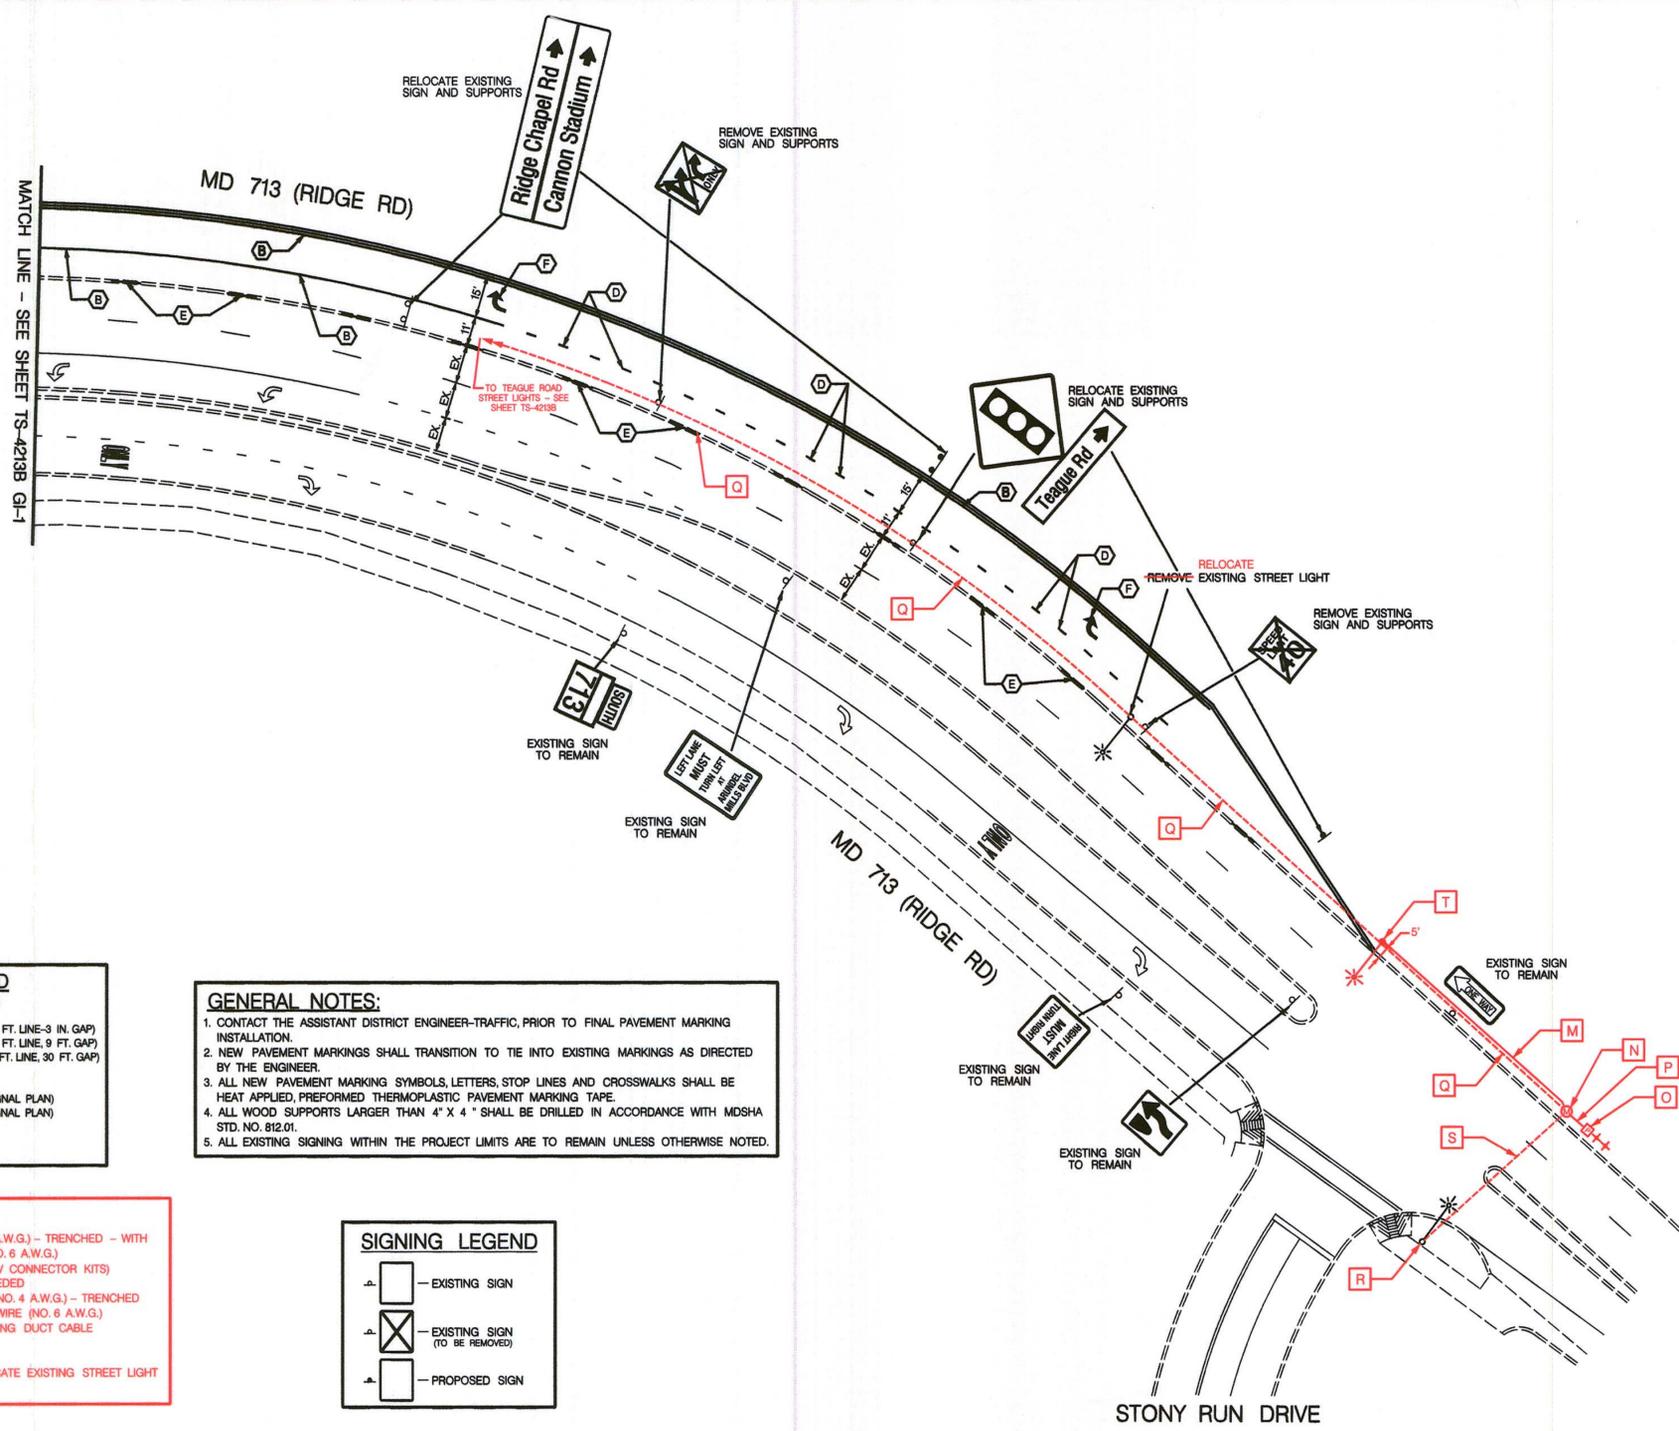

PAVEMENT MARKING LEGEND

- A. INSTALL 5 IN. SOLID YELLOW PAVEMENT MARKING
- B. INSTALL 5 IN. SOLID WHITE PAVEMENT MARKING
- C. INSTALL 5 IN. SKIP WHITE PAVEMENT MARKING (3 FT. LINE-3 IN. GAP)
- D. INSTALL 5 IN. SKIP WHITE PAVEMENT MARKING (3 FT. LINE, 9 FT. GAP)
- E. INSTALL 5 IN. SKIP WHITE PAVEMENT MARKING (10 FT. LINE, 30 FT. GAP)
- F. INSTALL WHITE PAVEMENT MARKING "ARROW"
- G. INSTALL WHITE PAVEMENT MARKING "ONLY"
- H. 12 IN. SOLID WHITE PAVEMENT MARKING (SEE SIGNAL PLAN)
- I. 24 IN. SOLID WHITE PAVEMENT MARKING (SEE SIGNAL PLAN)
- J. REMOVE EXISTING PAVEMENT MARKING LINE
- K. REMOVE EXISTING PAVEMENT MARKING "ARROW"
- L. INSTALL 10 IN. SOLID WHITE PAVEMENT MARKING

GENERAL NOTES:

- CONTACT THE ASSISTANT DISTRICT ENGINEER-TRAFFIC, PRIOR TO FINAL PAVEMENT MARKING INSTALLATION.
- NEW PAVEMENT MARKINGS SHALL TRANSITION TO TIE INTO EXISTING MARKINGS AS DIRECTED BY THE ENGINEER.
- ALL NEW PAVEMENT MARKING SYMBOLS, LETTERS, STOP LINES AND CROSSWALKS SHALL BE HEAT APPLIED, PREFORMED THERMOPLASTIC PAVEMENT MARKING TAPE.
- ALL WOOD SUPPORTS LARGER THAN 4" X 4" SHALL BE DRILLED IN ACCORDANCE WITH MSHA STD. NO. 812.01.
- ALL EXISTING SIGNING WITHIN THE PROJECT LIMITS ARE TO REMAIN UNLESS OTHERWISE NOTED.

CONSTRUCTION DETAILS

- M. INSTALL 2-CONDUCTOR DUCT CABLE (NO. 4 A.W.G.) - TRENCHED - WITH STRANDED BARE COPPER GROUND WIRE (NO. 6 A.W.G.)
- N. USE EXISTING ELECTRIC MANHOLE (4-TYPE IV CONNECTOR KITS)
- O. INSTALL METERED SERVICE PEDISTAL - EMBEDDED
- P. INSTALL TWO, 2-CONDUCTOR DUCT CABLES (NO. 4 A.W.G.) - TRENCHED - WITH STRANDED BARE COPPER GROUND WIRE (NO. 6 A.W.G.)
- Q. DISCONNECT AND ABANDON EXISTING LIGHTING DUCT CABLE
- R. USE EXISTING STREET LIGHT
- S. USE EXISTING STREET LIGHT CABLE
- T. INSTALL CONCRETE FOUNDATION AND RELOCATE EXISTING STREET LIGHT (2-TYPE II CONNECTOR KITS)

SIGNING LEGEND

- ▲ [] - EXISTING SIGN
- ▲ [X] - EXISTING SIGN (TO BE REMOVED)
- ▲ [] - PROPOSED SIGN

RED LINE REVISION NO. 1
 November 14, 2011
 Revise Street Lighting Electric Service
 TEDD Approval: *[Signature]*

TRAFFIC CONCEPTS, INC.
 325 Gambrills Road
 Suite B
 Gambrills, MD 21054
 (410) 923-7101
 FAX: (410) 923-6473
 EMAIL: TRAFFIC@TRAFFIC-CONCEPTS.COM

SHA STATE OF MARYLAND
 DEPARTMENT OF TRANSPORTATION
 STATE HIGHWAY ADMINISTRATION
 OFFICE OF TRAFFIC & SAFETY
 TRAFFIC ENGINEERING DESIGN DIVISION

MD 713 (RIDGE RD) FROM ARUNDEL MILLS BLVD TO STONY RUN DR HANOVER, MARYLAND

SIGNING AND PAVEMENT MARKING PLAN

SCALE	1" = 30'	DATE	10-17-11	CONTRACT NO.	BW996M82
DESIGNED BY	T. ZAYDEL	COUNTY	ANNE ARUNDEL	LOGMILE	-
DRAWN BY	T. ZAYDEL	T.I.M.S. NO.			
CHECKED BY	K. SCHMID	TOD NO.			
F.A.P. NO.	NA				
DRAWING NO.	TS-424d GI-2	SHEET NO.	3	OF	4

M:\2400\2475\Sigra\MD 713(Ridge Rd)\red-line-11-14-11.dgn
 Wednesday, November 30, 2011 AT 01:22 PM