


DRILL HOLES





DRILL HOLES

DRILL HOLES

BORDER REV. DATE: JUNE 11, 2004

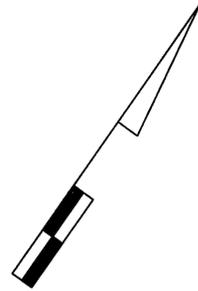

NOTE: MD 223 IS CONSIDERED TO RUN IN AN EAST-WEST DIRECTION.

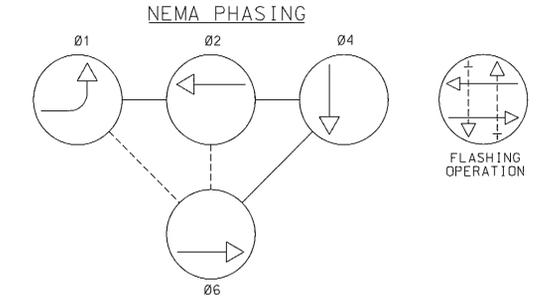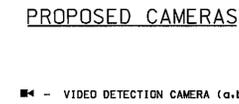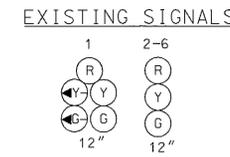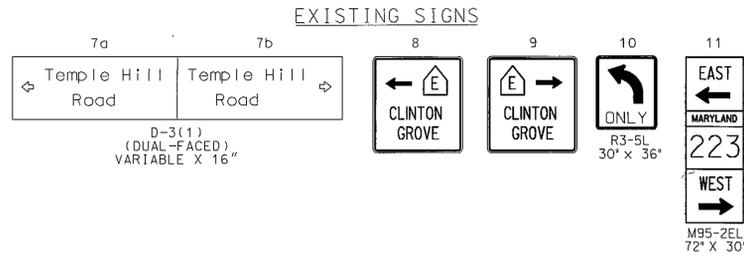

PHASING NOTES:


1. PHASES ASSOCIATED BY A DASHED LINE WILL OPERATE CONCURRENTLY

2. PHASES ASSOCIATED BY A SOLID LINE WILL NOT OPERATE CONCURRENTLY

GENERAL NOTES:

1. All underground utilities shown on these plans are schematic only and may not be complete. The contractor shall be responsible for notifying "MISS UTILITY" prior to construction so that all utilities may be located in the field. If the contractor perceives that a conflict between the utilities and the traffic signal will occur, the contractor shall notify the project engineer immediately so that the conflict may be resolved.

2. The contractor shall remove all unused wiring.

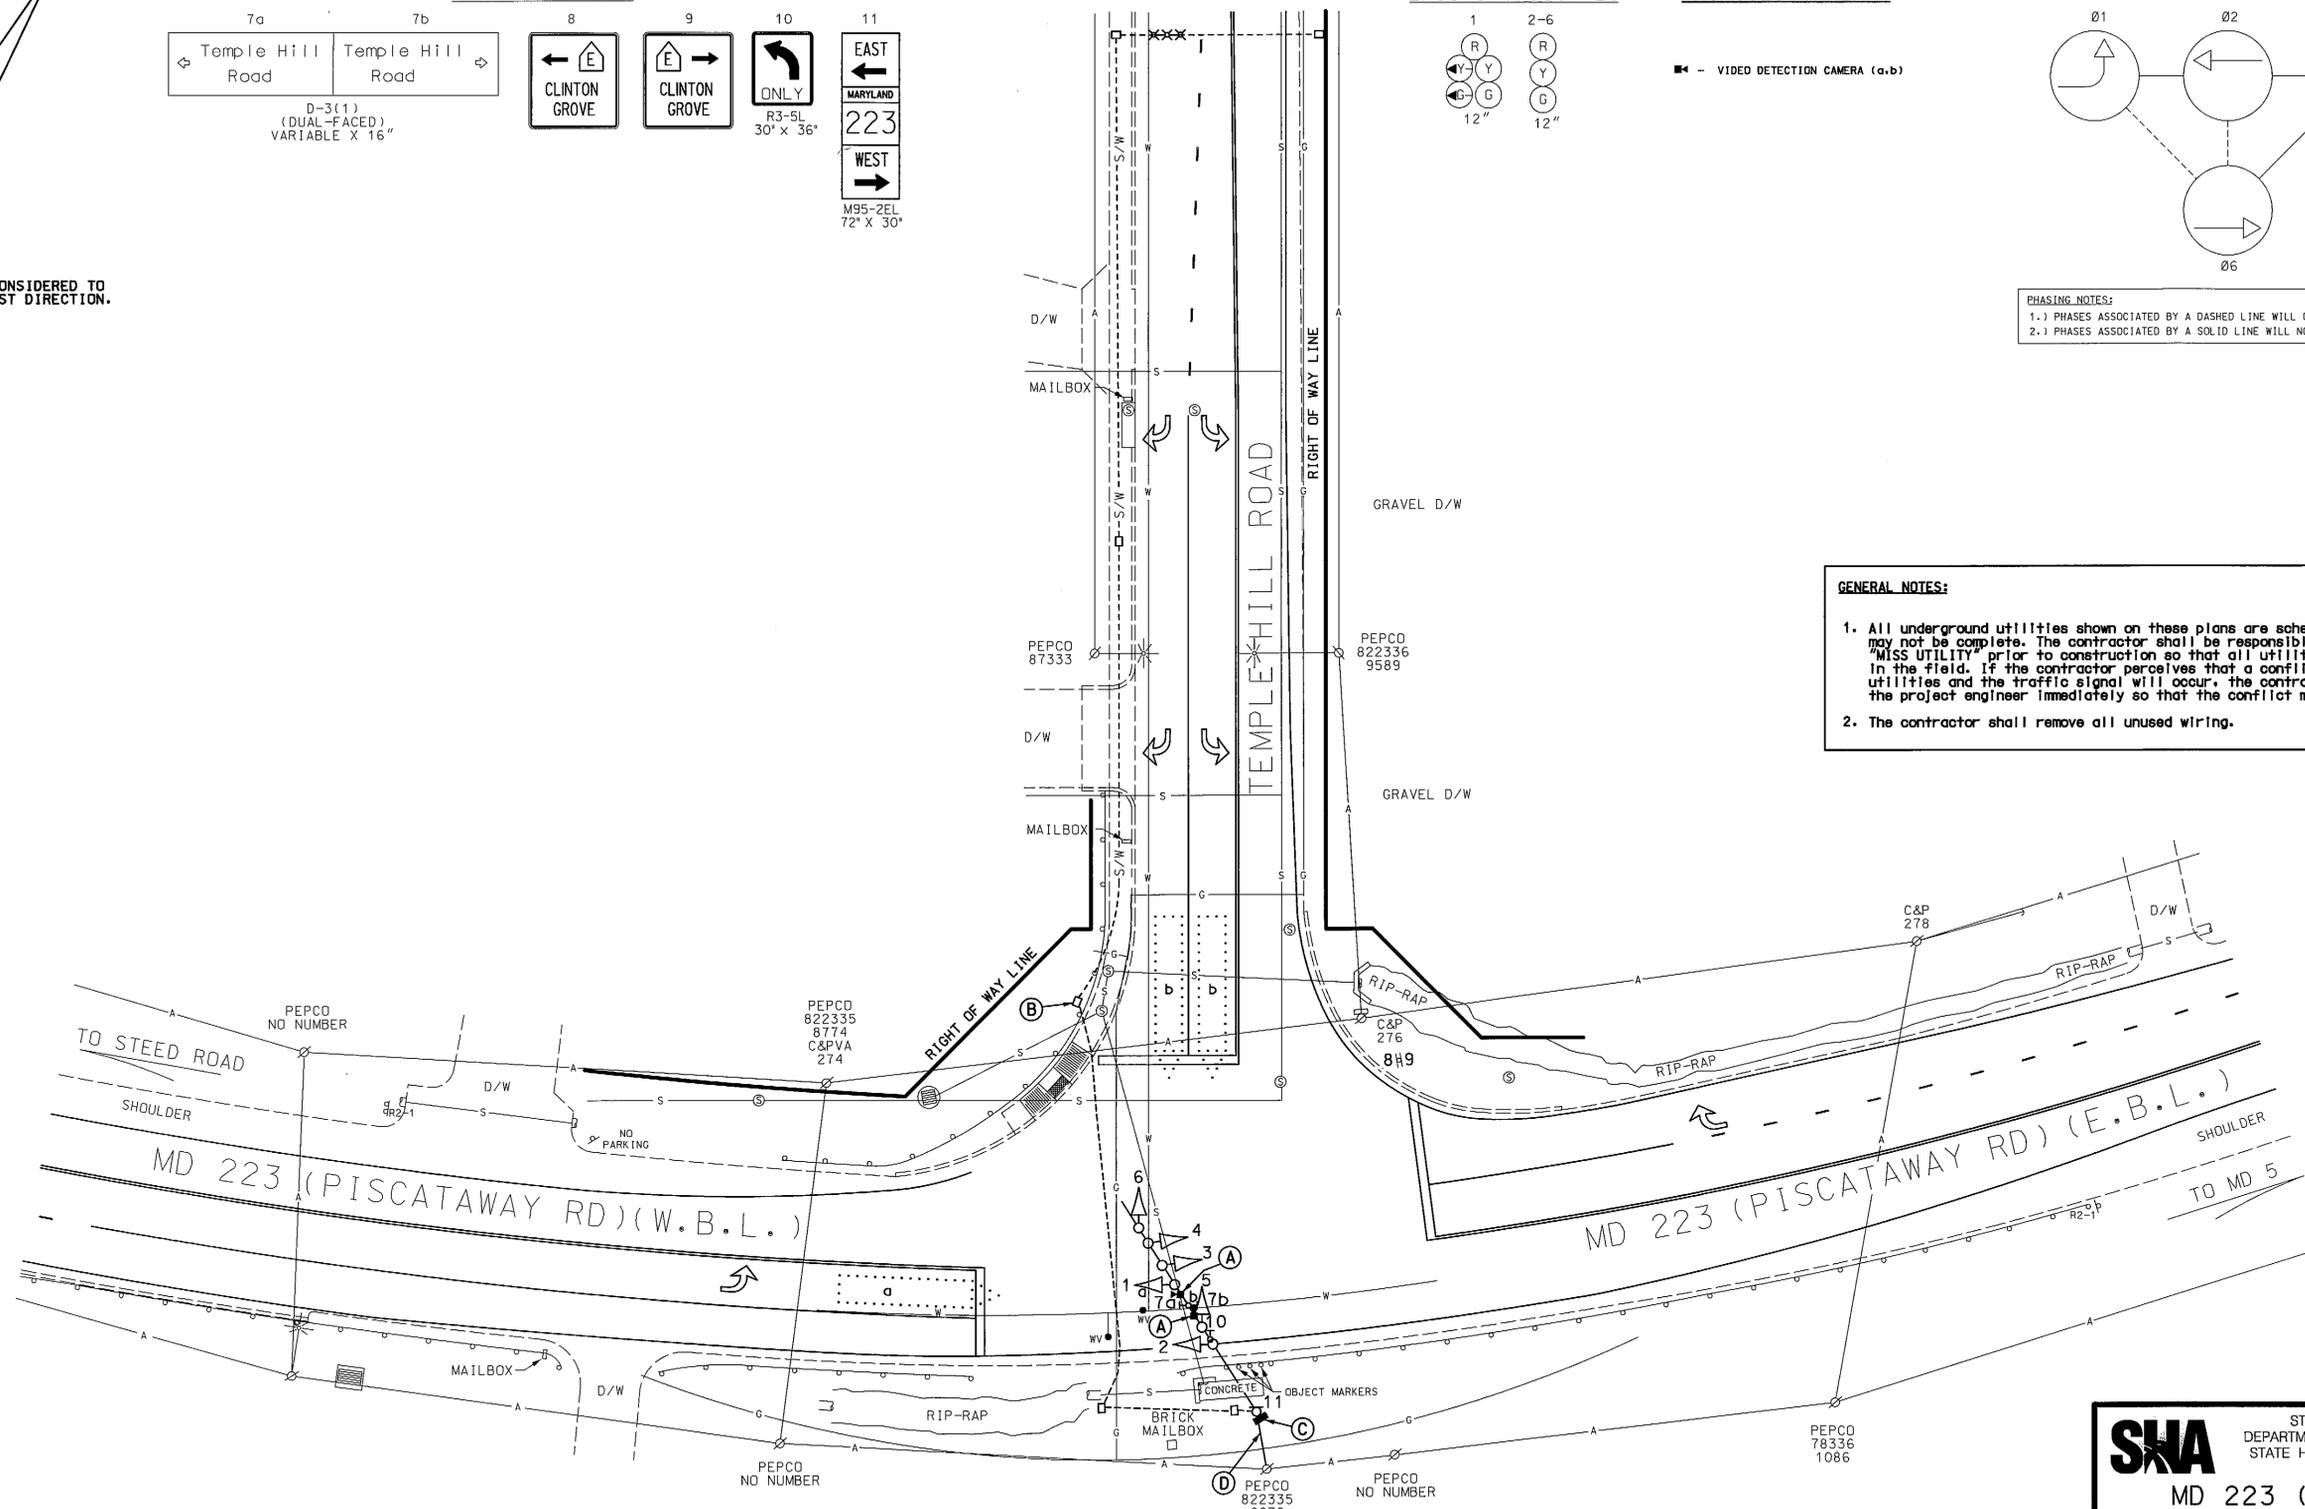

CONSTRUCTION DETAILS

- A. Install video detection camera onto existing mast arm.
- B. Disconnect and abandon existing loop detector.
- C. Remove existing cabinet and install new pole mounted cabinet. (Note: SHA Forces shall remove existing controller and install it as well as Video interface into new cabinet).
- D. Existing overhead electrical service to be maintained by PEPCO.

GEOMETRIC LEGEND

PROPOSED _____

EXISTING _____

LEGEND OF UNDERGROUND AND OVERHEAD UTILITIES

AERIAL CABLE	—A—A—
ELECTRIC	—E—E—
TELEPHONE	—T—T—
GAS	—G—G—
SEWER	—S—S—
WATER	—W—W—
CABLE TV	—TV—TV—

REVISION "C"

STREET TRAFFIC STUDIES, LTD.
400 Crady Hwy., N.W.
Glen Burnie, MD 21061
Ph (410) 590-5500
Fax (410) 590-6637
5996.dgn

APPROVALS

TEAM LEADER	
ASST. DIV. CHIEF	
DIVISION CHIEF	
OFFICE DIRECTOR	

ORIGINAL ON FILE

REVISIONS

9-22-11 ASBUILT, ADD VIDEO DETECTION
TIMS NO. K926 CONTRACT NO. JX6565185
RRZ
B NEW LEFT TURN LANE ON 9/2006
TEMPLE HILL RD
PRINCE GEORGE'S CO. CONTRACT NO. 746-H(18)
A ASBUILT 9/1981
CONTRACT NO. P-750-509-385

SHA STATE OF MARYLAND
DEPARTMENT OF TRANSPORTATION
STATE HIGHWAY ADMINISTRATION

MD 223 (PISCATAWAY RD) AND TEMPLE HILL ROAD
CLINTON, MARYLAND

TRAFFIC SIGNAL PLAN

SCALE 1" = 20' DATE JUNE 1981 CONTRACT NO. P750-509-385

DESIGNED BY D.J. WALLACE COUNTY PRINCE GEORGES
DRAWN BY T.D.L. ROBERGE LOGMILE 16022305.26
CHECKED BY J.M. WALLACE TIMS NO. H595
F.A.P. NO. TOD NO.

TS NO. 1826C DRAWING NO. 1 OF 2 SHEET NO. OF

... 10/000 5/25/05 9:58:56 AM 9/22/2011 2:41:59 PM