
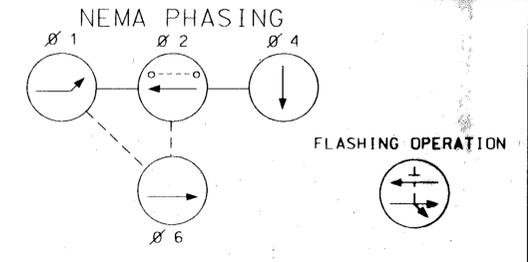


F.H.W.A. REGION NO.	STATE	FED. AD PROJ. NO.	SHEET NO.	TOTAL SHEETS
3	MD.	SEE TITLE SHEET		




12" SIGNALS

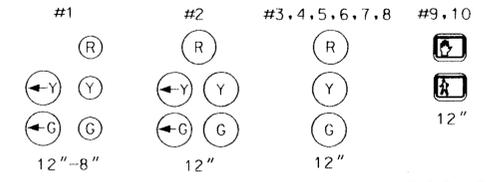

1. PHASES ASSOCIATED WITH DASHED LINES WILL OPERATE CONCURRENTLY.
2. PHASES ASSOCIATED WITH SOLID LINES WILL NOT OPERATE CONCURRENTLY.

NOTE:

1. "D.O." INDICATES DELAY OUTPUT LOOP DETECTOR.
2. PAVEMENT MARKINGS DETAILED ARE PROPOSED AND ARE TO BE INSTALLED BY THE CONTRACTOR IN ACCORDANCE WITH SHA STANDARDS. PAVEMENT MARKINGS ARE TO BE INSTALLED AFTER COMPLETION OF RAMP "A" CONSTRUCTION.
3. LOOP DETECTORS AND CONDUIT SHALL BE INSTALLED PRIOR TO THE INSTALLATION OF PAVEMENT MARKINGS.
4. REVISION 2 © IS A REVISION TO THE TRAFFIC SIGNAL BUILT IN SEPTEMBER, 1973 UNDER CONTRACT SHA NO. P-400-000-385 AND REVISED IN MAY, 1991 UNDER CONTRACT SHA NO. P-538-802-312

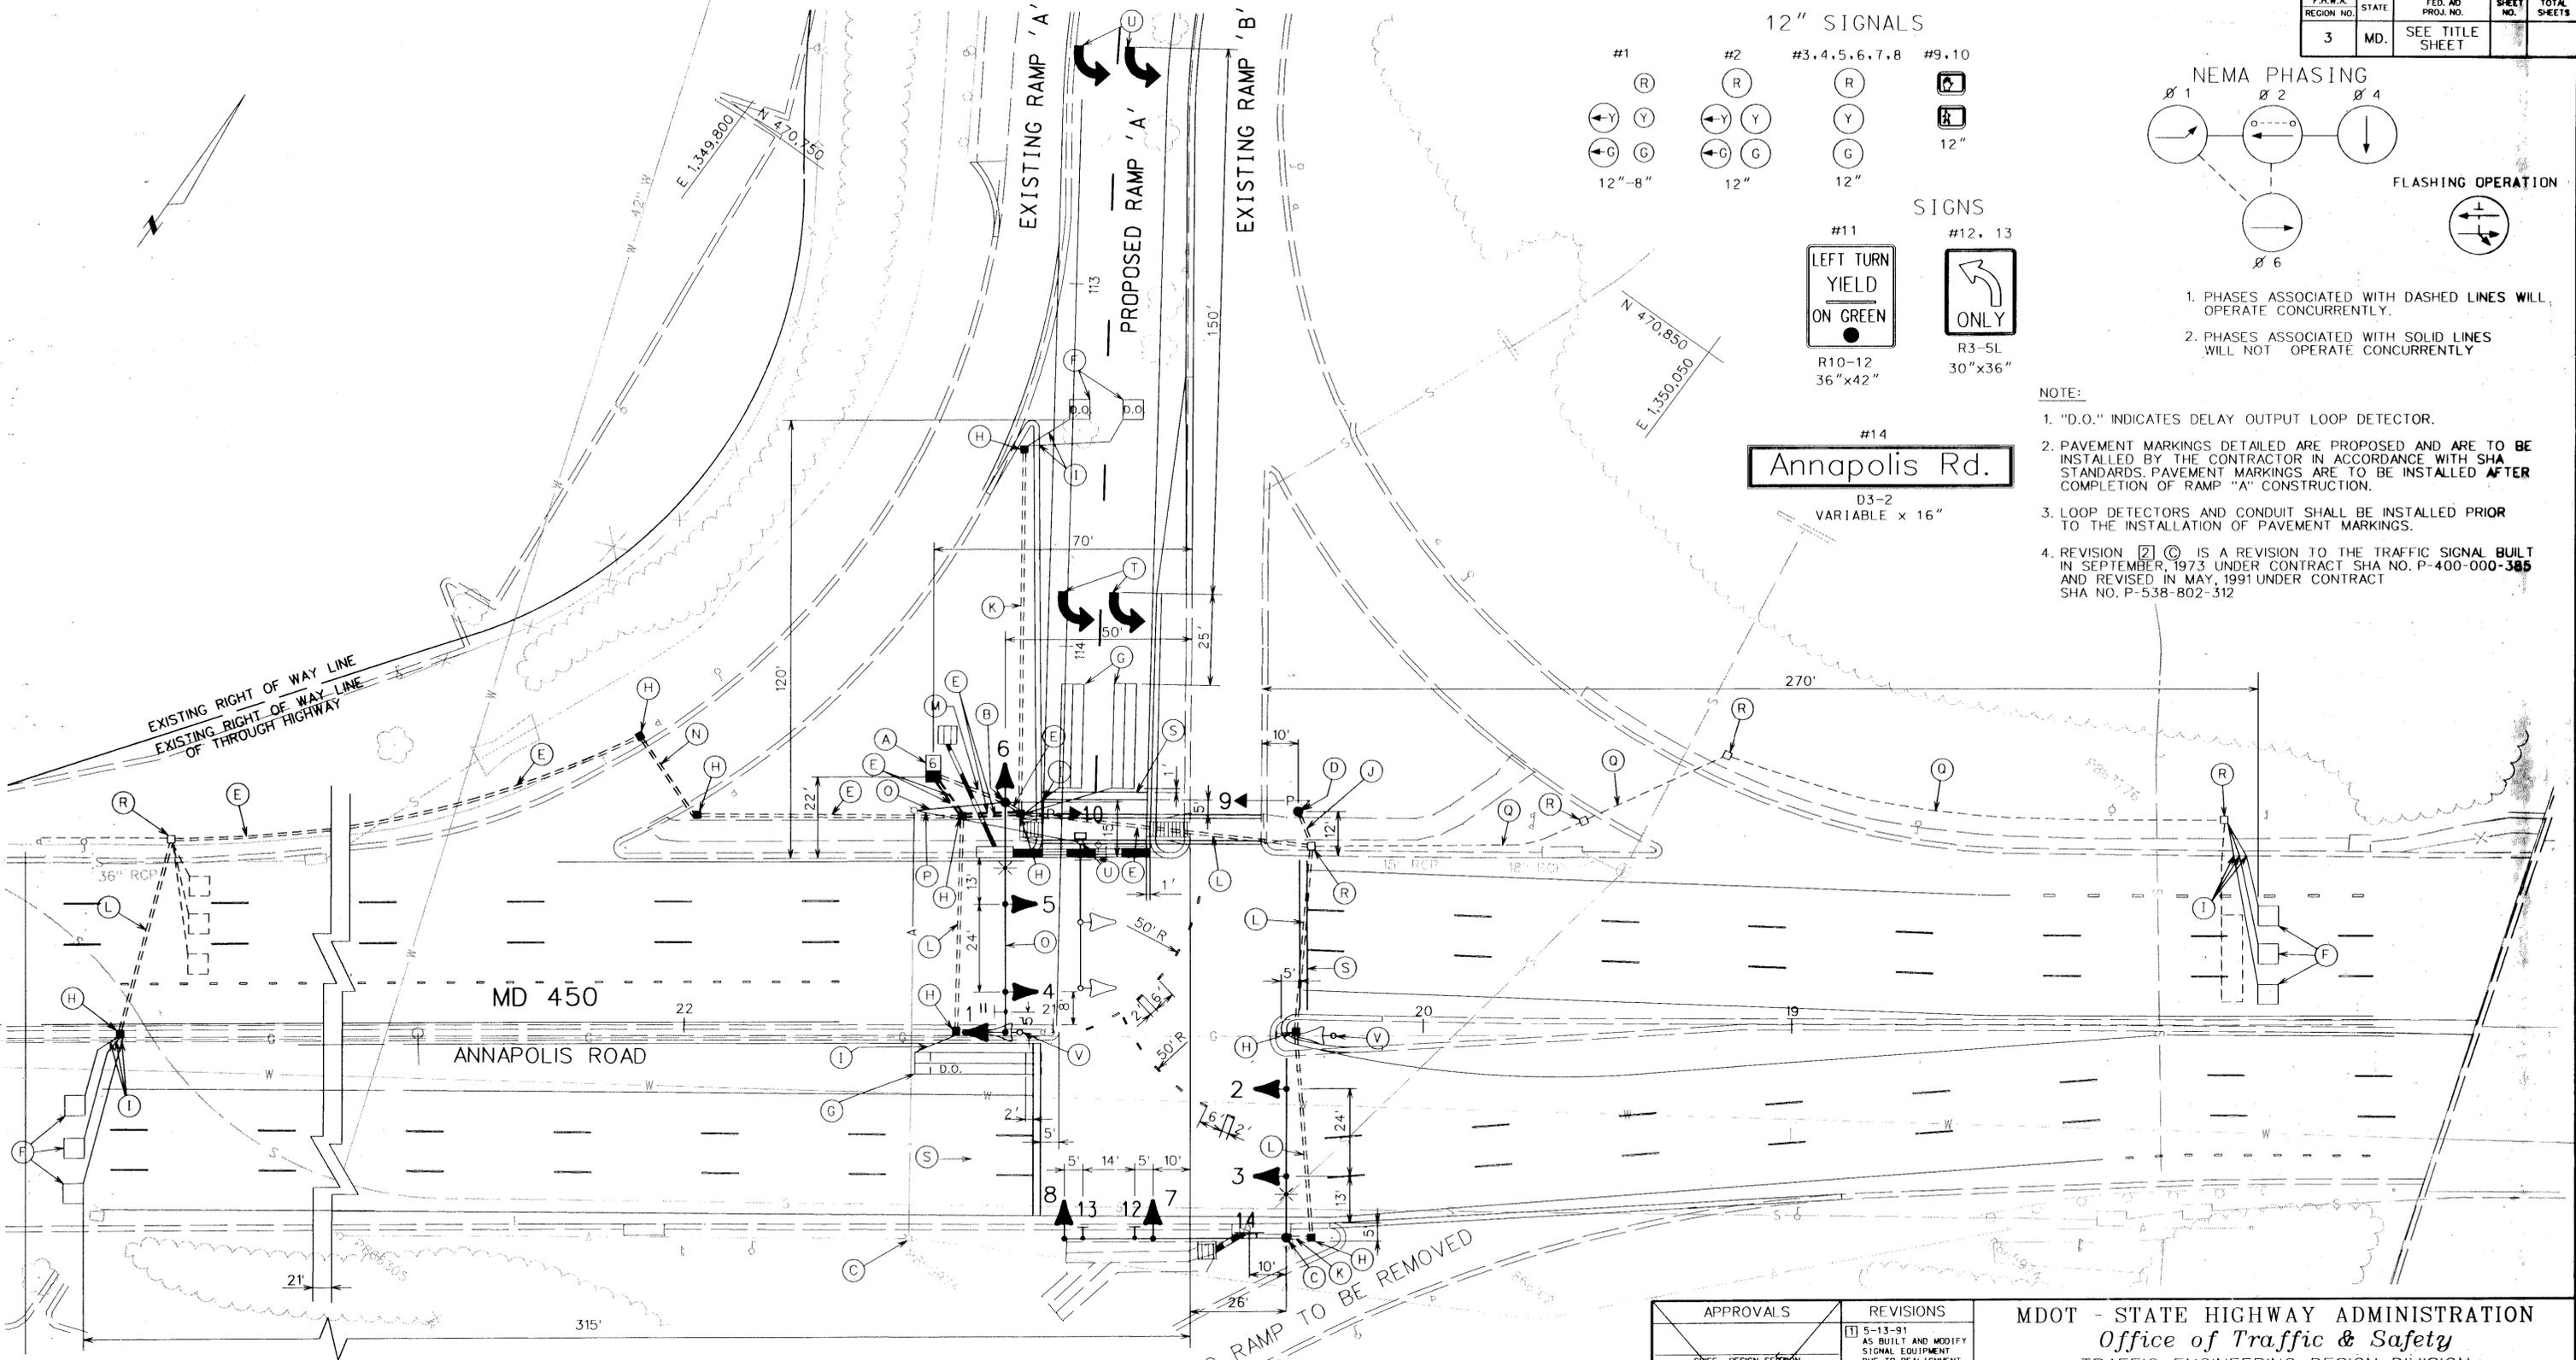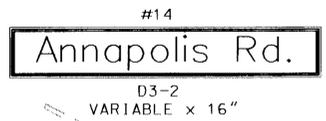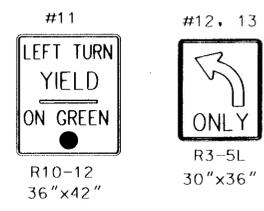

UTILITY LEGEND

—G—	—G—	GAS MAIN
—W—	—W—	WATER MAIN
—S—	—S—	SEWER MAIN
—A—	—A—	AERIAL CABLES

CENTURY ENGINEERING, INC.
 CONSULTING ENGINEERS - PLANNERS
 32 WEST ROAD
 TOWSON, MARYLAND 21204

APPROVALS	REVISIONS
CHIEF, DESIGN SECTION ASST. DISTRICT ENGINEER, TRAFFIC CHIEF, TRAFFIC ENGINEERING DESIGN DIVISION DEPUTY CHIEF ENGINEER, TRAFFIC	1 5-13-91 AS BUILT AND MODIFY SIGNAL EQUIPMENT DUE TO REALIGNMENT OF MEDIAN SHA 538-802-312 2 © 1-95 MODIFY SIGNAL EQUIPMENT DUE TO CONSTRUCTION OF 1-95 SB OFF RAMP "A" SHA P 223-501-377 RWH/1/1/95

MDOT - STATE HIGHWAY ADMINISTRATION <i>Office of Traffic & Safety</i> TRAFFIC ENGINEERING DESIGN DIVISION SIGNAL # 16045004.69			
DRAWN BY: _____ DES. BY: _____ CHK. BY: _____	MD 450 AND I-95 SB RAMPS COUNTY: _____	STD. NO.: _____	FILE NO.: 953 C SHEET NO. _____ OF _____
DATE: 6-15-73 SCALE: 1"=20'	F.A.P. NO. U-931-1 (2) S.H.A. NO. 420-000-385		

16045004.69