


DRILL HOLES

DRILL HOLES

DRILL HOLES

ORDER REV DATE: June 1, 2004

BY: \$USER\$

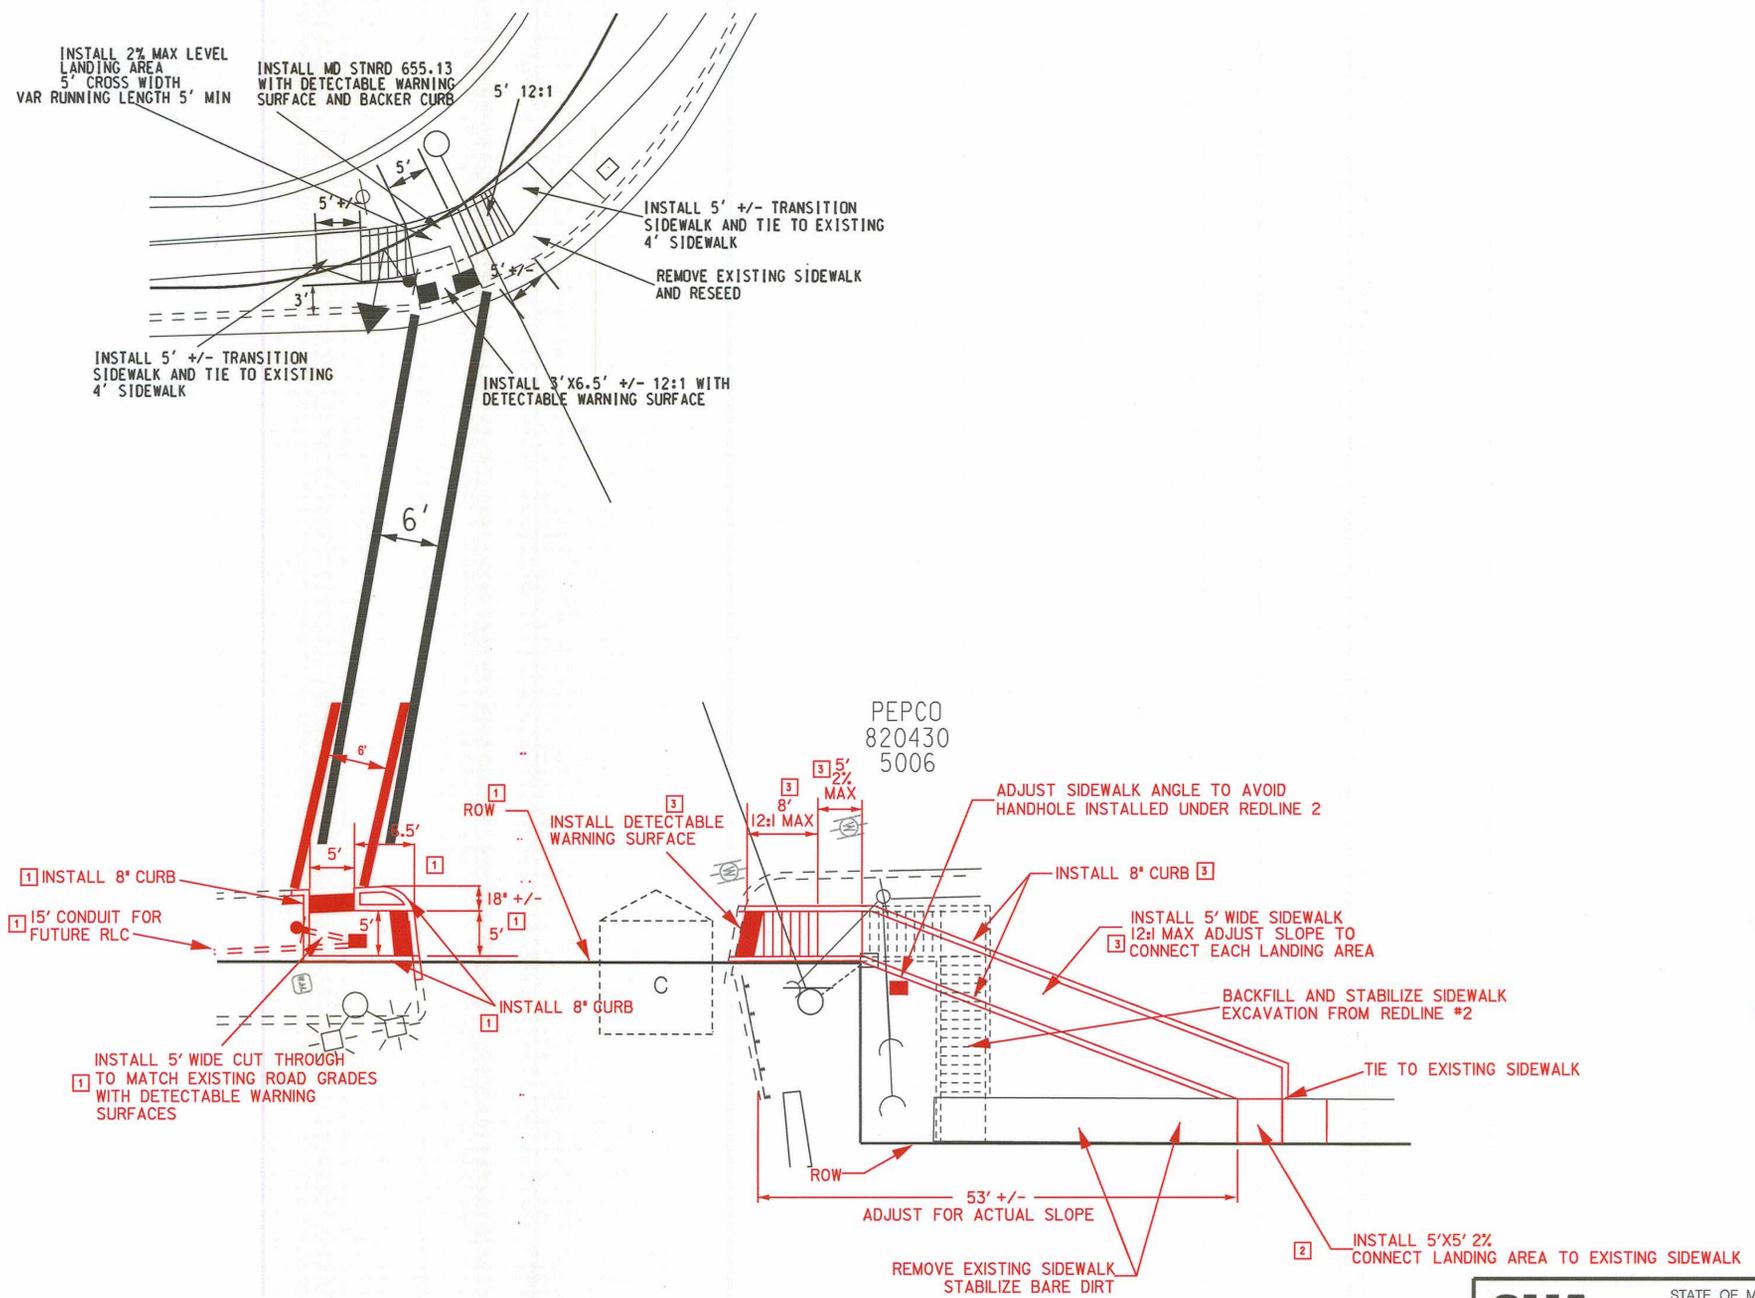

3 REDLINE 3 APPROVED: *[Signature]* 53.13
 MICHAEL PAYLOR, P.E., CHIEF, TEDD

2 REDLINE 2 APPROVED: ON FILE
 DENNIS DODA, TEDD TEAM LEADER

1 REDLINE 1 APPROVED: ON FILE
 DENNIS DODA, TEDD TEAM LEADER

SHA STATE OF MARYLAND DEPARTMENT OF TRANSPORTATION STATE HIGHWAY ADMINISTRATION OFFICE OF TRAFFIC & SAFETY TRAFFIC ENGINEERING DESIGN DIVISION US 1 (BALTIMORE AVENUE) @ CHERRY HILL ROAD COLLEGE PARK, MARYLAND					
		GENERAL INFORMATION SHEET			
SCALE	1" = 20'	ADVERTISED DATE	2/2012	CONTRACT NO.	XX6555185
DESIGNED BY	C STRAIN	COUNTY	PRINCE GEORGE'S		
DRAWN BY	C STRAIN	LOGMILE	16000106.15		
CHECKED BY	D DODA	TIMS NO.	J426		
F.A.P. NO.	SEE TITLE SHEET	TOD NO.			
TS NO.	534J	DRAWING	G1-1	OF 1	SHEET NO. 2 OF 3

PLOTTED: 5/24/2012 10:55 AM
FILE: SFILES