



F.H.W.A. REGION NO.	STATE	FED. AID PROJ. NO.	SHEET NO.	TOTAL SHEETS
3	MD.		2	5

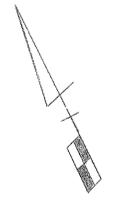

SIGNALS
 1-4 (Y)
 5-8 (R)

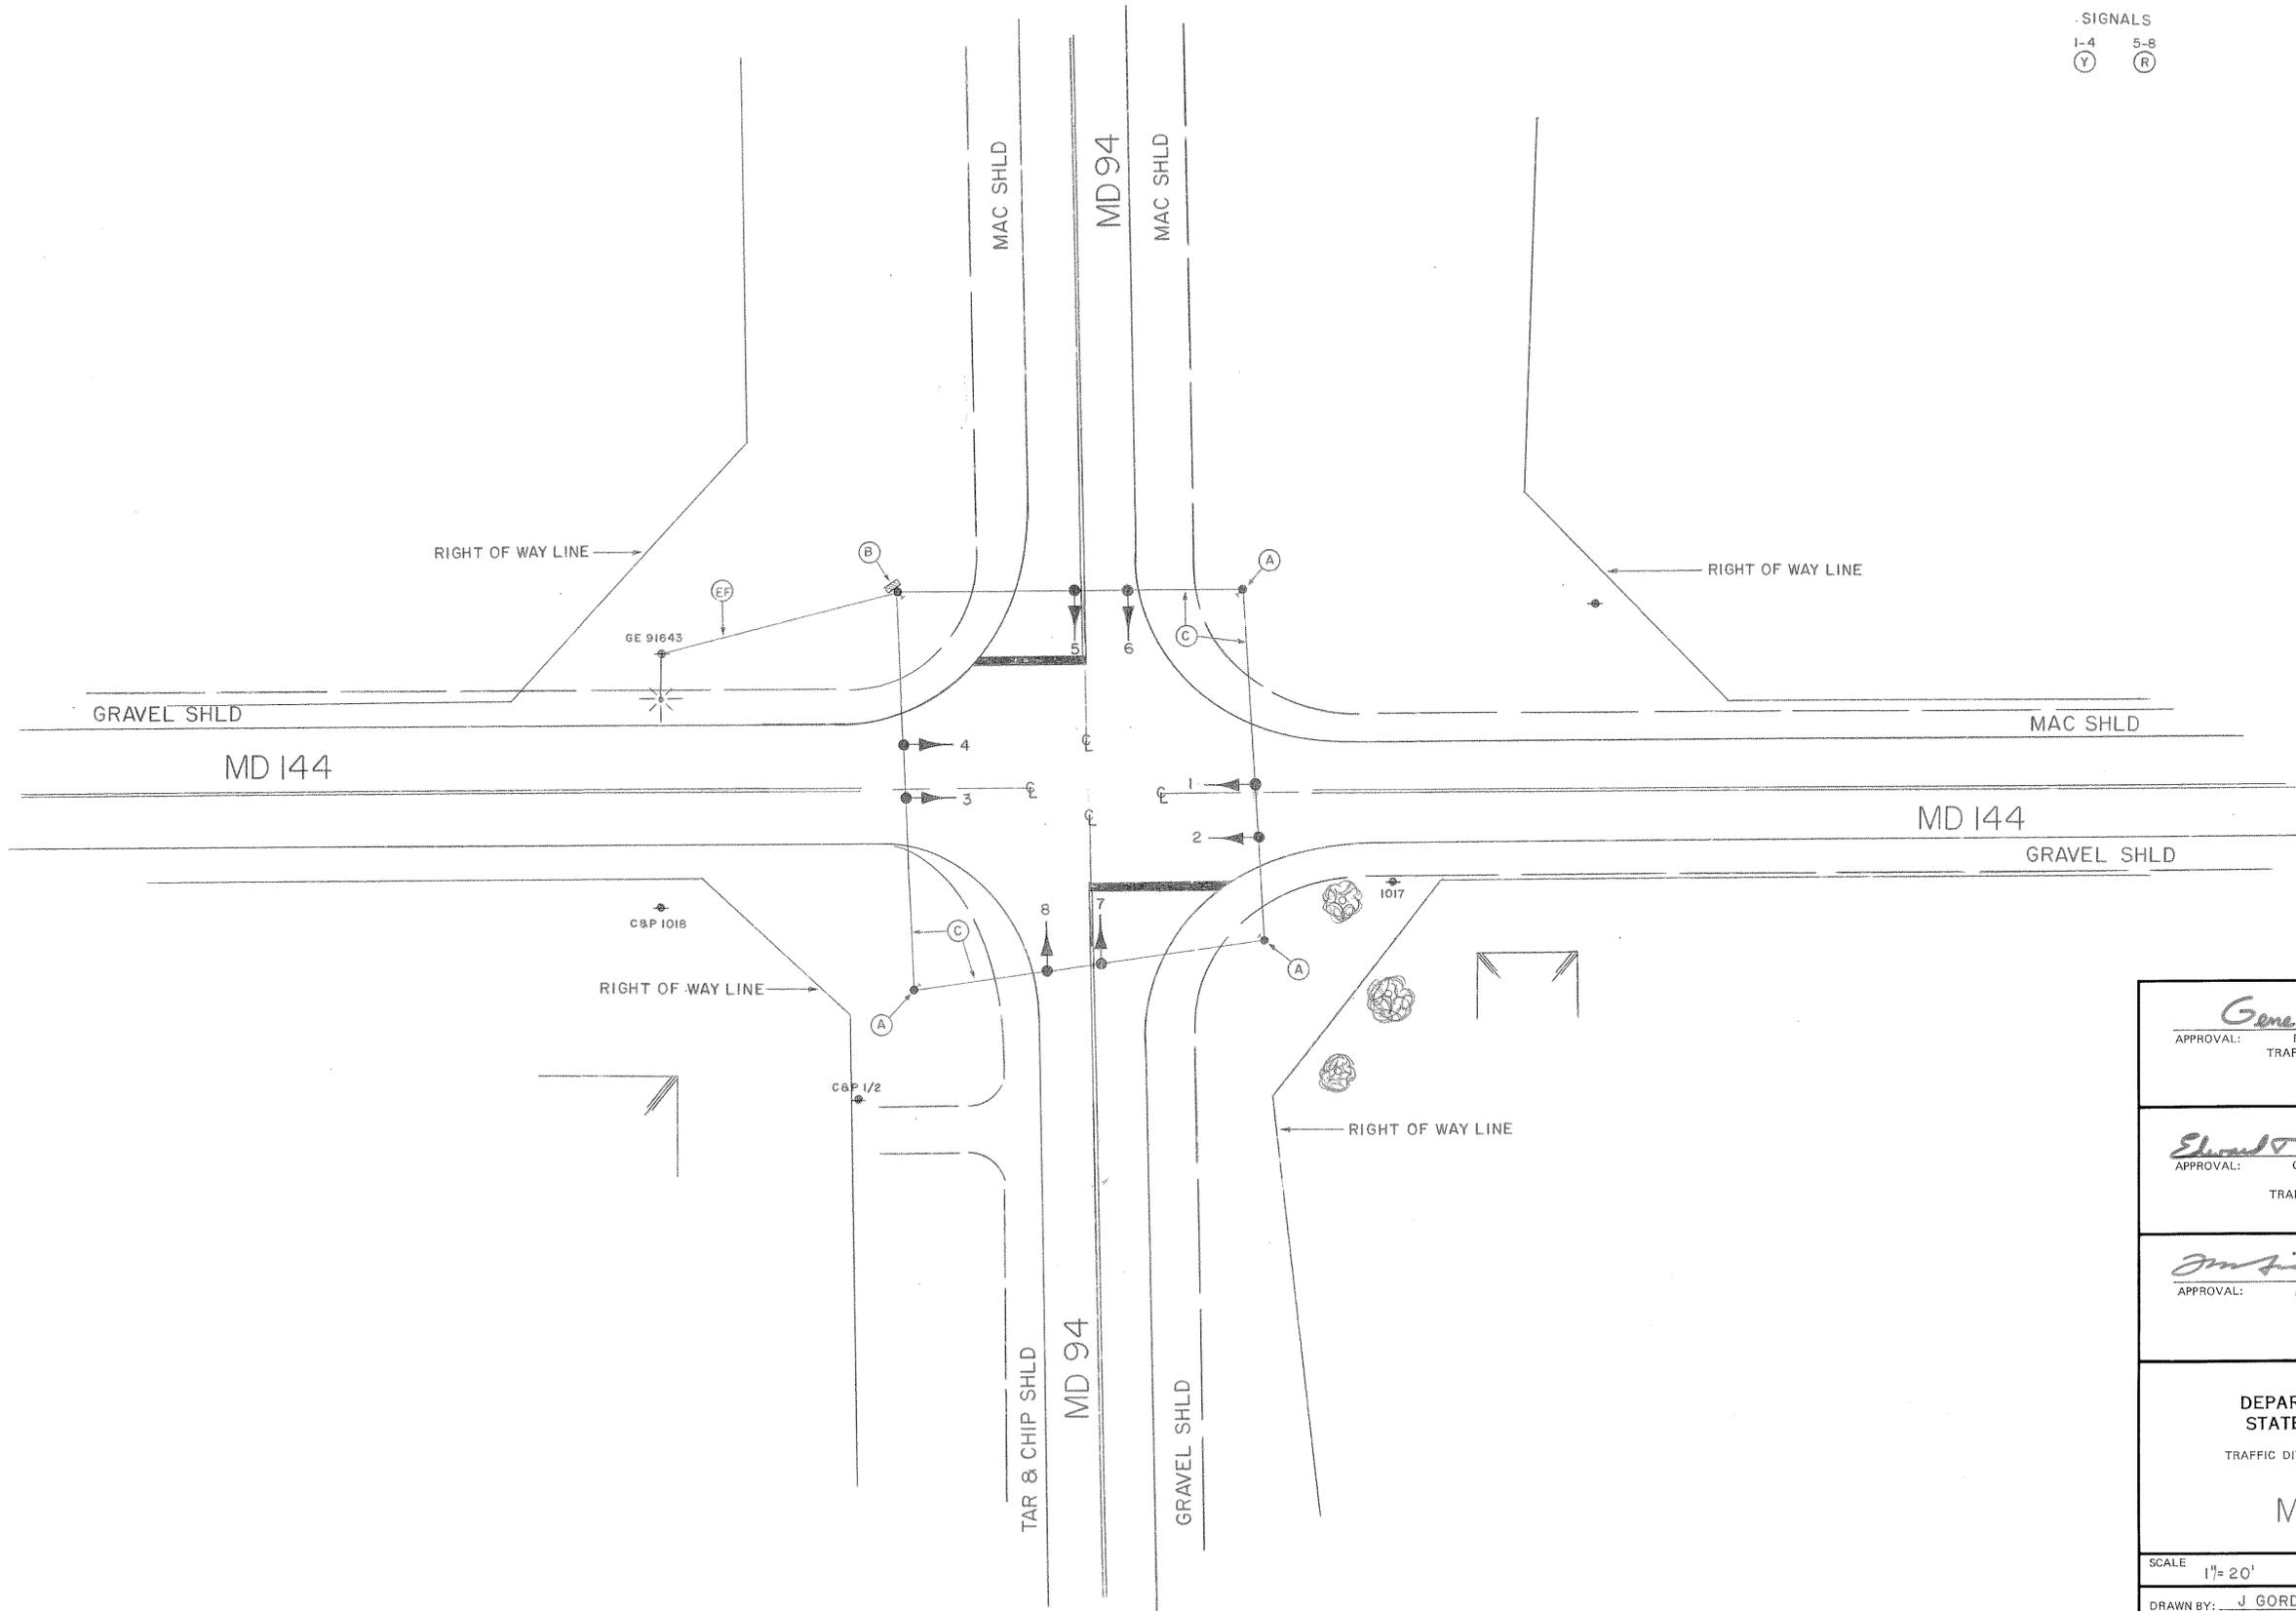

APPROVAL: *Gene R. Straub (as)*
 REGIONAL TRAFFIC ENGINEER

APPROVAL: *Edward J. Parker 4/29/77*
 CHIEF-BUREAU OF TRAFFIC ENGINEERING

APPROVAL: *Jim Smith 4/29/77*
 ASST. CHIEF ENGINEER TRAFFIC

ASBUILT 11/27/79

PJK / *[Signature]*

REVISIONS

STATE OF MARYLAND
 DEPARTMENT OF TRANSPORTATION
 STATE HIGHWAY ADMINISTRATION
 TRAFFIC DIVISION - BUREAU OF TRAFFIC ENGINEERING

MD 144 & MD 94

SCALE 1" = 20' DATE 4-19-77 CONTRACT NO. HO-531-501-785

DRAWN BY: J GORDON COUNTY: HOWARD

DESIGNED BY: *J. Gordon* SIGNAL NO.:

CHECKED BY: *Alfred D. Budnick 4-22-77* DRAWING NO. TS-1507A