

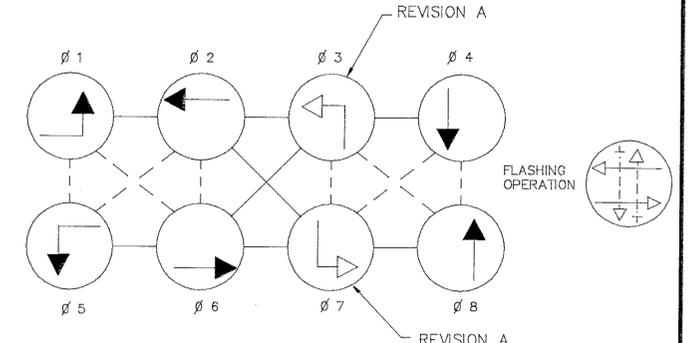
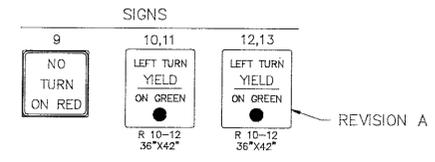


F.H.W.A. REGION NO.	STATE	FED. AID PROJ. NO.	SHEET NO.	TOTAL SHEETS
3	MD.			

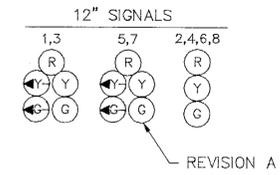

PHASES ASSOCIATED BY A DASHED LINE WILL OPERATE CONCURRENTLY
 PHASES ASSOCIATED BY A SOLID LINE WILL NOT OPERATE CONCURRENTLY

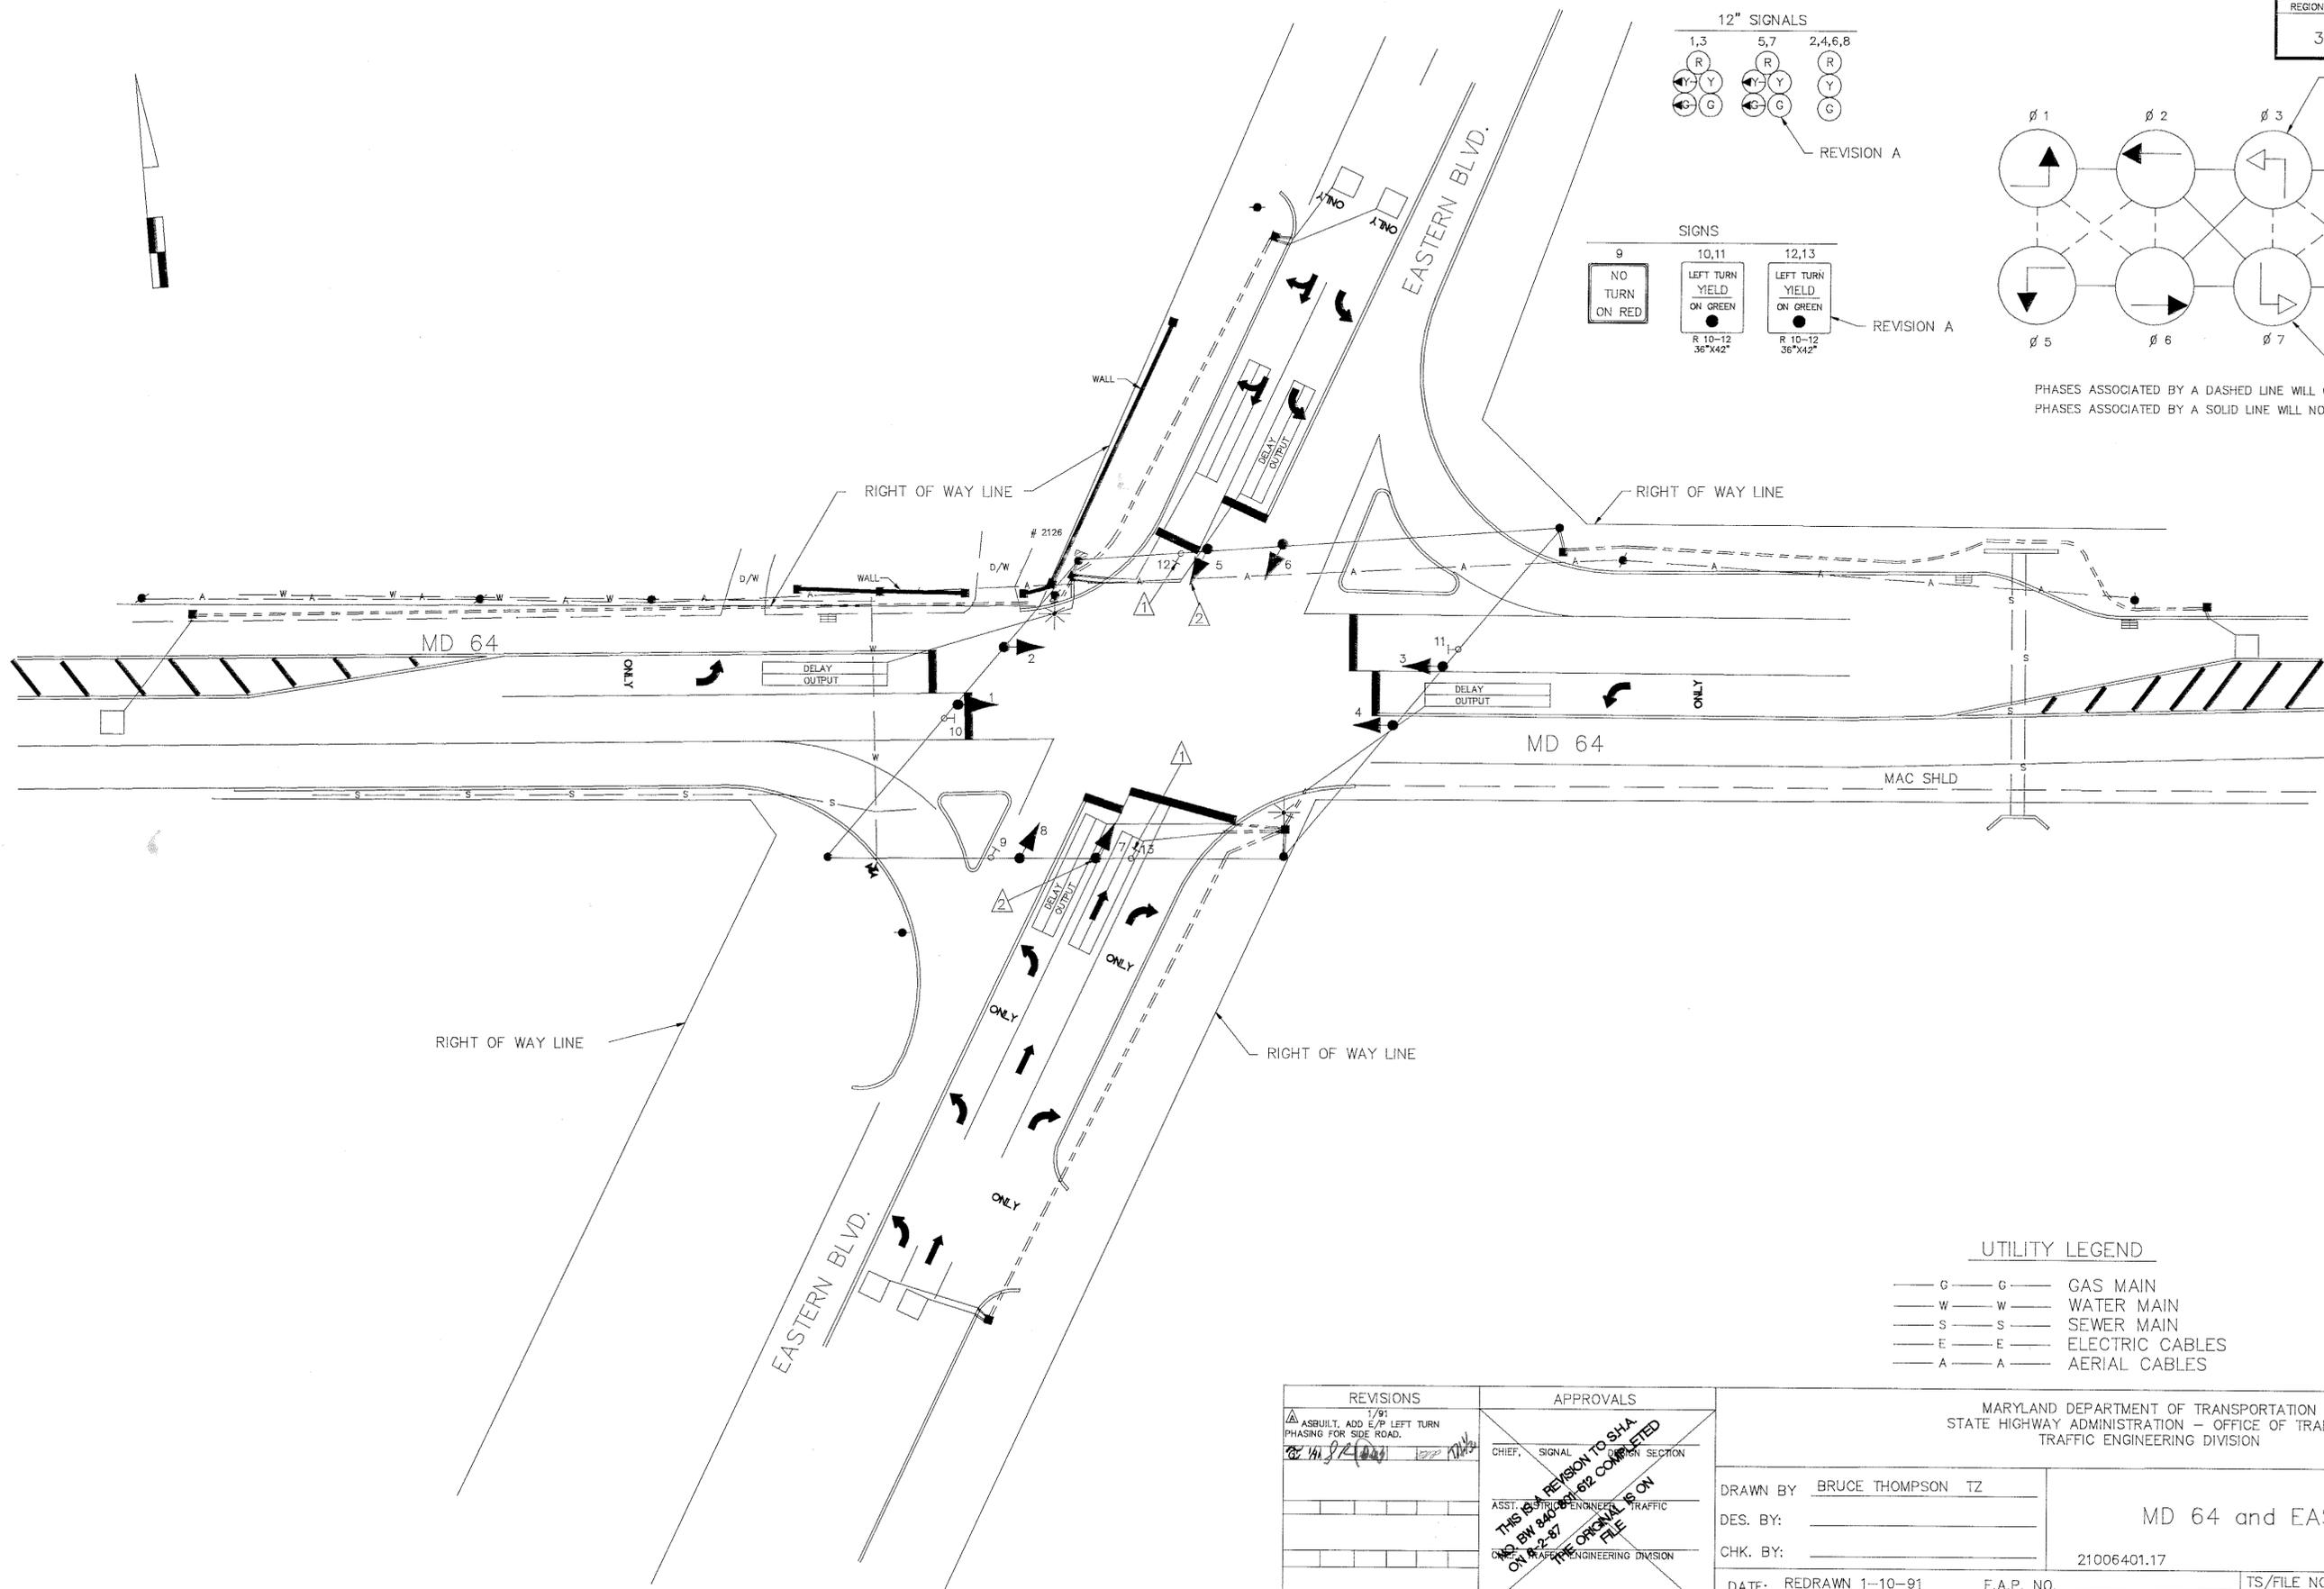

UTILITY LEGEND

- G — G — GAS MAIN
- W — W — WATER MAIN
- S — S — SEWER MAIN
- E — E — ELECTRIC CABLES
- A — A — AERIAL CABLES

<p>REVISIONS</p> <p>1/91 ASBUILT, ADD E/P LEFT TURN PHASING FOR SIDE ROAD. <i>TS</i> <i>1/91</i></p>		<p>APPROVALS</p> <p>CHIEF, SIGNAL SECTION <i>[Signature]</i></p> <p>ASST. TRAFFIC ENGINEER, TRAFFIC SECTION <i>[Signature]</i></p> <p>DEPUTY CHIEF ENGINEER, OFFICE OF TRAFFIC</p>		<p>MARYLAND DEPARTMENT OF TRANSPORTATION STATE HIGHWAY ADMINISTRATION — OFFICE OF TRAFFIC TRAFFIC ENGINEERING DIVISION</p>	
<p>DRAWN BY: BRUCE THOMPSON TZ</p> <p>DES. BY:</p> <p>CHK. BY:</p>		<p>DATE: REDRAWN 1-10-91</p> <p>SCALE: 1"=20'</p>		<p>MD 64 and EASTERN BLVD.</p> <p>21006401.17</p> <p>COUNTY: WASHINGTON</p>	
		<p>F.A.P. NO.</p> <p>S.H.A. NO.</p>		<p>TS/FILE NO. 2123 A</p> <p>SHEET NO. OF</p>	

THIS IS A REVISION TO SHA
 NO. BW 840 BY #12 COMPLETED
 ON 8-2-87
 THE ORIGINAL IS ON FILE

21006401.17