
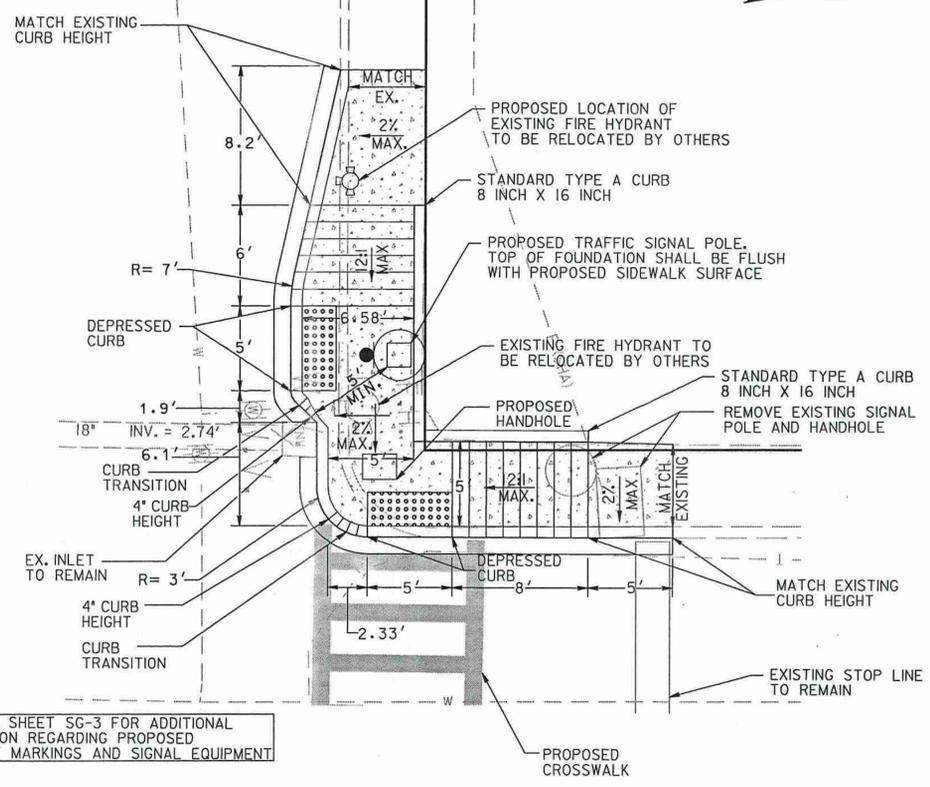


STANDARD TYPE A COMBINATION CURB AND GUTTER 12 INCH GUTTER PAN 8 INCH DEPTH SHA STD. NO. MD-620.02	
LOCATION	QUANTITY (LF)
NORTHWEST QUADRANT	72

5 INCH CONCRETE SIDEWALK	
LOCATION	QUANTITY (SF)
NORTHWEST QUADRANT	229

DETECTABLE WARNING SURFACE SHA STD. NO. MD-655.40	
LOCATION	QUANTITY (SF)
NORTHWEST QUADRANT	20

TRAVERSE CONTROL POINT 501
N 289,112.0776
E 1,869,850.0621
ELEV. 6.39

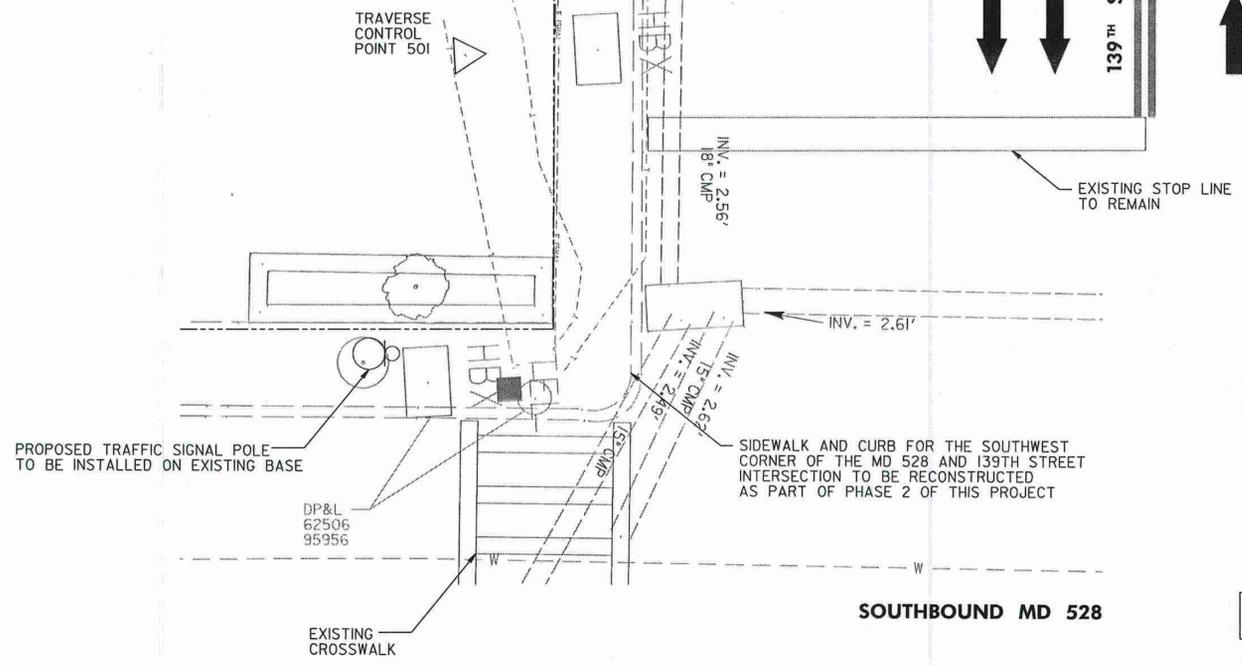

NOTE: SEE SHEET SG-3 FOR ADDITIONAL INFORMATION REGARDING PROPOSED PAVEMENT MARKINGS AND SIGNAL EQUIPMENT

GENERAL NOTES

- FOR 5 INCH CONCRETE SIDEWALK RECONSTRUCTION, SEE TYPICAL SECTION, SEE SHEET DE-03.
- ALL DIMENSIONS ARE APPROXIMATE. CONTRACTOR TO VERIFY ALL DIMENSIONS IN THE FIELD.
- NO DISTURBED AREA SHALL BE LEFT UNSTABILIZED OVERNIGHT UNLESS THE RUNOFF IS DIRECTED TO AN APPROVED SEDIMENT CONTROL DEVICE.
- SIDEWALK RECONSTRUCTION LIMITS SHALL COINCIDE WITH CRACK CONTROL JOINTS (JOINTER GROOVES) OR EXPANSION JOINTS IN EXISTING SIDEWALK. NEW EXPANSION JOINTS SHALL BE PROVIDED AT THE INTERFACE OF EXISTING AND PROPOSED SIDEWALK. SEE SHA. STD. NO. MD-655.01.
- INSTALL DETECTABLE WARNING SURFACE ON SIDEWALK RAMP AS PER SHA. STD. NO. MD-655.40.
- FORM NEW SIDEWALK AND EXPANSION JOINT MATERIAL AROUND EX. UTILITY POLES, MANHOLE COVERS, VALVE COVERS, AND FIRE HYDRANTS AS NECESSARY.
- RESET ANY SIGNS DISTURBED BY THE CONSTRUCTION AS DIRECTED BY THE ENGINEER.
- EXISTING INLETS SHALL NOT BE DAMAGED DURING CONSTRUCTION. DAMAGE TO THE INLETS WILL REQUIRE THE INLET TO BE REPLACED AT NO ADDITIONAL COST TO THE ADMINISTRATION.
- EXISTING TREES, SHRUBS, AND THEIR RESPECTIVE ROOT SYSTEMS SHALL NOT BE DISTURBED DURING CONSTRUCTION.

LEGEND

- CONCRETE PAVEMENT
- DETECTABLE WARNING SURFACE

SHA STATE OF MARYLAND
DEPARTMENT OF TRANSPORTATION
STATE HIGHWAY ADMINISTRATION
OFFICE OF TRAFFIC & SAFETY
TRAFFIC ENGINEERING DESIGN DIVISION

**MD 528 (COASTAL HIGHWAY) AT 139 ST.
OCEAN CITY, MD.**

RK&K
RUMMEL, KLEPPER & KAHL, LLP
81 MOSHER STREET | BALTIMORE, MD 21217
PH: (410) 728-2900 FAX: (410) 728-3160

Engineers | Construction Managers | Planners | Scientists
www.rk.com

REVISIONS
1 REDLINE NO. 1 05/03/2010 INSERT SHEET

RAMP DETAILS			
SCALE 1" = 5'	DATE APRIL 2010	CONTRACT NO. XX4435185	
DESIGNED BY JDG	COUNTY WORCESTER		
DRAWN BY JBB	LOGMILE		
CHECKED BY ATD	TIMS NO. K186		
FAP NO.	TOD NO.		
TS NO. 2316B-DE	DRAWING DE-02	OF 3	SHEET NO. 6 OF 7

BY: wwiesmantel