

PROJECT DESCRIPTION

THIS PROJECT INVOLVES RECONSTRUCTION OF THE TRAFFIC SIGNAL AT THE INTERSECTION OF MD 528 & 139TH STREET INCLUDING APS PUSHBUTTONS, LED COUNTDOWN PEDESTRIAN SIGNAL HEADS, LED TRAFFIC SIGNAL HEADS AND VIDEO DETECTION. MD 528 IS ASSUMED TO RUN IN A NORTH-SOUTH DIRECTION.

INTERSECTION OPERATION

THIS INTERSECTION WILL OPERATE IN A NEMA SIX-PHASE FULL-TRAFFIC-ACTUATED MODE WITH ALTERNATE PEDESTRIAN PHASES FOR THE NORTH AND SOUTH LEGS OF THE INTERSECTION. THE MD 528 LEFT TURNS OPERATE IN EXCLUSIVE-PERMISSIVE PHASING.

CONTROLLER REQUIREMENTS

A FULL-TRAFFIC-ACTUATED EIGHT PHASE TRAFFIC SIGNAL CONTROLLER WITH TELEMETRY CABLE HOUSED IN A BASE MOUNTED CABINET SHALL BE FURNISHED BY SHA AND INSTALLED BY THE CONTRACTOR. VIDEO DETECTION INTERFACE EQUIPMENT SHALL BE FURNISHED BY SHA. AN APS CENTRAL CONTROL UNIT SHALL BE FURNISHED BY THE CONTRACTOR AND INSTALLED BY SHA.

SPECIAL NOTES

APS WILL FUNCTION AS FOLLOWS:

- A. WHEN PEDESTRIAN LOCATES AND PRESSES PUSHBUTTON FOR AN EXTENDED TIME, THE PUSHBUTTON UNIT MESSAGE WILL BE "WAIT TO CROSS COASTAL HIGHWAY AT 139TH."
- B. WHEN WALK PHASE BEGINS, THE MESSAGE WILL BE A RAPID TICK WHICH WILL LAST FOR THE DURATION OF THE WALK PHASE.

CONTACT PERSONS FOR DISTRICT #1 ARE AS FOLLOWS:

- MR. GENE COFIELL
ASSISTANT DISTRICT ENGINEER-TRAFFIC
PHONE: (410) 677-4040
- MR. BRUCE POOLE
DISTRICT UTILITY ENGINEER
PHONE: (410) 677-4082
- MR. TERRY MCGEAN
TOWN OF OCEAN CITY - CITY ENGINEER
PHONE: (410) 289-8845
- MR. RICHARD L. DAFF, SR.
CHIEF, TRAFFIC OPERATIONS
DIVISION
PHONE: (410)787-7630
- MR. ED RODENHIZER
CHIEF, SIGNAL OPERATIONS
PHONE: (410)787-7650
- MR. GREG HOLSEY
ASSISTANT DISTRICT ENGINEER - CONST.
PHONE: (410) 677-4020
- MR. JAMES WRIGHT
ASSISTANT DISTRICT ENGINEER - MAINT.
PHONE: (410) 677-4010
- MR. ROBERT SNYDER
ASSISTANT DIVISION CHIEF
TRAFFIC OPERATIONS
PHONE: (410)787-7630
- MR. EUGENE BAILEY
CHIEF, SIGN OPERATIONS
PHONE: (410)787-7676
- MR. JOHN GOVER
OFFICE OF HIGHWAY DESIGN
PHONE: (410) 545-8766

CONTACT PERSONS FOR OOTS ARE AS FOLLOWS:

EQUIPMENT LIST "A"

A. EQUIPMENT TO BE SUPPLIED BY THE SHA.

ITEM NO.	DESCRIPTION	UNIT	QUANTITY
9042	CONTROLLER ASC II WITH TELEMETRY	EA	1
9044	CONTROLLER CABINET, SIZE 6	EA	1
9086	VIDEO DETECTION INTERFACE EQUIPMENT: 1-4 CAMERAS	EA	1
9571	SHEET ALUMINUM MAST ARM / POLE MOUNTED SIGN 4 - D-3(1) (72"x16") 4 - R10-3(1) (9"x15")	SF	36

WIRING KEY

Q,R,S,T	2-CONDUCTOR ELECTRICAL CABLE (NO. 14 AWG)	Y,AA	12-PAIR COMMUNICATION CABLE (NO. 19 AWG) SELF-SUPPORTING OVERHEAD
C,F,I,L, M,N,O,P	5-CONDUCTOR ELECTRICAL CABLE (NO. 14 AWG)	PF	RELOCATED OVERHEAD POWER SERVICE BY DELMARVA
A,B,D,E, G,H,J,K	7-CONDUCTOR ELECTRICAL CABLE (NO. 14 AWG)	Z	STRANDED BARE COPPER GROUND WIRE (NO. 6 AWG)
BB	1-CONDUCTOR ELECTRICAL CABLE (NO. 4 AWG) 3 RUNS	+	PROPOSED GROUND ROD
U,V,W,X	VIDEO DETECTION CAMERA CABLE		


EQUIPMENT LIST "B"

B. EQUIPMENT TO BE FURNISHED AND/OR INSTALLED BY THE CONTRACTOR.

ITEM NO.	DESCRIPTION	UNIT	QUANTITY
1003	MAINTENANCE OF TRAFFIC	EA	3
2002	TEST PIT EXCAVATION	CY	5
5005	REMOVAL OF EXISTING PERMANENT PAVEMENT LINE MARKINGS ANY WIDTH	LF	1035
5006	F & I 12" WHITE PREFORMED THERMOPLASTIC PAVEMENT MARKING LINES	LF	1000
5007	F & I 24" WHITE PREFORMED THERMOPLASTIC PAVEMENT MARKING LINES	LF	30
6001	F & I STANDARD TYPE A COMBINATION CURB AND GUTTER 12" GUTTER PAN 8" DEPTH	LF	262
6002	F & I 5" CONCRETE SIDEWALK	SF	1167
6003	F & I DETECTABLE WARNING SURFACE FOR CURB RAMPS	SF	88
8001	F & I 2 WIRE CENTRAL CONTROL UNIT	EA	1
8004	ADJUST EXISTING HANDHOLE TO GRADE INCLUDING COLLAR	EA	1
8007	F & I AUDIBLE/TACTILE PEDESTRIAN PUSHBUTTON STATION & SIGNS	EA	4
8008	F & I BREAKAWAY PEDESTAL POLE (ANY SIZE)	EA	3
8021	REMOVE & DISPOSE MATERIAL AND EQUIPMENT PER ASSIGNMENT	EA	1
8024	F & I TWIN MAST ARM POLE & 50'/70' MAST ARMS ANY 'T' DIMENSION	EA	2
8025	F & I VIDEO DETECTION CAMERA AND CABLE UP TO 500'	EA	4
8032	F & I SCHEDULE 80 RIGID PVC CONDUIT UP TO 4" - BORED	LF	270
8034	F & I SCHEDULE 80 RIGID PVC CONDUIT UP TO 4" - TRENCHED	LF	110
8035	F & I WOOD SIGN SUPPORTS UP TO 4 X 6	LF	60
8036	INSTALL OVERHEAD OR GROUND MOUNTED SIGN (INCLUDING ALL HARDWARE)	SF	36
8038	F & I NO. 6 AWG STRANDED BARE COPPER GROUND WIRE	LF	400
8040	F & I WEATHER HEAD, 3"	EA	1
8042	F & I ELECTRICAL UTILITY SERVICE EQUIPMENT 120/240 VOLTS 60 AMPS	EA	1
8043	F & I ELECTRICAL CABLE - 1 CONDUCTOR NO. 4 AWG - THHN/THWN	LF	90
8045	F & I ELECTRICAL HANDHOLE	EA	1
8050	F & I 12" LED VEHICULAR TRAFFIC SIGNAL HEAD SECTION	EA	6
8052	CUT, CLEAN, GALVANIZE AND CAP TRAFFIC SIGNAL STRUCTURE	EA	2
8054	F & I ELECTRICAL CABLE - 2 CONDUCTOR (NO. 14 AWG)	LF	570
8056	F & I ELECTRICAL CABLE - 5 CONDUCTOR (NO. 14 AWG)	LF	700
8057	F & I ELECTRICAL CABLE - 7 CONDUCTOR (NO. 14 AWG)	LF	1770
8065	INSTALL CONTROLLER AND CABINET - BASE MOUNT	EA	1
8066-A	12-PAIR COMMUNICATION CABLE, SELF-SUPPORTING (OVERHEAD)	LF	2780
8067-A	RELOCATE EXISTING TRAFFIC SIGNAL (ENTIRE CLUSTER)	EA	10
8068-A	RELOCATE EXISTING PED SIGNAL	EA	4
8071-A	RELOCATE EXISTING SIGNS	EA	7
NEG	RELOCATE PARKING BLOCK	EA	2
NEG	CAP EXISTING INLET	EA	1

EQUIPMENT LIST "C"

C. EQUIPMENT TO BE REMOVED BY THE CONTRACTOR AND DELIVERED TO THE STATE HIGHWAY ADMINISTRATION, 7491 CONNELLEY DRIVE, HANOVER, MARYLAND 21076. SHA FORCES SHALL REMOVE THE CONTROLLER AND ALL AUXILIARY EQUIPMENT FROM THE CONTROLLER CABINET. THE CABINET AND ALL OTHER MATERIALS TO BE REMOVED BY THE CONTRACTOR SHALL BECOME PROPERTY OF THE CONTRACTOR. CONTRACTOR SHALL RETURN ALL VIDEO DETECTION CAMERAS REMOVED FROM THE INTERSECTION TO SHA SIGNAL SHOP.

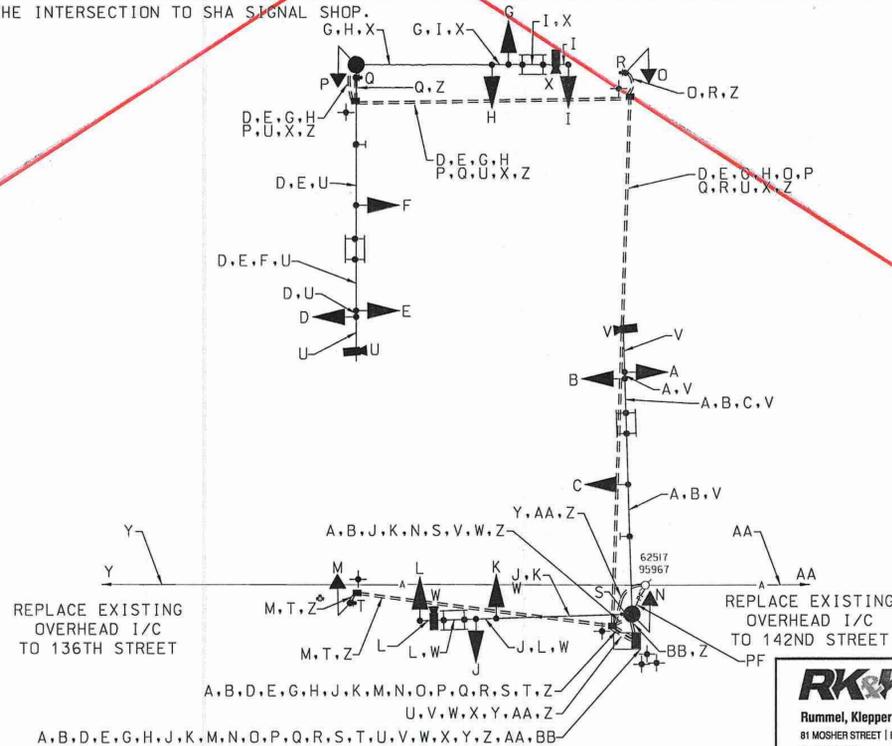

PHASING CHART

NO PHASE CHANGE

GENERAL NOTES

1. ALL EXISTING FOUNDATION TOPS WITHIN EXISTING SIDEWALK SHALL BE REMOVED 2" BELOW SIDEWALK GRADE AND NEW SIDEWALK SHALL BE INSTALLED TO BE FLUSH WITH FINAL GRADE.
2. ALL PROPOSED FOUNDATION TOPS SHALL BE INSTALLED FLUSH WITH SIDEWALK GRADE.
3. ACCESSIBLE PEDESTRIAN CONTROL EQUIPMENT SHALL BE DELIVERED TO THE SHA SIGNAL SHOP FOR TESTING AND PROGRAMMING PRIOR TO INSTALLATION. CONTACT MR. EDWARD RODENHIZER AT 410-787-7652 TO COORDINATE.
4. LOCATION OF ACCESSIBLE PEDESTRIAN SIGNAL PUSHBUTTONS MUST MEET LOCATION REQUIREMENTS OF MUTCD SECTION 4E.09 AND FIGURE 4E.2 AND THE NCHRP PUBLICATION, "ACCESSIBLE PEDESTRIAN SIGNALS: GUIDE TO BEST PRACTICE." IF NOT MET, THE CONTRACTOR IS TO STOP WORK ON PUSHBUTTON LOCATIONS UNTIL A DESIGN WAIVER IS OBTAINED, APPROVED BY THE DIRECTOR, OFFICE OF TRAFFIC AND SAFETY.
5. PUSHBUTTONS ARE TO BE LOCATED SO THAT THEY CAN BE ACTIVATED BY A PERSON IN A WHEELCHAIR REACHING LESS THAN 18" FROM A 60" X 60" LEVEL LANDING AREA WITH A CROSS SLOPE OF LESS THAN OR EQUAL TO 2%.
6. THE 10' SEPARATION BETWEEN PUSHBUTTONS IS TO BE MEASURED FROM FACE OF PUSHBUTTON TO FACE OF PUSHBUTTON, NOT CENTER TO CENTER OF POLE.
7. PUSHBUTTON ARROWS AND SIGNS ARE TO BE ORIENTED PARALLEL TO THE CROSSING FOR WHICH THEY ARE INTENDED.
8. ANY HARDWARE NECESSARY FOR THE INSTALLATION OF RELOCATED TRAFFIC SIGNAL EQUIPMENT SHALL BE INCIDENTAL TO THE PERTINANT RELOCATE PAY ITEM.
9. THE CONTRACTOR SHALL BE RESPONSIBLE FOR TERMINATING ALL SIGNAL CABLE TO THE APPROPRIATE TERMINALS AND PROPERLY LABEL EACH CABLE.
10. THE CONTRACTOR SHALL COORDINATE WITH DISTRICT 1 TRAFFIC TO COORDINATE TRAFFIC SIGNAL TURN OFF AND TEMPORARY STOP CONTROL. CONTRACTOR SHALL VERIFY ANY EVENT OR DATE RESTRICTIONS PRIOR TO TRAFFIC SIGNAL TURN OFF.
11. UNDERGROUND UTILITIES SHOWN ON THESE PLANS ARE SCHEMATIC ONLY AND MAY NOT BE COMPLETE. THE CONTRACTOR SHALL BE RESPONSIBLE FOR NOTIFYING "MISS UTILITY" PRIOR TO CONSTRUCTION SO THAT ALL UTILITIES MAY BE LOCATED IN THE FIELD. IF THE CONTRACTOR PERCEIVES THAT A CONFLICT BETWEEN THE UTILITIES AND THE TRAFFIC SIGNAL WILL OCCUR, THE CONTRACTOR SHALL NOTIFY THE ENGINEER IMMEDIATELY SO THAT THE CONFLICT MAY BE RESOLVED.
12. THE CONTRACTOR SHALL VERIFY ALL POLE LOCATIONS PRIOR TO INSTALLATION.
13. VIDEO DETECTION CAMERA LOCATION/ALIGNMENT SHALL BE COORDINATED WITH THE ENGINEER.
14. THE CONTRACTOR SHALL CAP AND ABANDON CONDUIT FEEDING SIGNAL EQUIPMENT THAT IS REMOVED.
15. ADA REQUIRES THAT ANY ABRUPT CHANGE IN ELEVATION IN SIDEWALK BE LESS THAN 1/4".
16. VIDEO DETECTION CAMERAS FOR EAST AND WEST APPROACHES SHALL BE CHECKED IN THE FIELD BY THE ENGINEER PRIOR TO PERMANENT INSTALLATION TO ELIMINATE ANY POSSIBLE TELECOMMUNICATION CABLE CONFLICTS.
17. OCEAN CITY DPW SHOULD BE CONTACTED A MINIMUM OF FOUR WEEKS PRIOR TO STARTING WORK ON THIS INTERSECTION TO COORDINATE DRAINAGE INLET RELOCATION. CONTACT OCEAN CITY DPW AT 410-524-4733.
18. ALL HARDWARE NECESSARY FOR THE INSTALLATION OF RELOCATED TRAFFIC SIGNAL EQUIPMENT SHALL BE INCIDENTAL TO THE PERTINANT RELOCATE PAY ITEM.

SHA STATE OF MARYLAND
DEPARTMENT OF TRANSPORTATION
STATE HIGHWAY ADMINISTRATION
OFFICE OF TRAFFIC & SAFETY
TRAFFIC ENGINEERING DESIGN DIVISION
MD 528 (COASTAL HWY.) AT 139TH ST.
OCEAN CITY, MARYLAND

REVISIONS	GENERAL INFORMATION SHEET		
1 REDLINE NO. 1 05/03/2010 DELETE SHEET AND REPLACE	SCALE	DATE	CONTRACT NO.
	NONE	NOVEMBER 2009	XX4435185
	DESIGNED BY	COUNTY	WORCESTER
	BJG	LOGMINE	23052800.49
	DRAWN BY	TIMS NO.	K186
	CHECKED BY	TOD NO.	
	BLB		
	FAP NO.		
	TS NO. 23168-GI	DRAWING	SG-4 OF 4
		SHEET NO.	5 OF 7

RKK
Rummel, Klepper & Kahl, LLP
81 MOSHER STREET | BALTIMORE, MD 21217
PH: (410) 728-8500 FAX: (410) 728-3100
Engineers Construction Managers Planners Scientists
www.rkk.com