



2 GREENLINE NO. 1 & 2 QUANTITIES

1 STANDARD TYPE A COMBINATION CURB AND GUTTER	
12 INCH GUTTER PAN 8 INCH DEPTH SHA STD. NO. MD-620.02	
LOCATION	QUANTITY (LF)
NORTHWEST QUADRANT	25

TRAVERSE CONTROL POINT 501
 N 289,112.0776
 E 1,869,850.0621
 ELEV. 6.39

1 5 INCH CONCRETE SIDEWALK	
LOCATION	QUANTITY (SF)
NORTHWEST QUADRANT	90

2 DETECTABLE WARNING SURFACE	
SHA STD. NO. MD-655.40	
LOCATION	QUANTITY (SF)
NORTHWEST QUADRANT	20

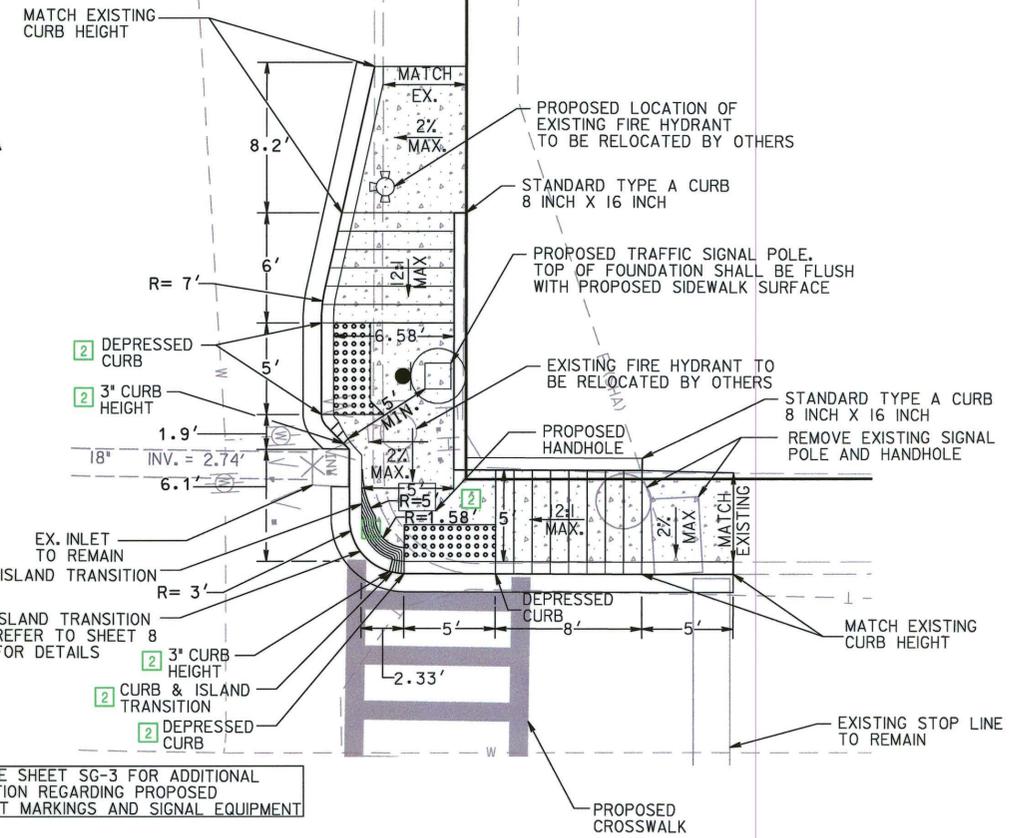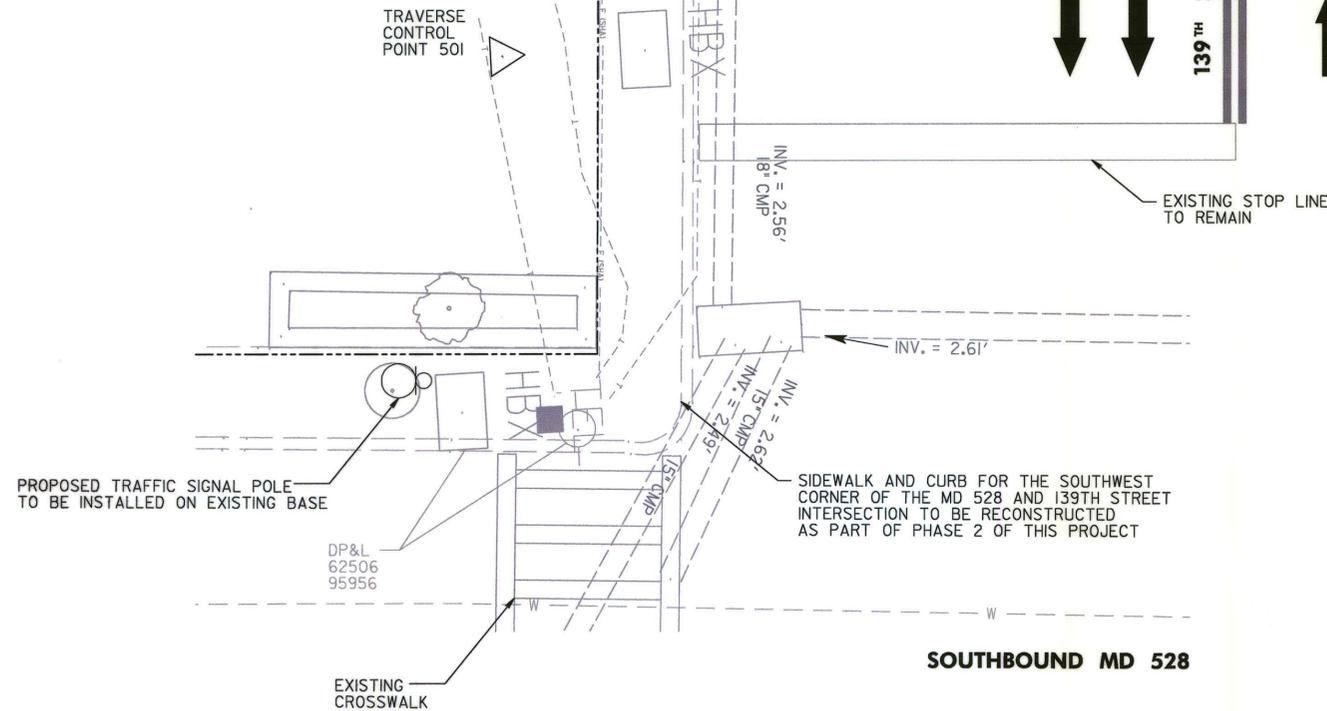

NOTE: SEE SHEET SG-3 FOR ADDITIONAL INFORMATION REGARDING PROPOSED PAVEMENT MARKINGS AND SIGNAL EQUIPMENT

GENERAL NOTES

- FOR 5 INCH CONCRETE SIDEWALK RECONSTRUCTION, SEE TYPICAL SECTION, SEE SHEET DE-03.
- ALL DIMENSIONS ARE APPROXIMATE. CONTRACTOR TO VERIFY ALL DIMENSIONS IN THE FIELD.
- NO DISTURBED AREA SHALL BE LEFT UNSTABILIZED OVERNIGHT UNLESS THE RUNOFF IS DIRECTED TO AN APPROVED SEDIMENT CONTROL DEVICE.
- SIDEWALK RECONSTRUCTION LIMITS SHALL COINCIDE WITH CRACK CONTROL JOINTS (JOINTER GROOVES) OR EXPANSION JOINTS IN EXISTING SIDEWALK. NEW EXPANSION JOINTS SHALL BE PROVIDED AT THE INTERFACE OF EXISTING AND PROPOSED SIDEWALK. SEE SHA. STD. NO. MD-655.01.
- INSTALL DETECTABLE WARNING SURFACE ON SIDEWALK RAMP AS PER SHA STD. NO. MD-655.40.
- FORM NEW SIDEWALK AND EXPANSION JOINT MATERIAL AROUND EX. UTILITY POLES, MANHOLE COVERS, VALVE COVERS, AND FIRE HYDRANTS AS NECESSARY.
- RESET ANY SIGNS DISTURBED BY THE CONSTRUCTION AS DIRECTED BY THE ENGINEER.
- EXISTING INLETS SHALL NOT BE DAMAGED DURING CONSTRUCTION. DAMAGE TO THE INLETS WILL REQUIRE THE INLET TO BE REPLACED AT NO ADDITIONAL COST TO THE ADMINISTRATION.
- EXISTING TREES, SHRUBS, AND THEIR RESPECTIVE ROOT SYSTEMS SHALL NOT BE DISTURBED DURING CONSTRUCTION.

LEGEND

- CONCRETE PAVEMENT
- DETECTABLE WARNING SURFACE

RK&K
 RUMMEL, KLEPPER & KAHL, LLP
 81 MOSHER STREET | BALTIMORE, MD 21217
 PH: (410) 728-2900 FAX: (410) 728-3160
 Engineers | Construction Managers | Planners | Scientists
 www.rkk.com

REVISIONS	
1	REDLINE NO. 1 05/03/2010 INSERT SHEET
1	GREENLINE NO. 1 12/01/2010 REVISE DWS
2	GREENLINE NO. 2 07/12/2011 REVISE DWS

SHA STATE OF MARYLAND
 DEPARTMENT OF TRANSPORTATION
 STATE HIGHWAY ADMINISTRATION
 OFFICE OF TRAFFIC & SAFETY
 TRAFFIC ENGINEERING DESIGN DIVISION
MD 528 (COASTAL HIGHWAY) AT 139 ST.
 OCEAN CITY, MD.

RAMP DETAILS			
SCALE	1" = 5'	DATE	APRIL 2010
CONTRACT NO.	XX4435185		
DESIGNED BY	JDG	COUNTY	WORCESTER
DRAWN BY	JBB	LOGMILE	
CHECKED BY	ATD	TIMS NO.	K188
FAP NO.		TOD NO.	
TS NO.	2316B-DE	DRAWING	DE-02 OF 3
SHEET NO.	6 OF 7		

BY: wwiesmantel