




FHWA REGION NO.	STATE	FED. AID PROJ. NO.	SHEET NO.	TOTAL SHEETS
3	MD			

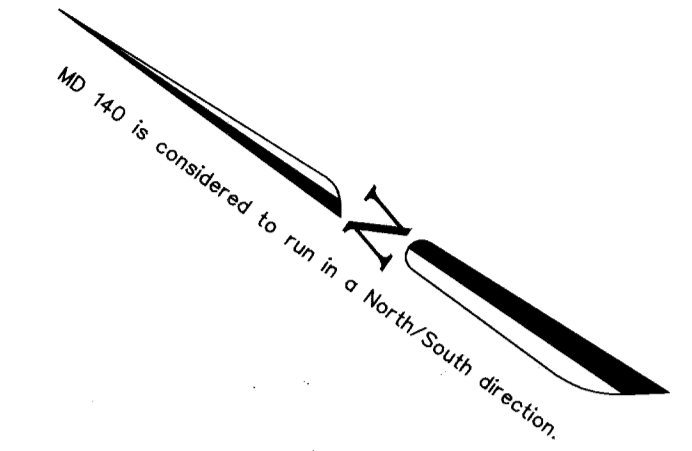



SIGNALS

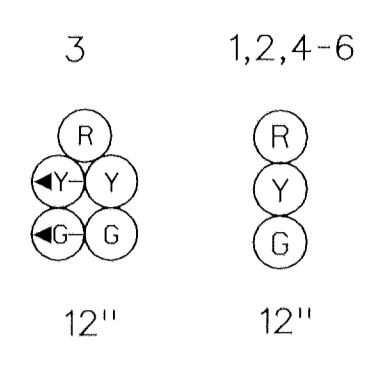

SIGNS

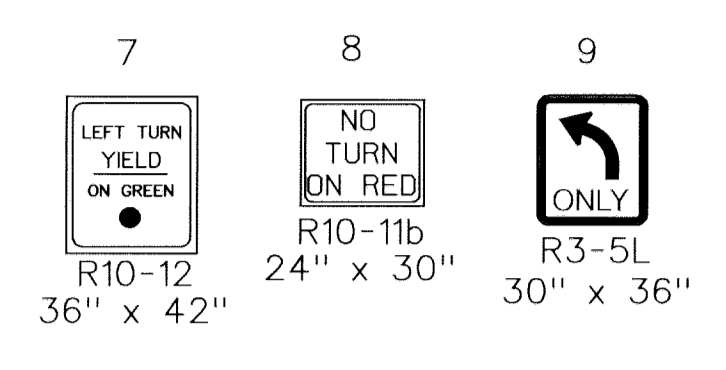

NEMA PHASING

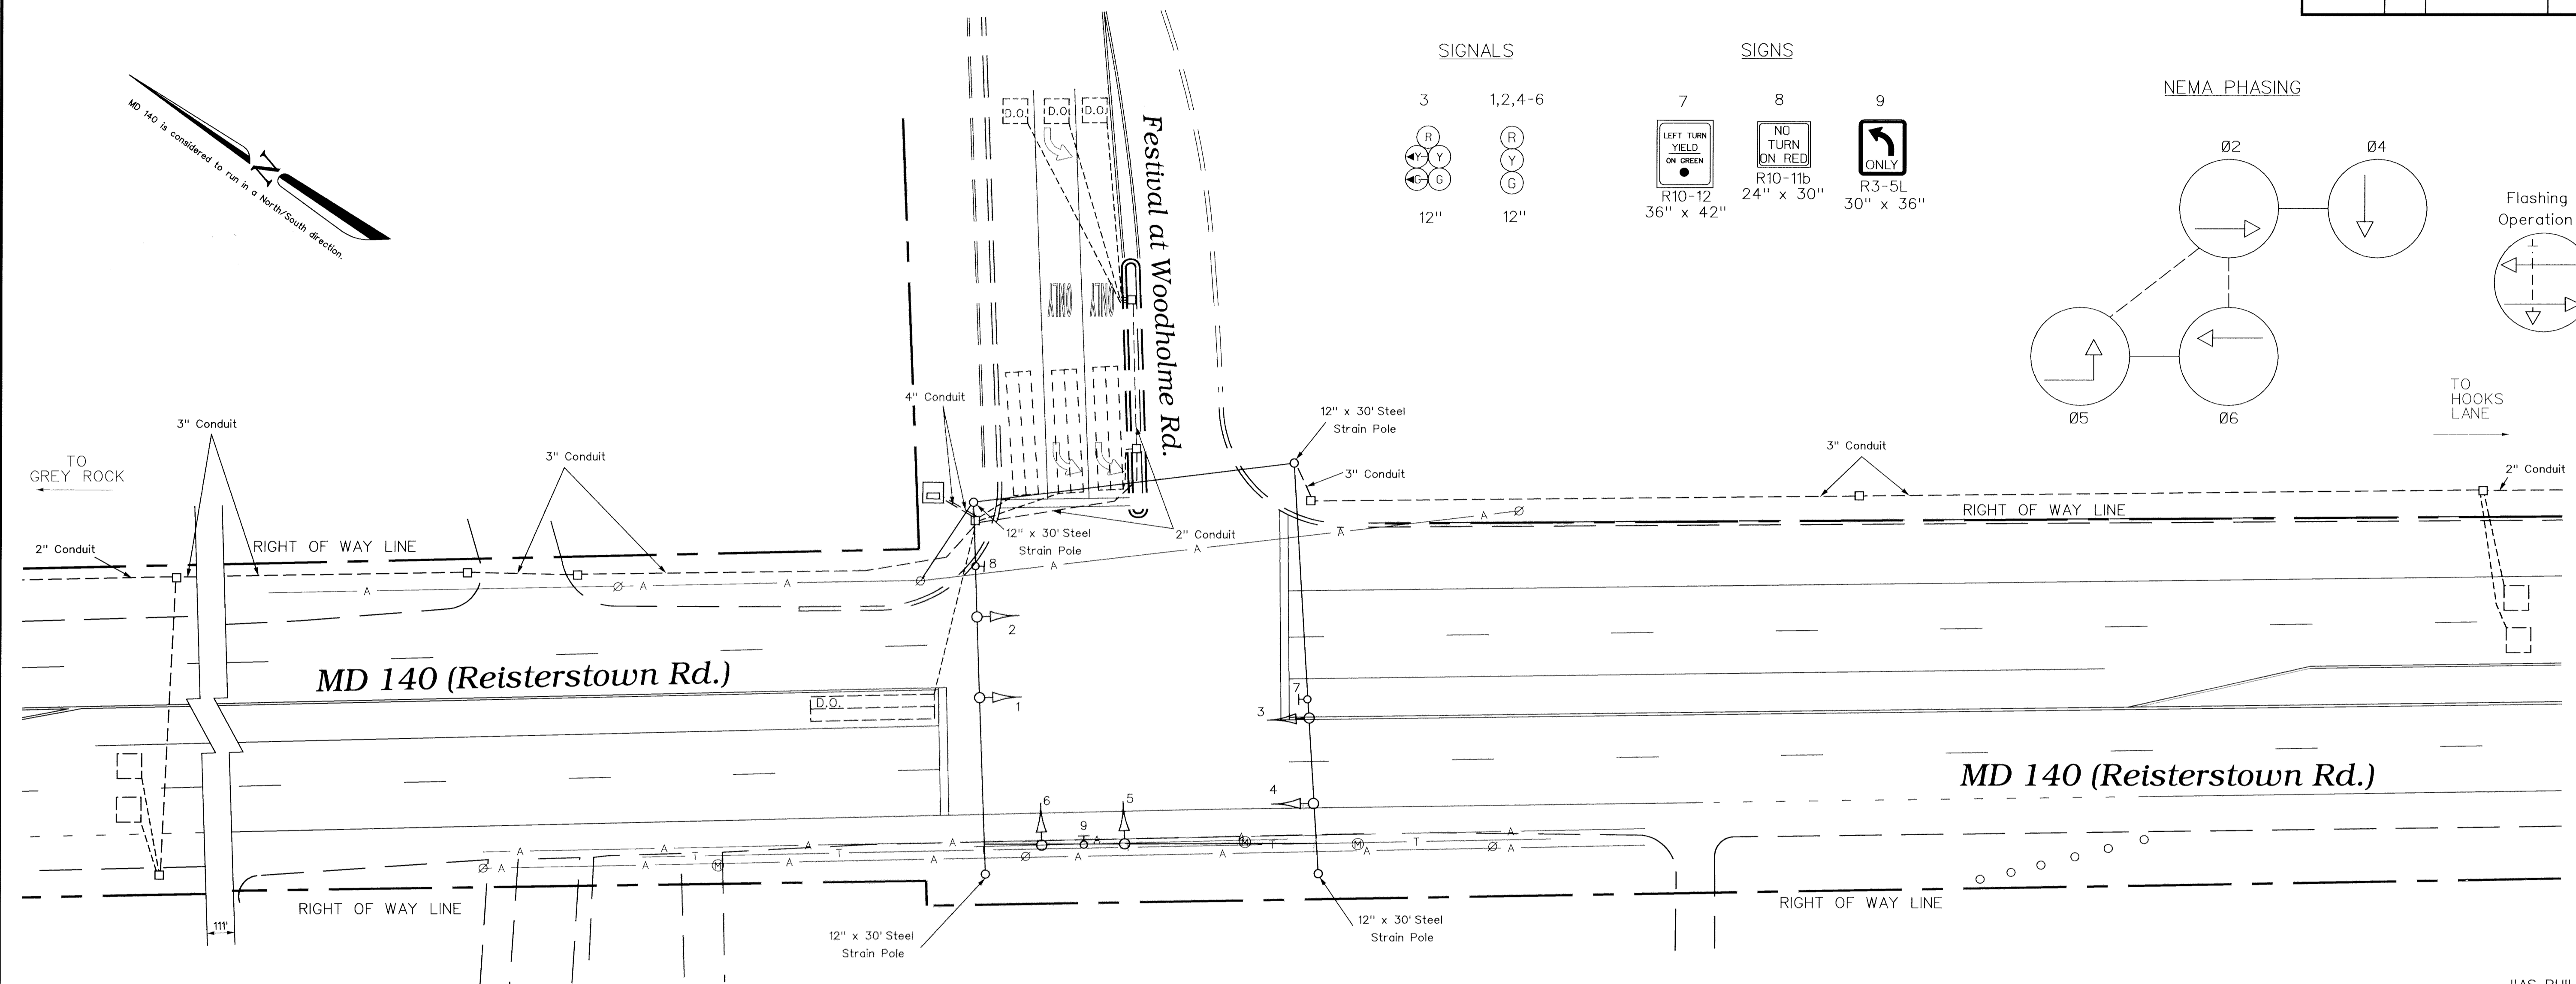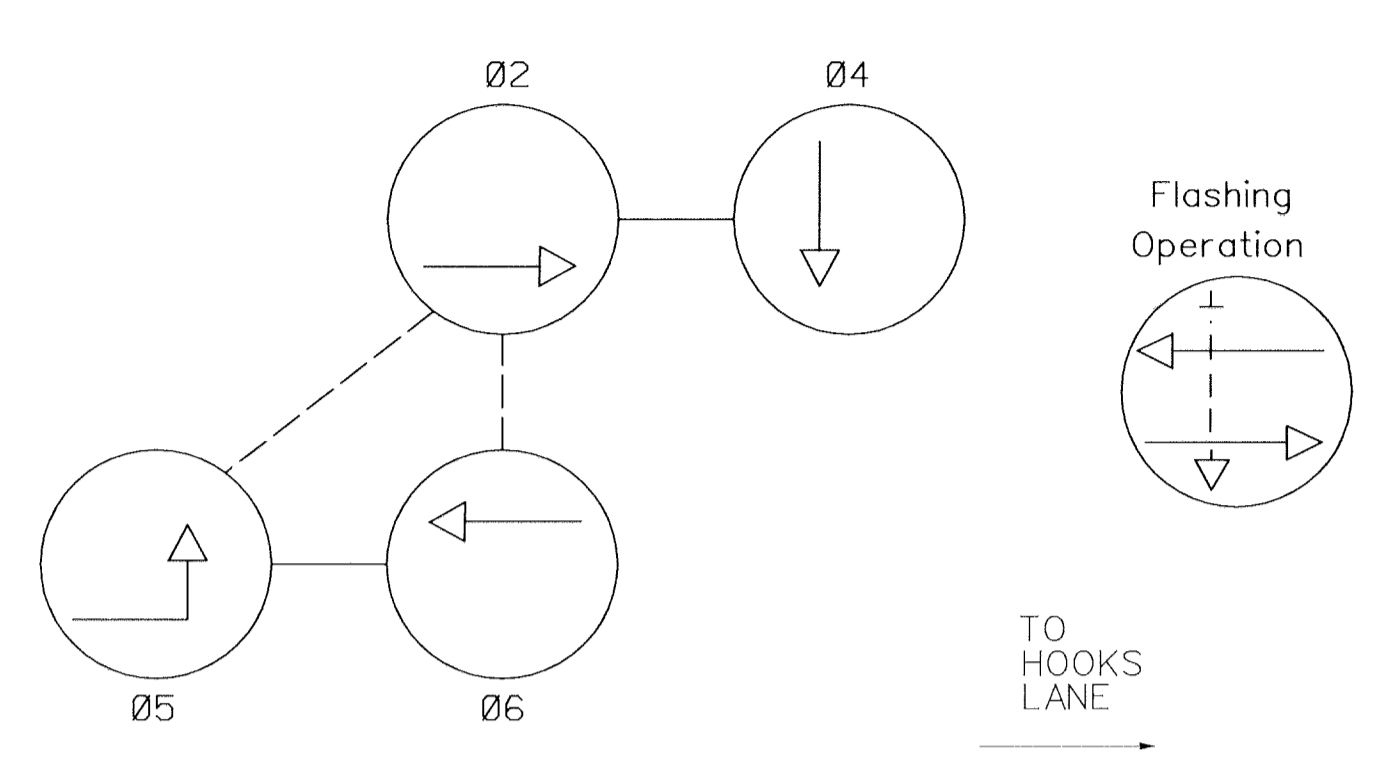

"AS-BUILT"

The Traffic Group, Inc.
Suite 600
40 W. Chesapeake Avenue
Towson, Maryland 21284
410-583-8415
1-800-583-8411
Fax 410-321-8458
Job No. 960527
ASBUILT.DGN

GEOMETRIC LEGEND	
— — —	EXISTING GEOMETRICS
— — —	PROPOSED GEOMETRICS
UTILITY LEGEND	
— G — G —	GAS MAIN
— W — W —	WATER MAIN
— S — S —	SEWER MAIN
— E — E —	ELECTRIC CABLES
— D — D —	STORM DRAIN
— A — A —	AERIAL CABLES
— T — T —	TELEPHONE CABLES

REVISIONS	APPROVALS
	ASST. DIVISION CHIEF TRAFFIC ENGINEERING DESIGN DIVISION
	CHIEF TRAFFIC ENGINEERING DESIGN DIVISION
	ASST. DISTRICT ENGINEER - TRAFFIC
	DIRECTOR, OFFICE OF TRAFFIC & SAFETY

MDOT - STATE HIGHWAY ADMINISTRATION
Office of Traffic & Safety
TRAFFIC ENGINEERING DESIGN DIVISION

MD 140 at Festival at Woodholme

DATE: 6/10/96 SCALE: 1" = 20'

F.A.P. NO. N/A S.H.A. NO.

COUNTY: BALTIMORE LOG MILE: 03014002.25

TS/STD. NO. 3909C-P SHEET NO. 1 of 1

File # 15