

EXISTING SIGNALS

1-4 5-8 9-10
 (R) (R) (DW)
 (Y) (Y) (WK)
 (G) (G) (G)
 12" 8" 12"


EXISTING SIGNS
 J3a,b - 14a,b

MT ROYAL AVE
 03-2
 16" x 96"


PROPOSED SIGNALS AND SIGNS

1,3 2,4-8 11-12
 (R) (R) (R)
 (Y) (Y) (Y)
 (G) (G) (G)
 12" 12" 12"
 LEFT TURN
 YIELD
 ON GREEN
 R 10-12
 36" x 42"

HEMA PHASING:

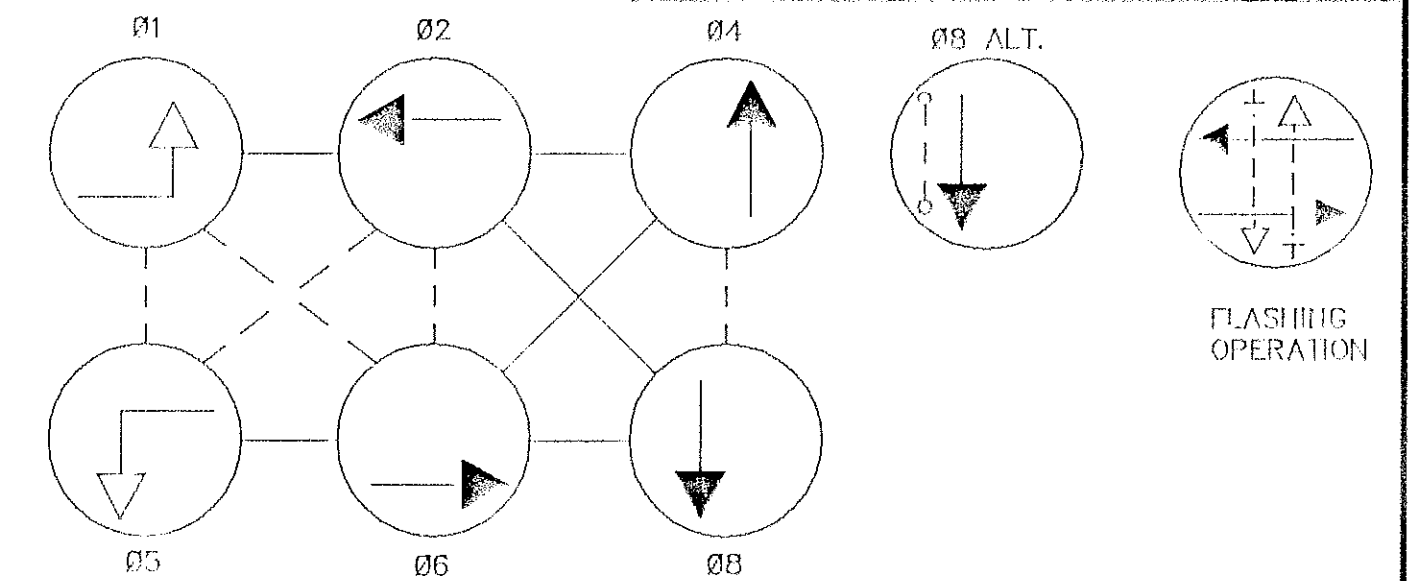

HEMA NOTES:
 1. PHASES ASSOCIATED BY A DASHED LINE WILL OPERATE CONCURRENTLY
 2. PHASES ASSOCIATED BY A SOLID LINE WILL NOT OPERATE CONCURRENTLY

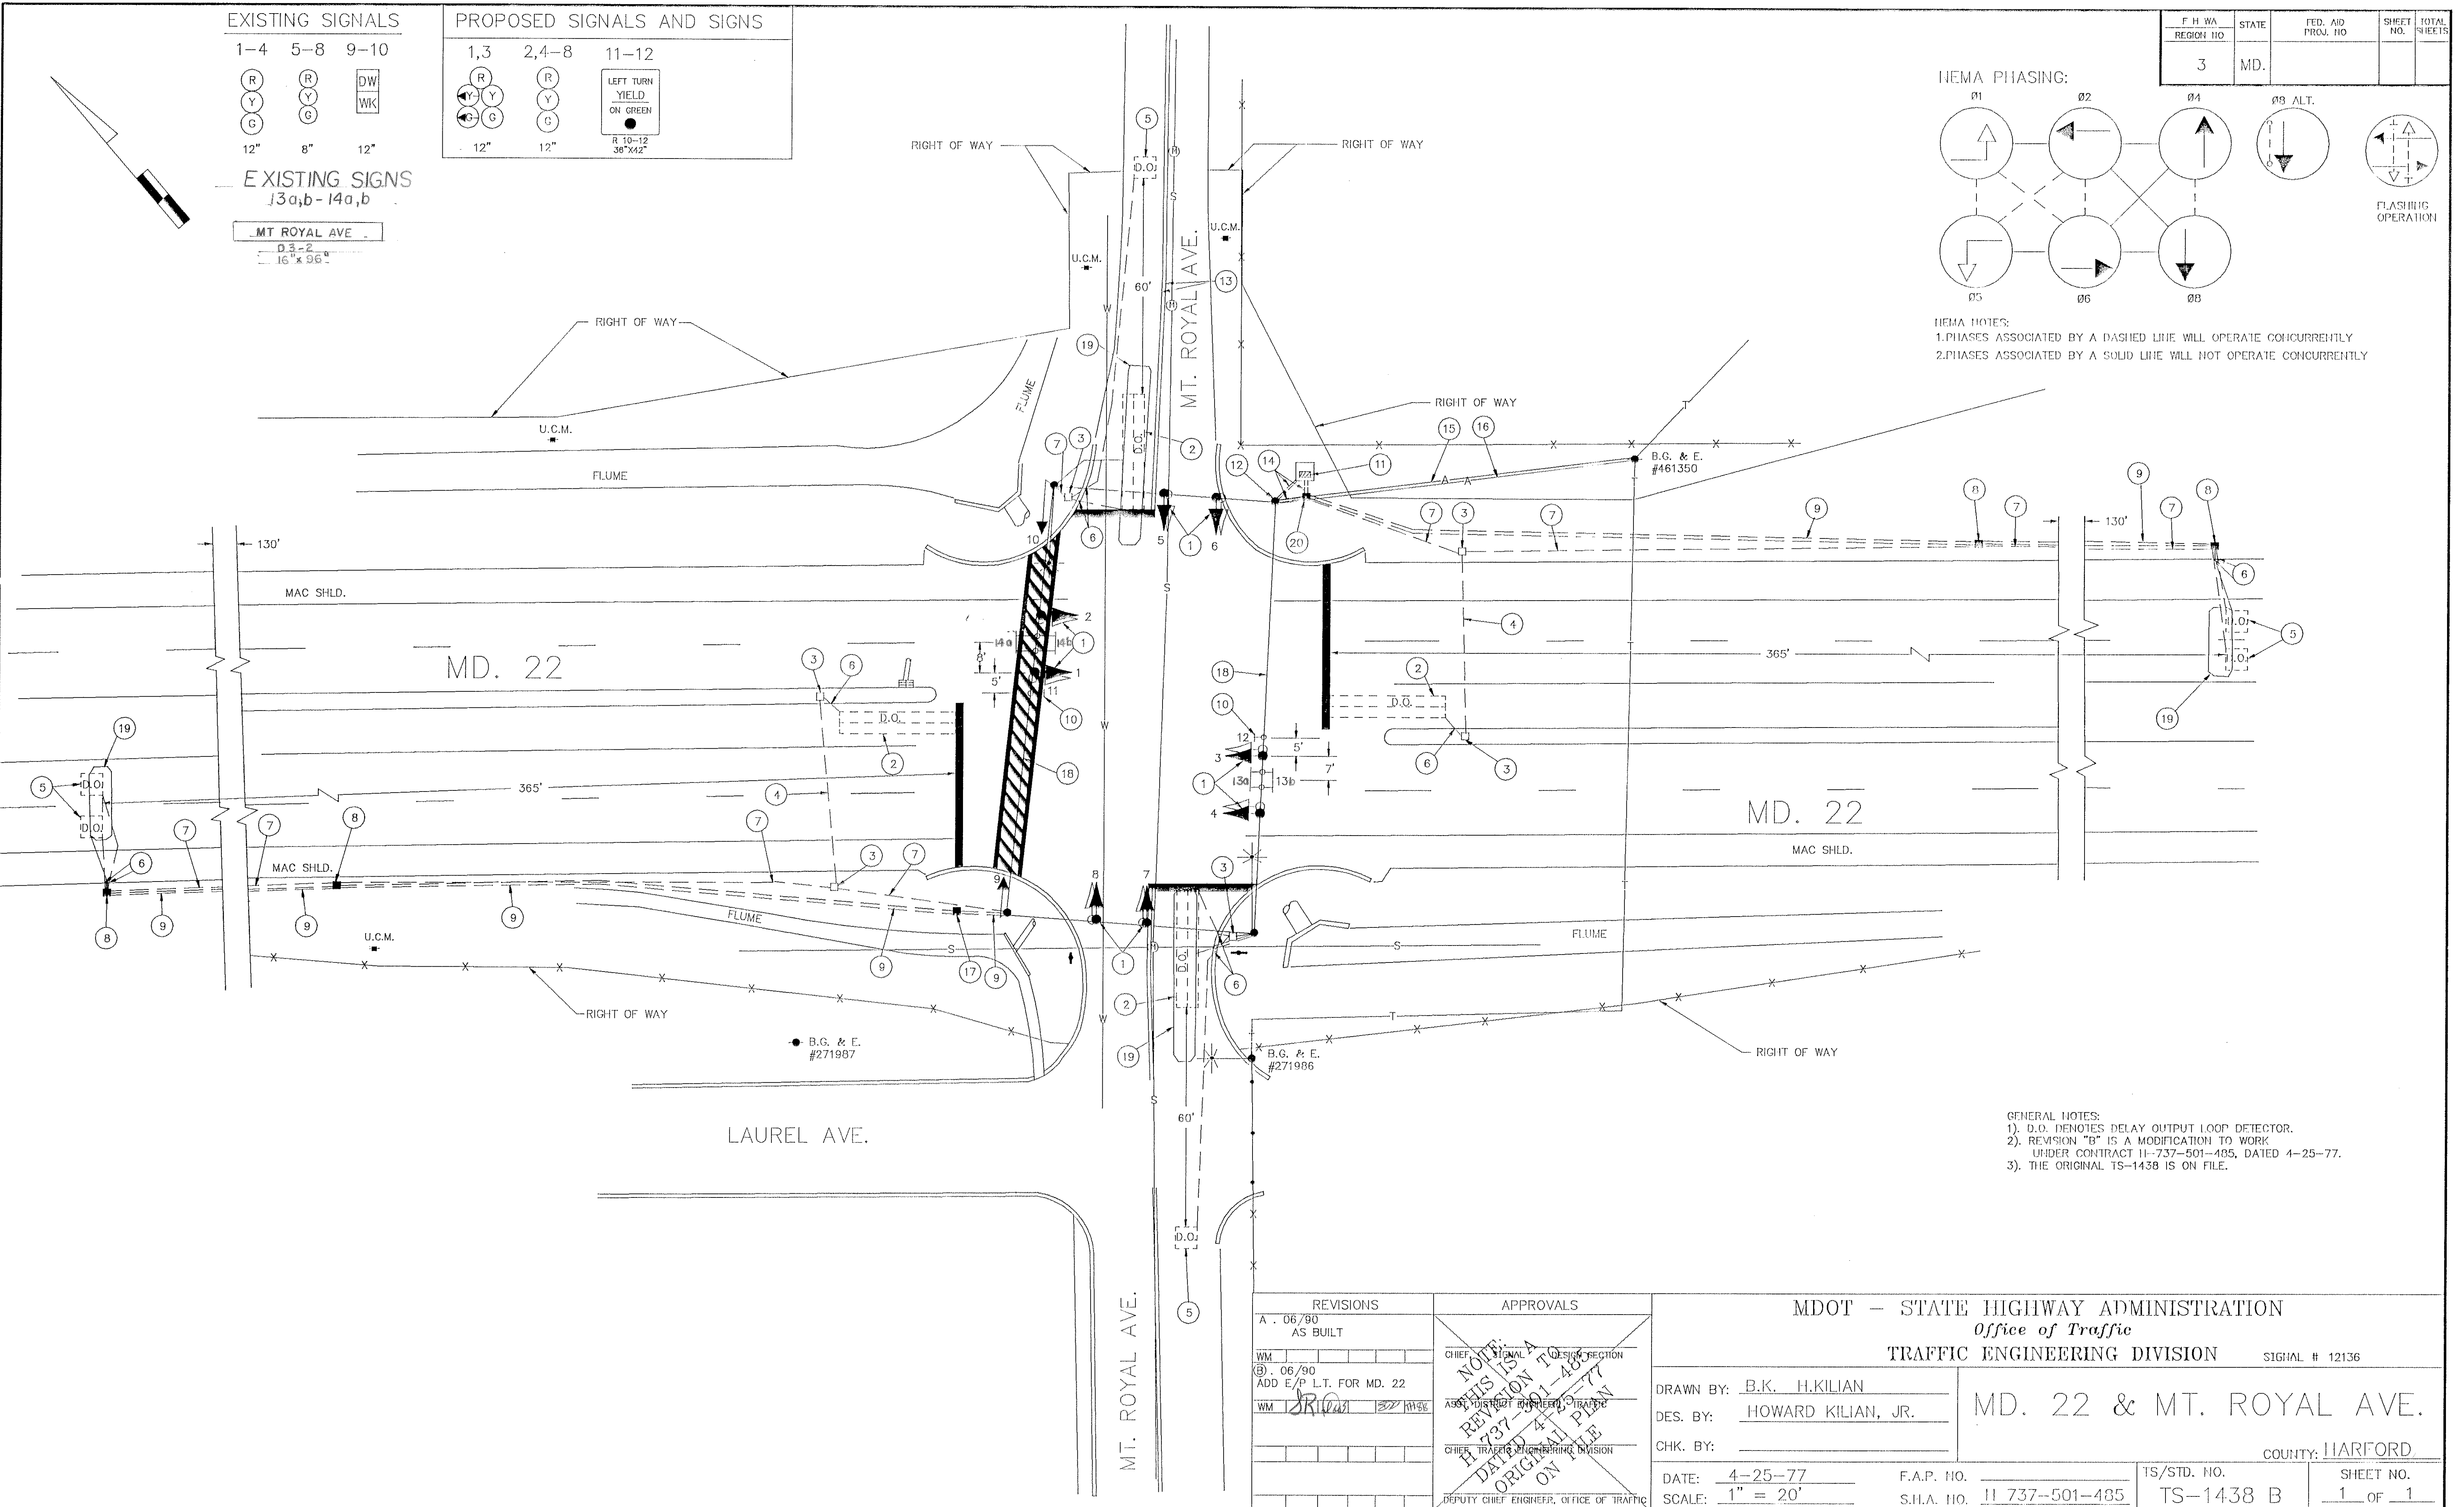

GENERAL NOTES:
 1). D.O. DENOTES DELAY OUTPUT LOOP DETECTOR.
 2). REVISION "B" IS A MODIFICATION TO WORK
 UNDER CONTRACT II-737-501-485, DATED 4-25-77.
 3). THE ORIGINAL TS-1438 IS ON FILE.

REVISIONS		APPROVALS		MDOT - STATE HIGHWAY ADMINISTRATION	
A	06/90 AS BUILT			Office of Traffic	
B	06/90 ADD E/P L.T. FOR MD. 22			TRAFFIC ENGINEERING DIVISION	
C	06/90 ADD E/P L.T. FOR MD. 22			SIGNAL # 12136	
D	06/90 ADD E/P L.T. FOR MD. 22			DRAWN BY: B.K. H.KILIAN	
E	06/90 ADD E/P L.T. FOR MD. 22			DES. BY: HOWARD KILIAN, JR.	
F	06/90 ADD E/P L.T. FOR MD. 22			CHK. BY:	
G	06/90 ADD E/P L.T. FOR MD. 22			DATE: 4-25-77	
H	06/90 ADD E/P L.T. FOR MD. 22			F.A.P. NO.	
I	06/90 ADD E/P L.T. FOR MD. 22			S.H.A. NO. II 737-501-485	
J	06/90 ADD E/P L.T. FOR MD. 22			TS/STD. NO. TS-1438 B	
K	06/90 ADD E/P L.T. FOR MD. 22			SHEET NO. 1 OF 1	
L	06/90 ADD E/P L.T. FOR MD. 22			COUNTY: HANFORD	

12002211.43