


US 40 is considered to run in an East/West direction.

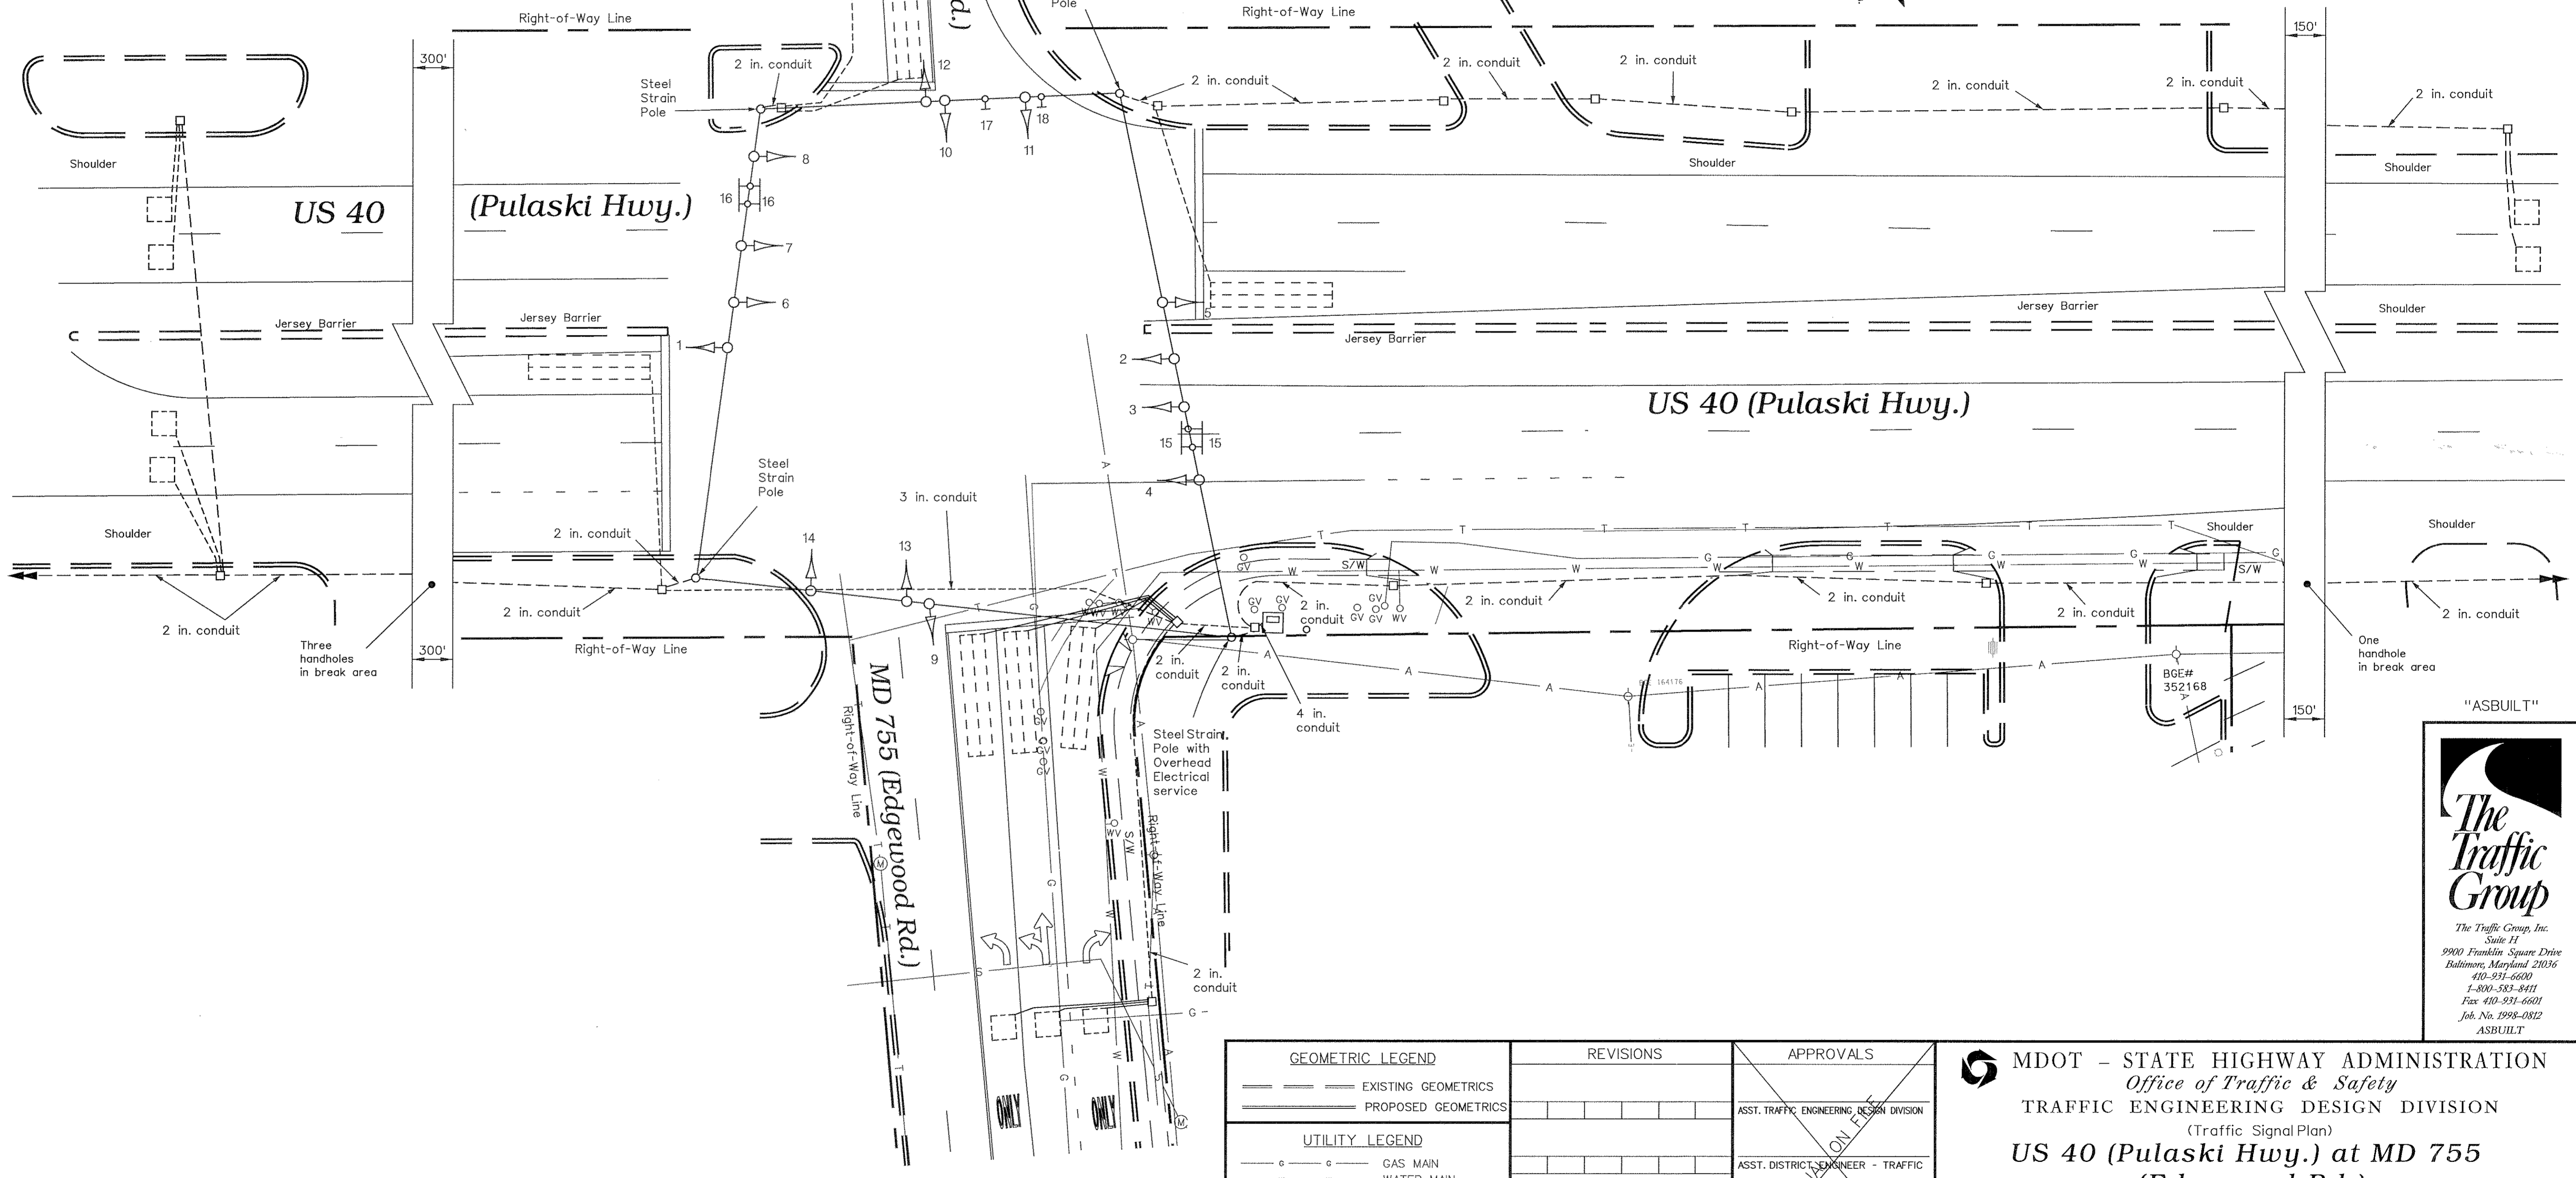

"ASBUILT"

The Traffic Group
The Traffic Group, Inc.
Suite H
9900 Franklin Square Drive
Baltimore, Maryland 21036
410-931-6600
1-800-583-9411
Fax 410-931-6601
Job No. 1998-0812
ASBUILT

GEOMETRIC LEGEND	REVISIONS	APPROVALS
— — — — — EXISTING GEOMETRICS		
— — — — — PROPOSED GEOMETRICS		
UTILITY LEGEND		
— G — G — GAS MAIN		
— W — W — WATER MAIN		
— S — S — SEWER MAIN		
— E — E — ELECTRIC CABLES		
— D — D — STORM DRAIN		
— A — A — AERIAL CABLES		
— T — T — TELEPHONE CABLES		

MDOT - STATE HIGHWAY ADMINISTRATION
Office of Traffic & Safety
TRAFFIC ENGINEERING DESIGN DIVISION
(Traffic Signal Plan)

US 40 (Pulaski Hwy.) at MD 755 (Edgewood Rd.)

DATE: August, 1992 LOG MILE * 1200400.12

DRAWN BY: W. Malcolm	F.A.P. NO. N/A	PLAN SHEET NO.:	SHEET NO.
CHK. BY: D. Doda	S.H.A. NO. H-933-501-485	3252C	1 of 1
SCALE: 1" = 20'	COUNTY: HARMFORD		

© ASBUILT S.H.A. No. BW996M82 March 21, 2000
DIRECTOR, OFFICE OF TRAFFIC & SAFETY

1:1508212484.mxd 4/21/99 22 MAR 2002