


DRILL HOLES

BORDER REV. DATE: MARCH 27, 2007

DRILL HOLES

DRILL HOLES

BY: Aaron Hottenstein Division: P068 Highway TrafficGMA Emp

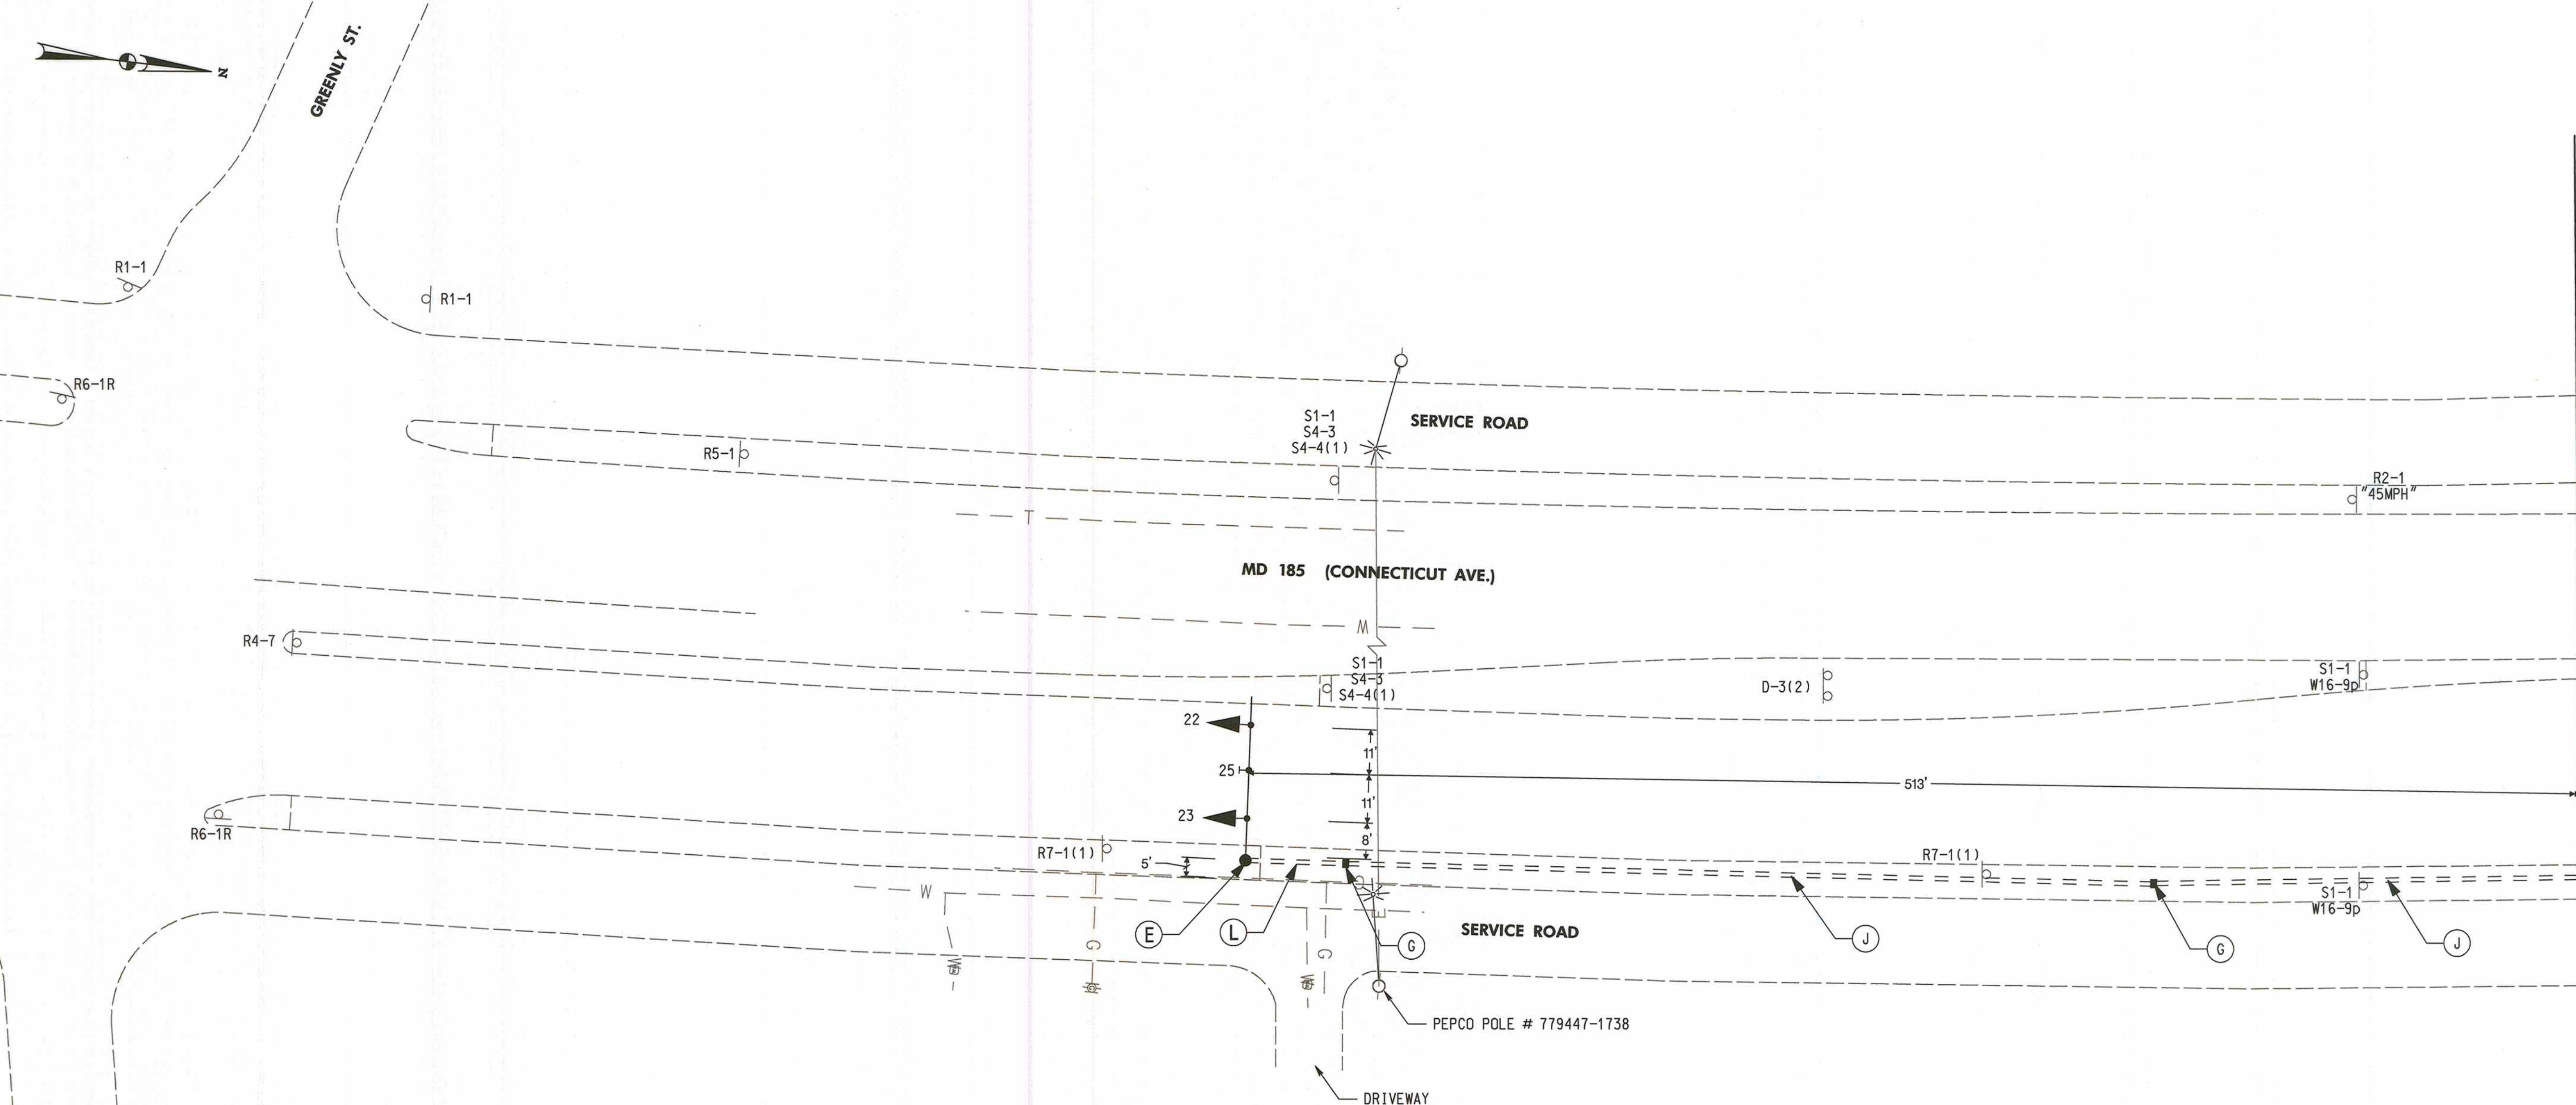

- CONSTRUCTION DETAILS**
- E. INSTALL CONCRETE FOUNDATION WITH A ²¹/₄ FOOT STEEL POLE AND ONE 60 FOOT MAST ARM (CUT TO 40 FOOT), SIGNALS AND SIGNS (1-3" CONDUIT BEND).
 - G. INSTALL ELECTRICAL HANDHOLE.
 - J. INSTALL 4" SCHEDULE 80 RIGID PVC CONDUIT - TRENCHED.
 - L. INSTALL 3" SCHEDULE 80 RIGID PVC CONDUIT - TRENCHED.

KCI TECHNOLOGIES

ENGINEERS
PLANNERS
SCIENTISTS
CONSTRUCTION MANAGERS

936 ROCKBROOK ROAD
SHARPS, MARYLAND 21152
TELEPHONE: (410) 316-7800
FAX: (410) 316-7818

1 REDLINE NO. 1
MARCH 2012

APPROVED BY TEDD

SHA	
STATE OF MARYLAND DEPARTMENT OF TRANSPORTATION STATE HIGHWAY ADMINISTRATION OFFICE OF TRAFFIC & SAFETY TRAFFIC ENGINEERING DESIGN DIVISION MD 185 AT WELLER ROAD GLENMONT, MARYLAND	
TRAFFIC SIGNAL PLAN	
SCALE 1" = 20' ADVERTISED DATE _____ CONTRACT NO. XX6555185	
DESIGNED BY AMH	COUNTY MONTGOMERY
DRAWN BY RLB	LOGMILE 15018506.75
CHECKED BY JEL	TIMS NO. K539
F.A.P. NO. NA	TOD NO. _____
TS NO. 512B	DRAWING SP-3 OF 4
SHEET NO. 3 OF 4	

PLOTTED: 09:56 AM on Wednesday, March 07, 2012
FILE: M:\2009\01090619.22\drawings\PSG-P001_MD185.dgn