



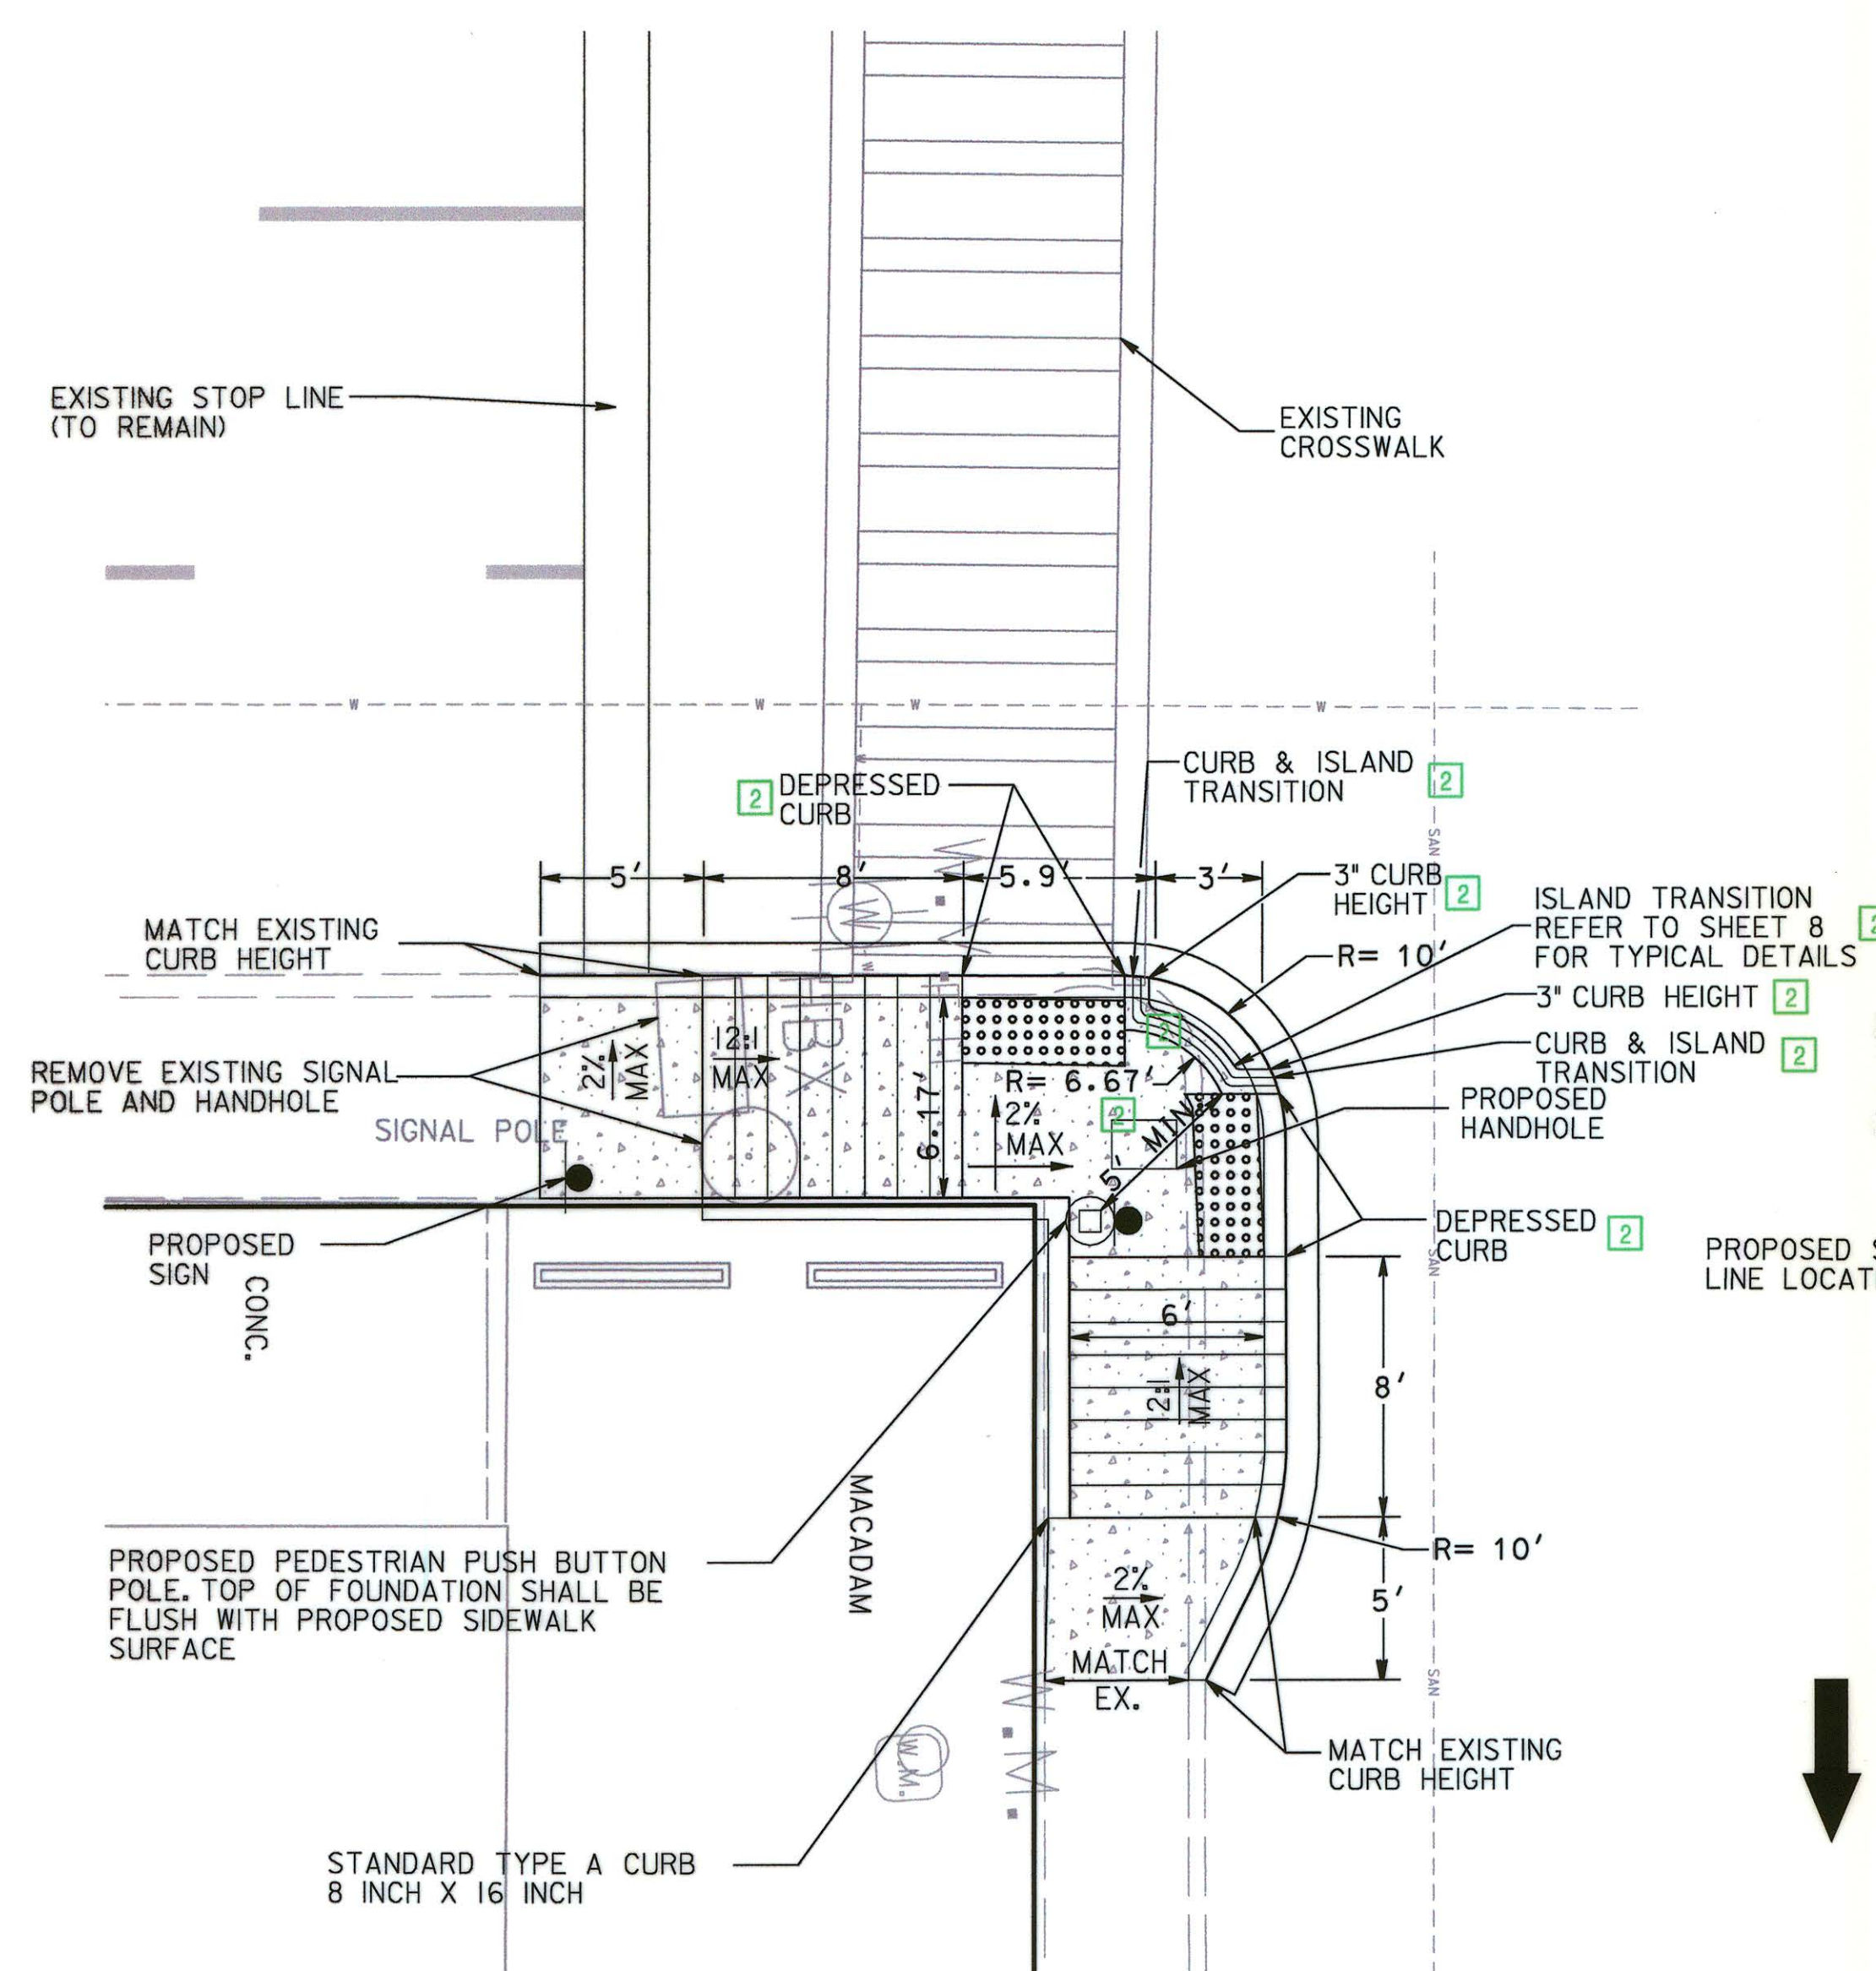

NORTHBOUND MD 528

139TH STREET

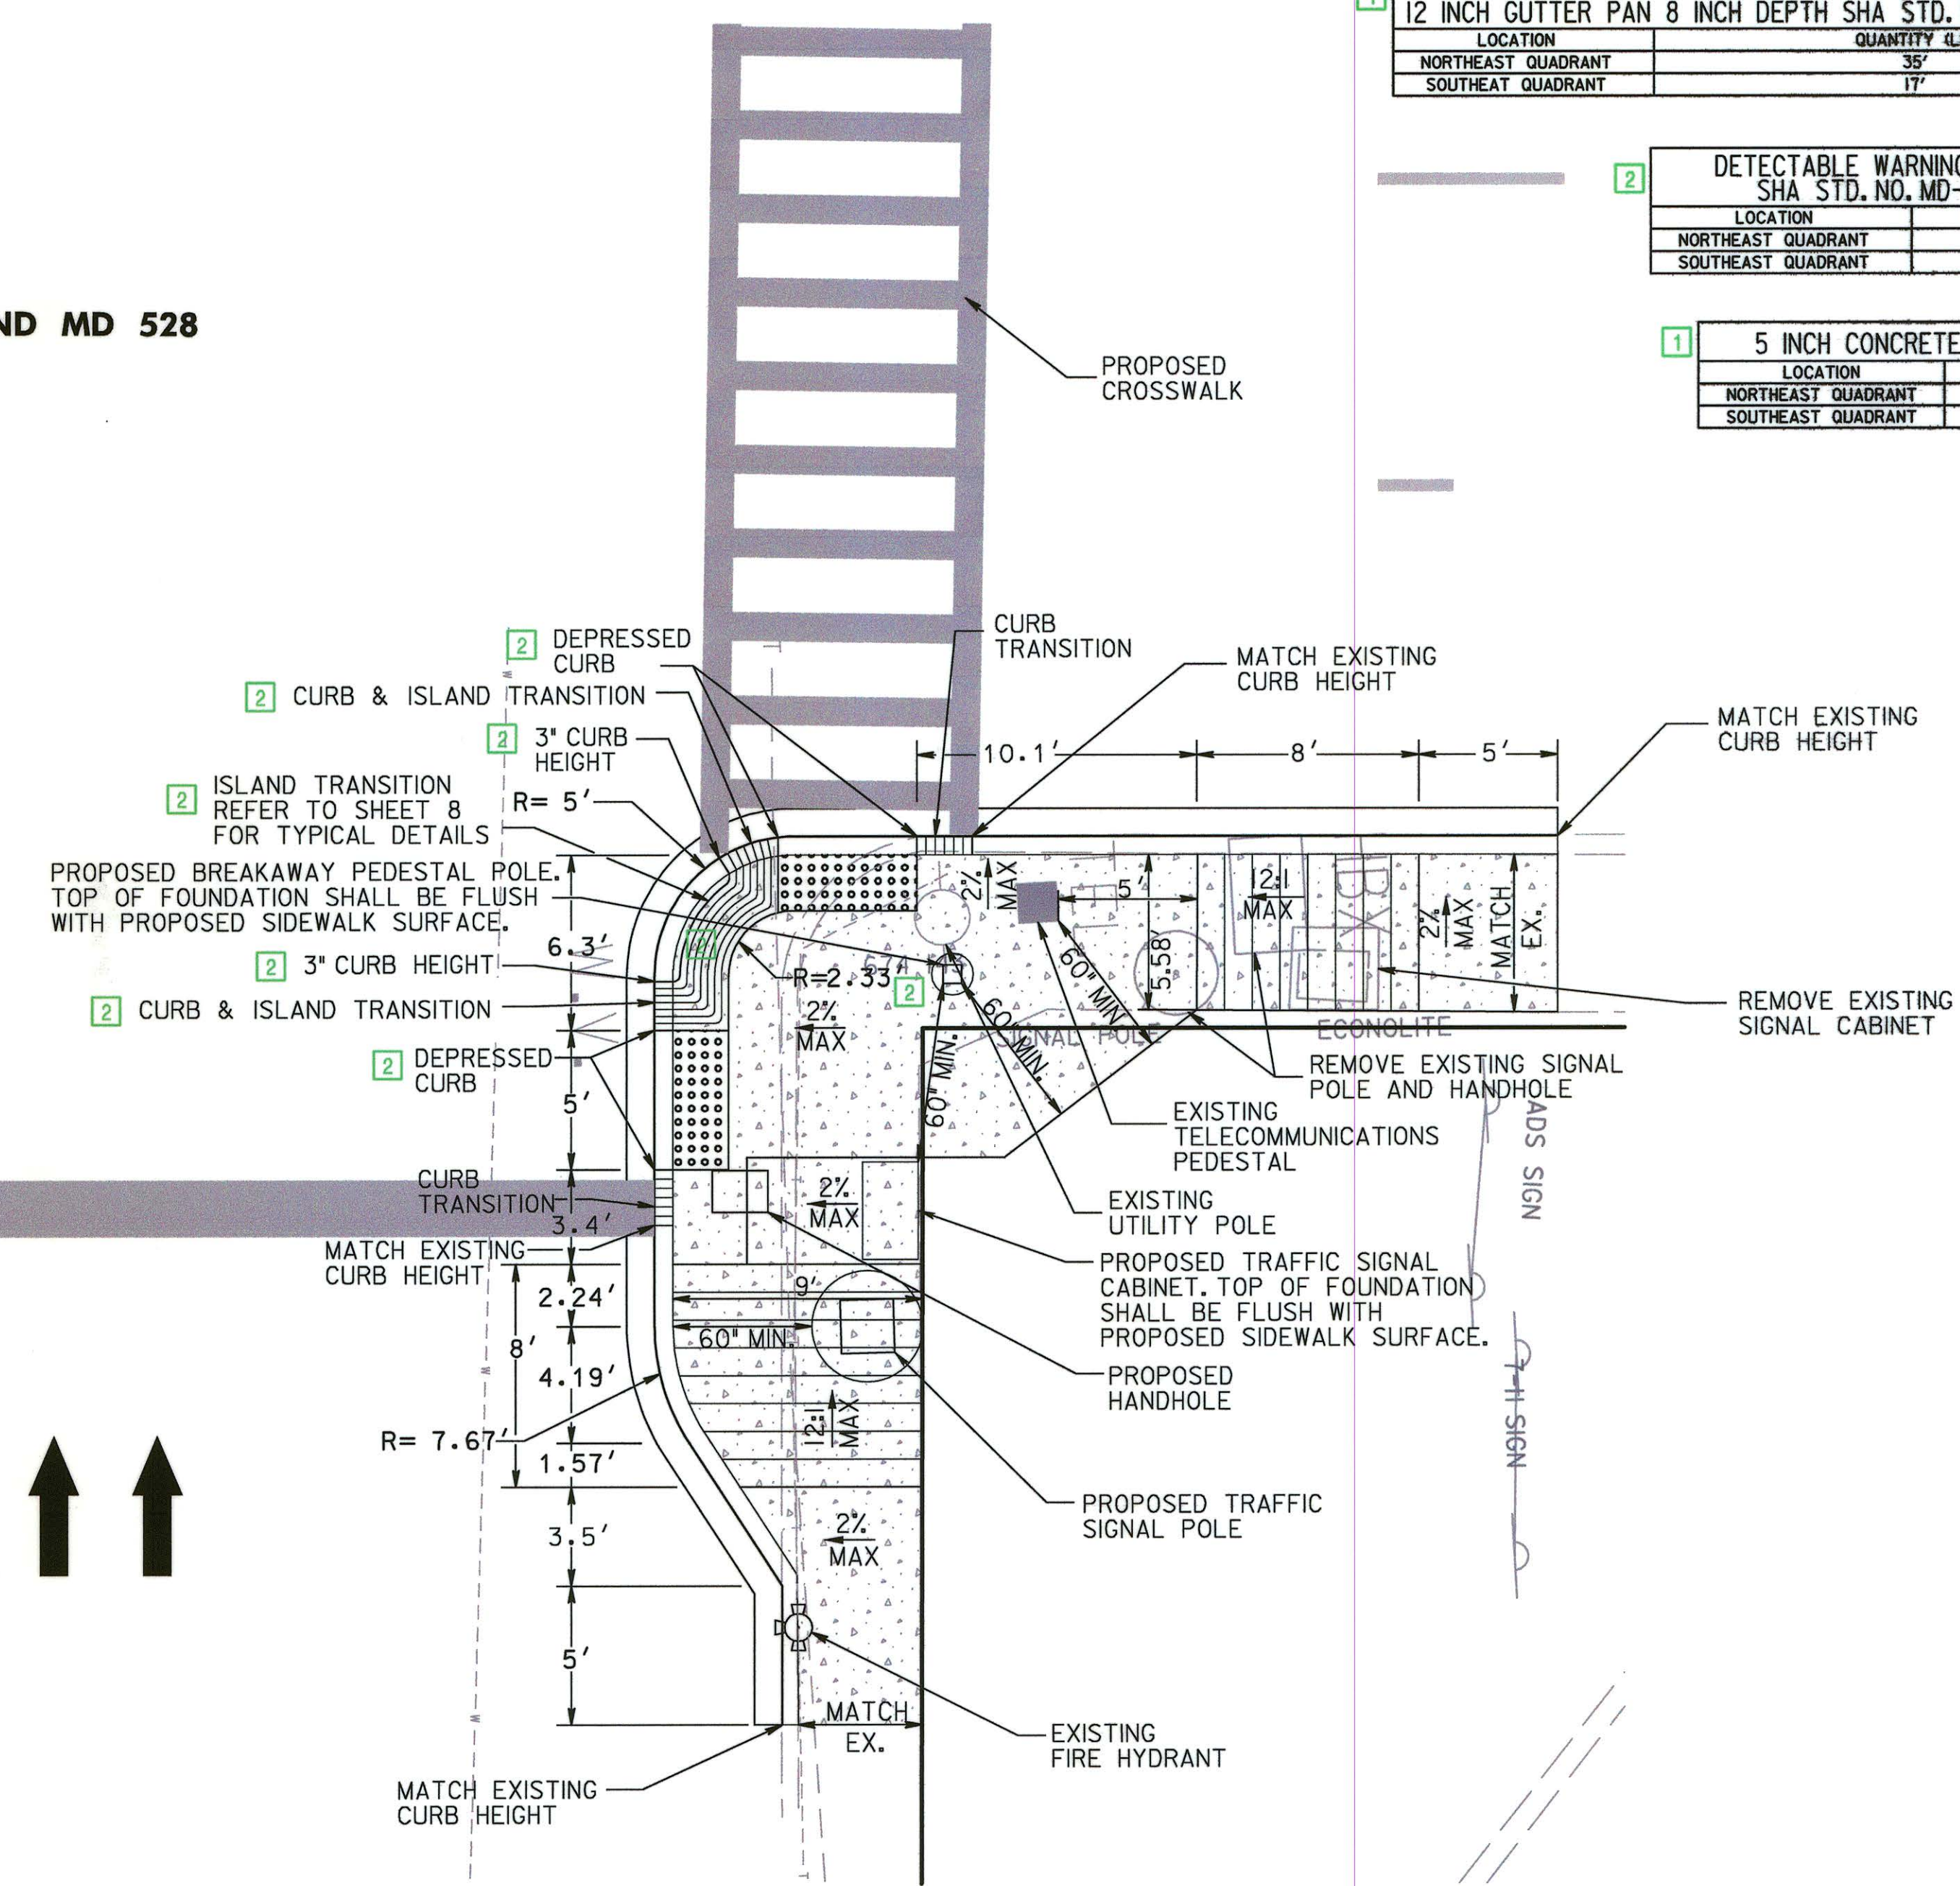

2 GREENLINE NO. 1 & 2 QUANTITIES


1 STANDARD TYPE A COMBINATION CURB AND GUTTER 12 INCH GUTTER PAN 8 INCH DEPTH SHA STD. NO. MD-620.02	
LOCATION	QUANTITY (LF)
NORTHEAST QUADRANT	35'
SOUTHEAST QUADRANT	17'

2 DETECTABLE WARNING SURFACE SHA STD. NO. MD-655.40	
LOCATION	QUANTITY (SF)
NORTHEAST QUADRANT	20 SF
SOUTHEAST QUADRANT	20 SF

1 5 INCH CONCRETE SIDEWALK	
LOCATION	QUANTITY (SF)
NORTHEAST QUADRANT	220 SF
SOUTHEAST QUADRANT	65 SF

LEGEND

	CONCRETE PAVEMENT
	DETECTABLE WARNING SURFACE

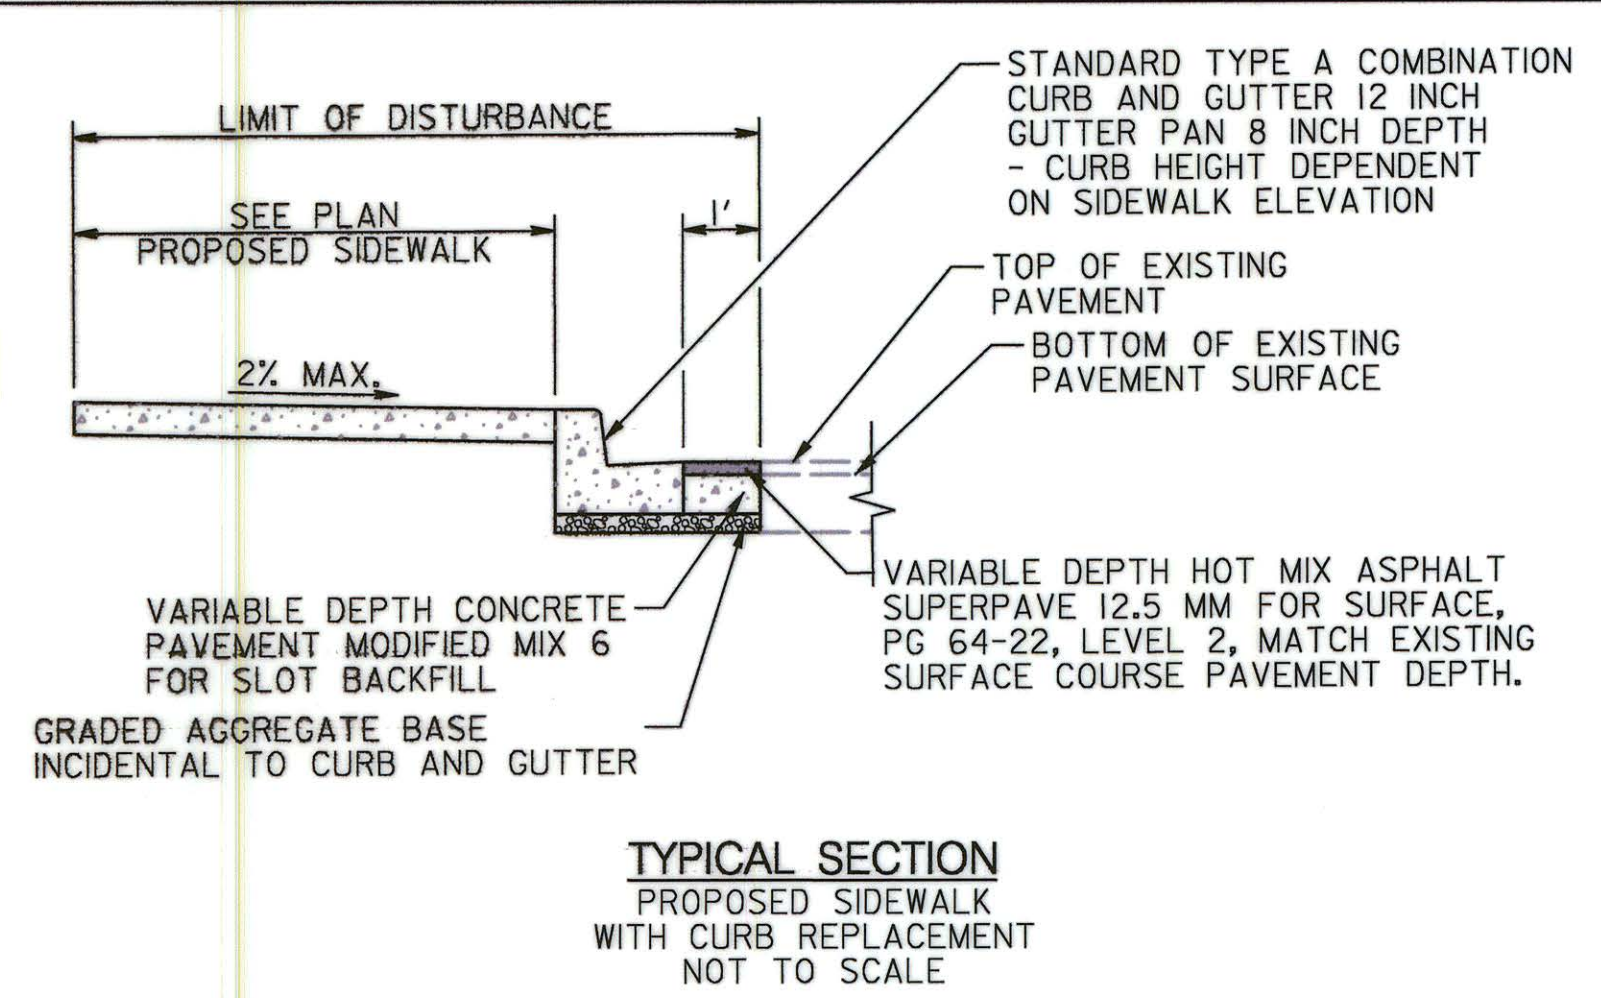

NOTE: SEE SHEET SG-3 FOR ADDITIONAL INFORMATION REGARDING PROPOSED PAVEMENT MARKINGS AND SIGNAL EQUIPMENT

STATE OF MARYLAND
DEPARTMENT OF TRANSPORTATION
STATE HIGHWAY ADMINISTRATION
OFFICE OF TRAFFIC & SAFETY
TRAFFIC ENGINEERING DESIGN DIVISION

**MD 528 (COASTAL HIGHWAY) AT 139TH ST.
OCEAN CITY, MD.**

RAMP DETAILS	
SCALE 1" = 5'	DATE APRIL 2010 CONTRACT NO. XX4435185
DESIGNED BY JDG	COUNTY WORCESTER
DRAWN BY JBB	LOGMILE
CHECKED BY ATD	TMS NO. K186
FAP NO.	TOD NO.
TS NO. 2316B-DE	DRAWING DE-03 OF 3 SHEET NO. 7 OF 7

RUMMEL, KLEPPER & KAHL, LLP
81 MOSHER STREET | BALTIMORE, MD 21217
PH: (410) 728-2900 FAX: (410) 728-3160

Engineers | Construction Managers | Planners | Scientists
www.rkk.com

REVISIONS	
1	REDLINE NO. 1 05/03/2010 INSERT SHEET
1	GREENLINE NO. 1 12/01/2010 REVISE DWS
2	GREENLINE NO. 2 01/22/2011 REVISE DWS

PLOTTED: Thursday, January 06, 2011 AT 03:04 PM
FILE: K:\projects\2007\07056_shahnd\Task 06_MD528 Signals\MD 528 at 139th\CADD\plan\pde-0002_Redline1_139th.dgn

BY: wwiesmantel