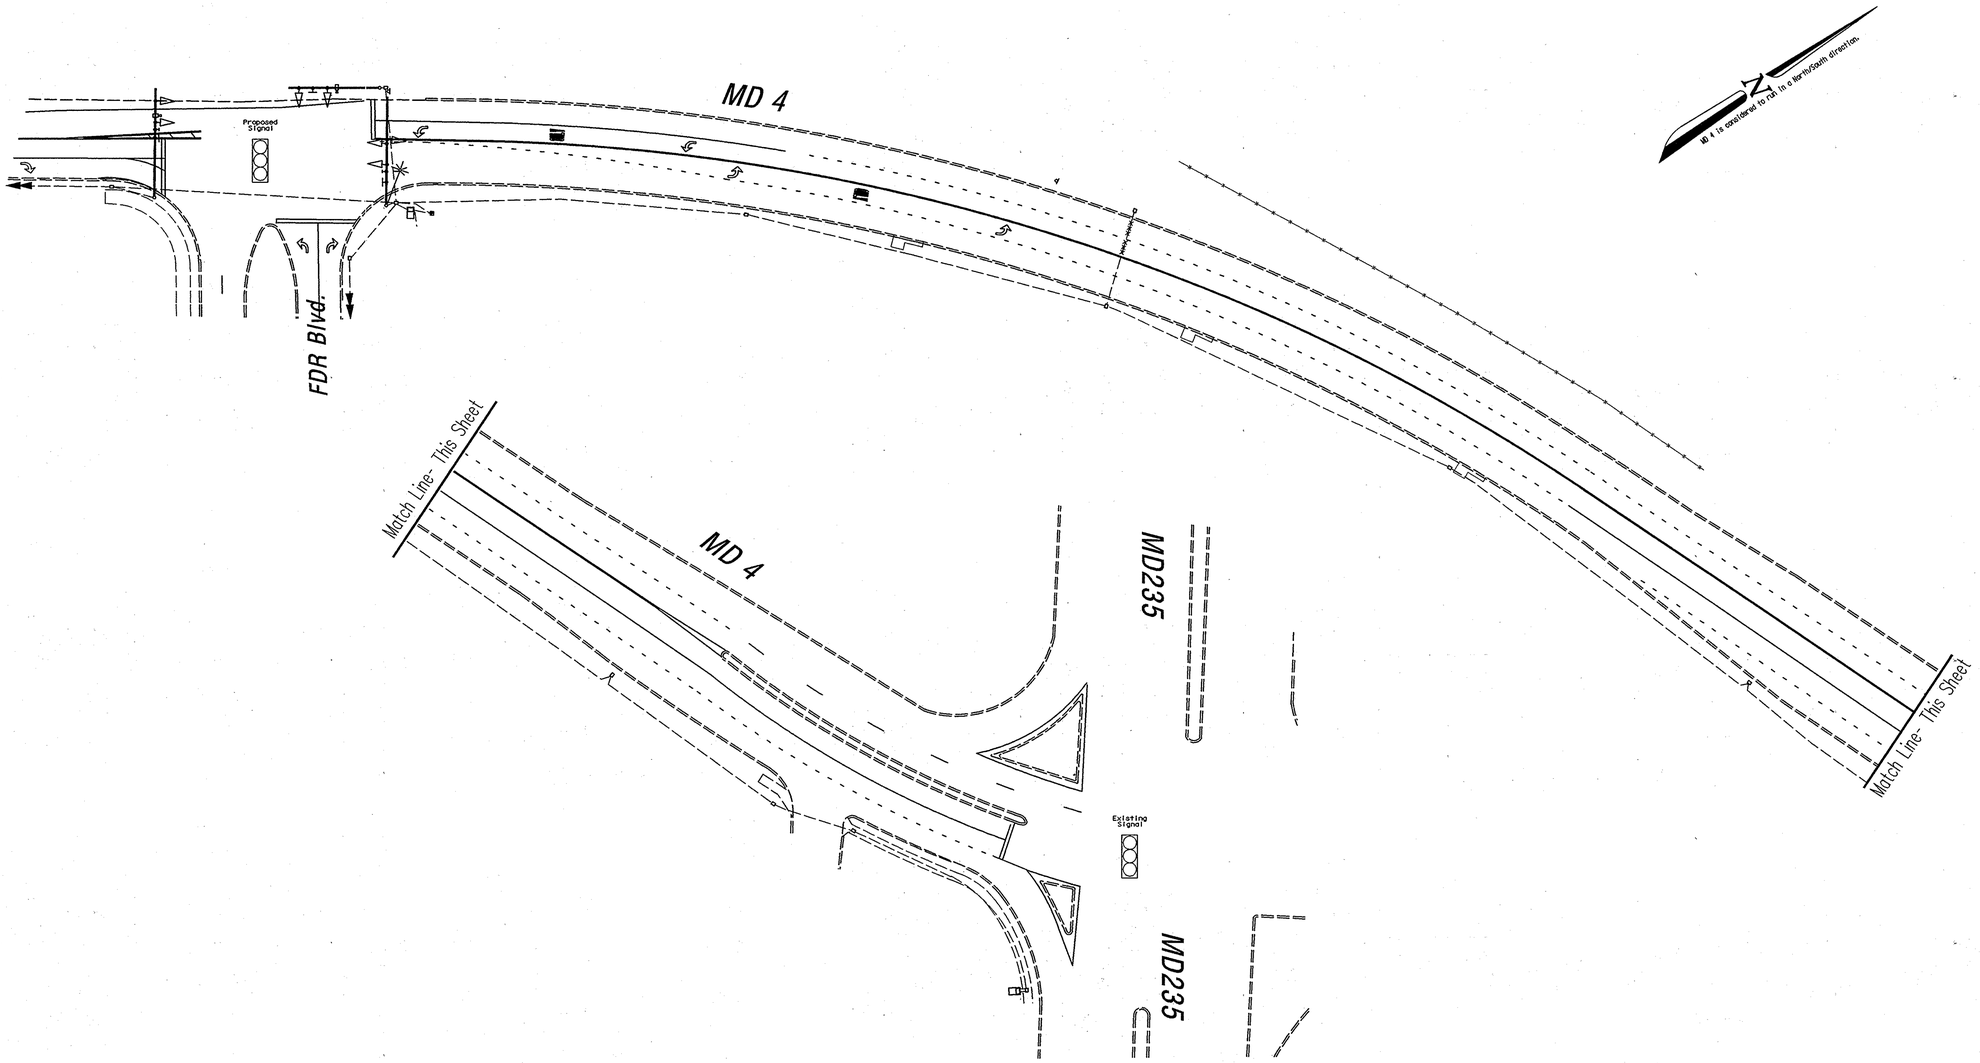

As-Built

GEOMETRIC LEGEND	
	EXISTING GEOMETRICS
	PROPOSED GEOMETRICS

UTILITY LEGEND	
G	GAS MAIN
W	WATER MAIN
S	SEWER MAIN
E	ELECTRIC CABLES
D	STORM DRAIN
A	AERIAL CABLES
T	TELEPHONE CABLES

The Traffic Group

The Traffic Group, Inc.
410-931-6600
Fax 410-931-6601

REVISIONS

As-Built April 6, 2007
S.H.A. No.: BW996M82
SED

APPROVALS

Original on File

TEAM LEADER, TRAFFIC ENGINEERING DESIGN DIVISION

ASST. CHIEF TRAFFIC ENGINEERING DESIGN DIVISION

CHIEF, TRAFFIC ENGINEERING DESIGN DIVISION

DIRECTOR, TRAFFIC & SAFETY

MARYLAND DOT - STATE HIGHWAY ADMINISTRATION
Office of Traffic & Safety
TRAFFIC ENGINEERING DESIGN DIVISION
(Interconnect Plan)

MD 4 From FDR Blvd to MD 235

DRAWN BY:	Frank Hoeckel	F.A.P. NO.	N/A	TS NO. IC-4465	SHEET NO.
CHECKED BY:		S.H.A. NO.	BW996M82		
SCALE:	1" = 40'	COUNTY:	St. Mary's	T.I.M.S. NO. H-464	2 OF 2
DATE:	February 6, 2006	LOG MILE:	18000405.85		

o:\Jobs\2001\2001-1002s\DESIGN\FDR As-built\IC-MD4-FDR-MD235.dgn 4/6/2007