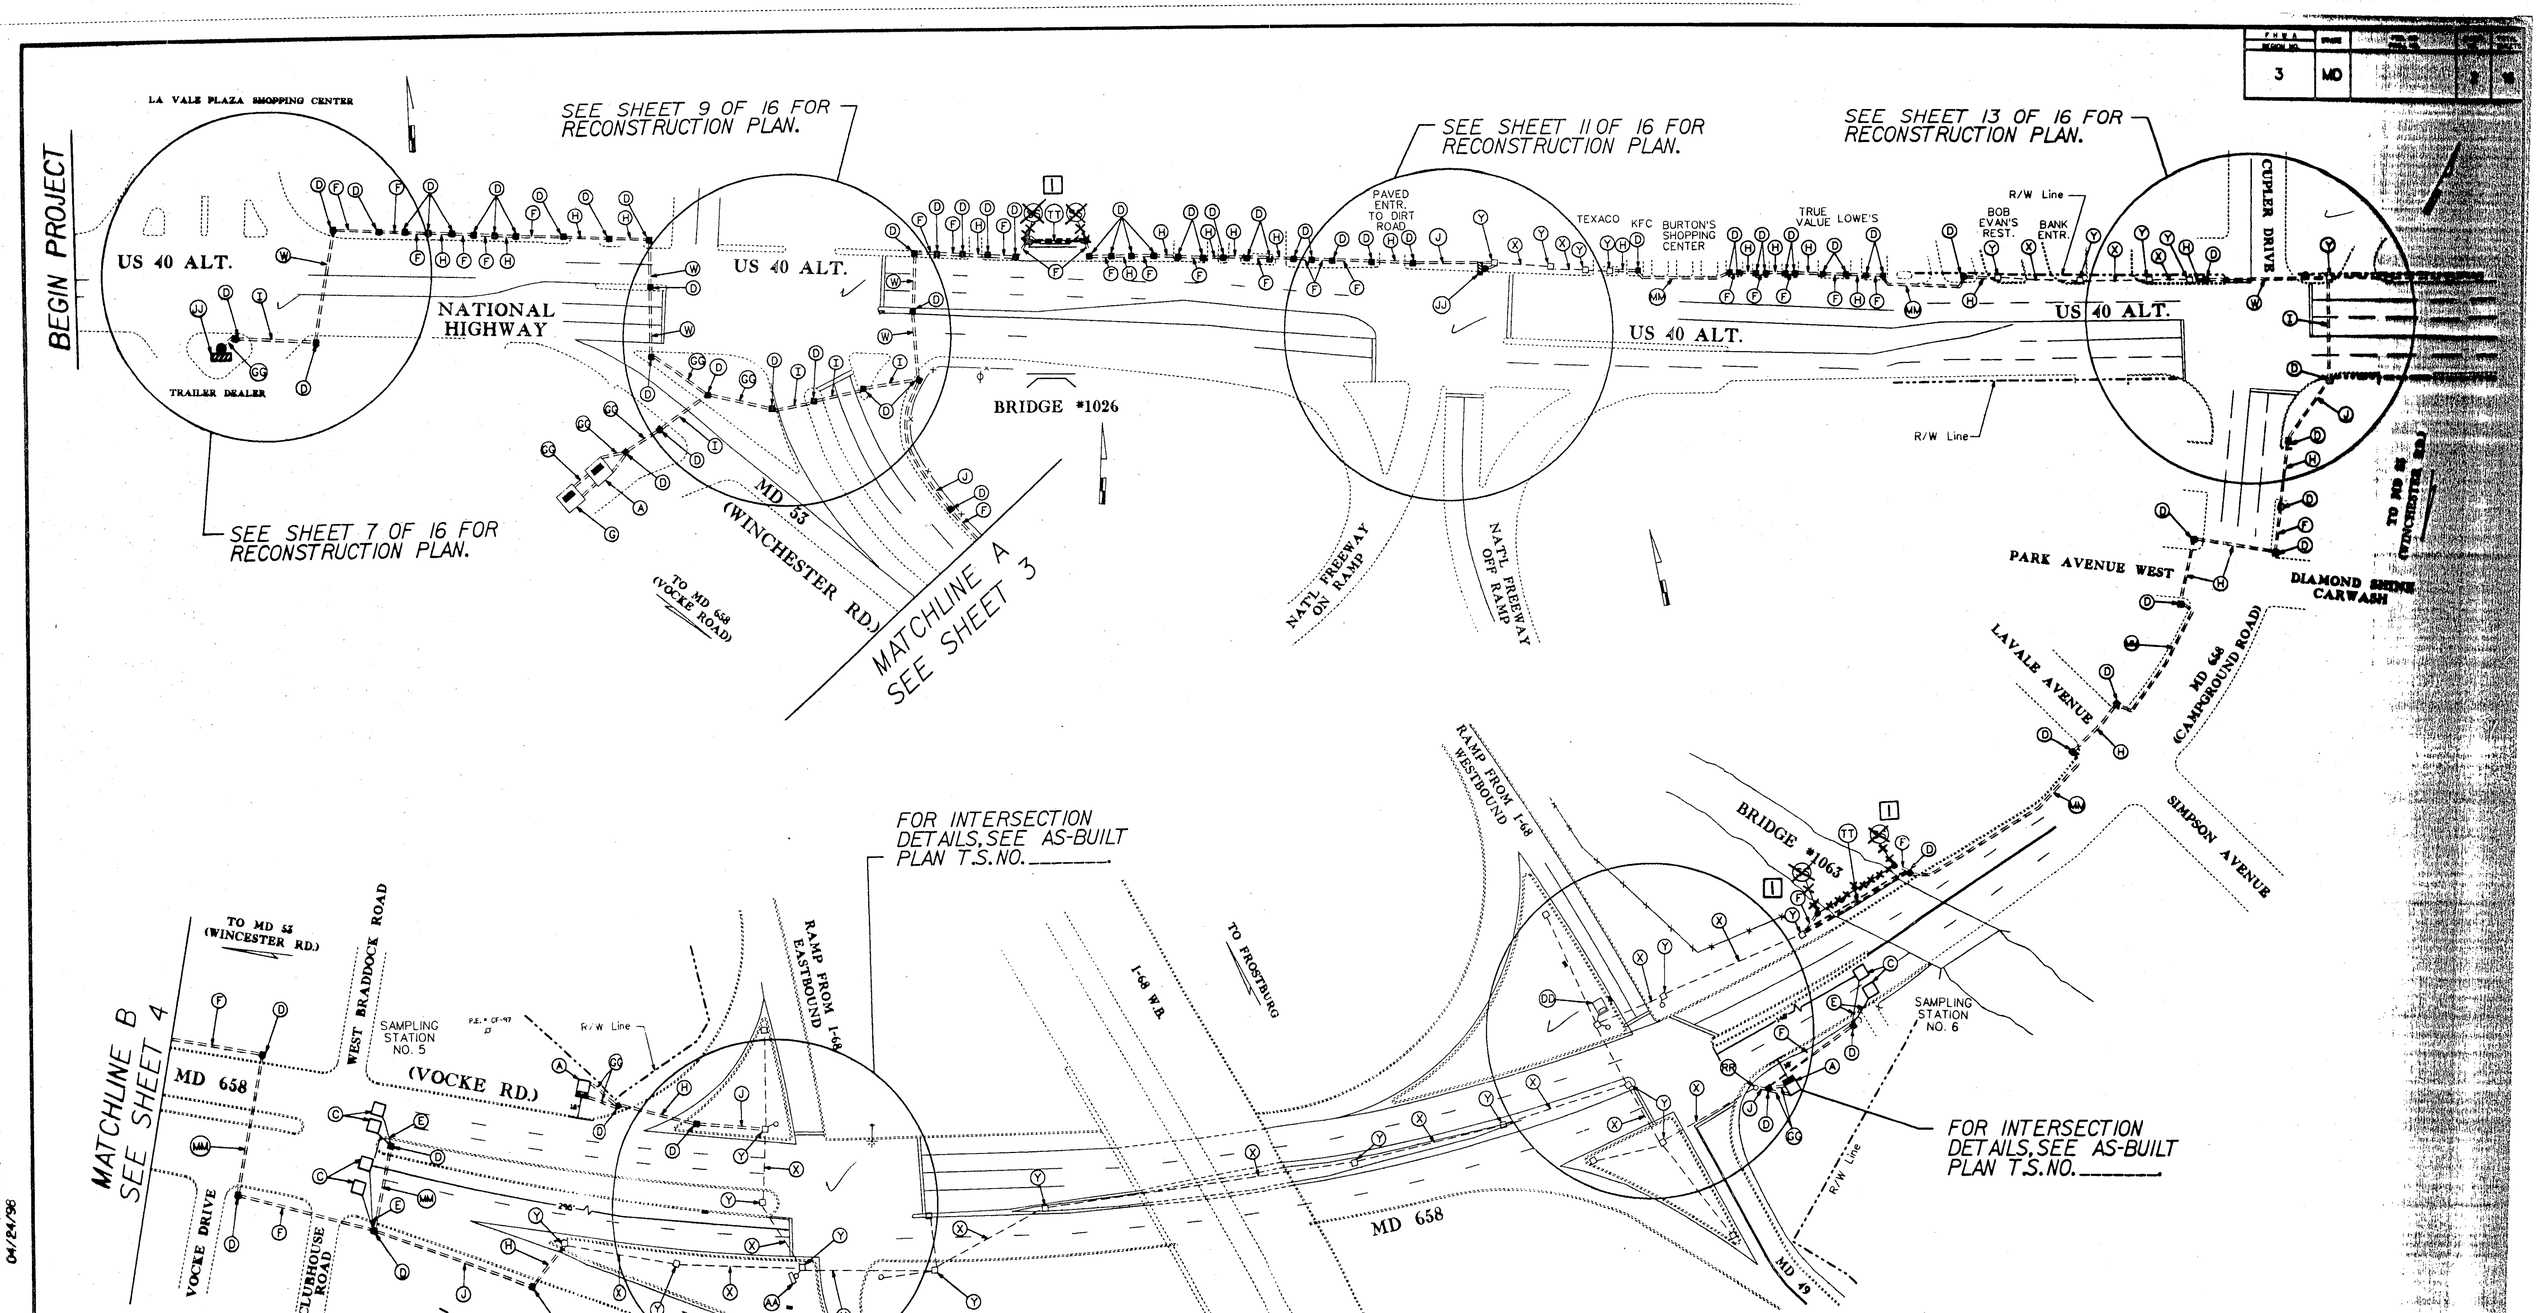

FHWA REGION NO.	STATE			
3	MD			

Sverdrup
CIVIL, INC.
CONSULTING ENGINEERS
575 South Charles Street
Suite 404
Baltimore, Maryland 21201
Tel. (410) 837-5840

REVISIONS
1 Red Line Revision No. 1 Install New Bridge Conduit July 1998

APPROVALS
ASST. DIVISION CHIEF, DESIGN SECTION
ASST. DISTRICT ENGINEER, TRAFFIC
CHIEF, TRAFFIC ENGINEERING DESIGN DIVISION
DIRECTOR, TRAFFIC & SAFETY

MARYLAND DOT - STATE HIGHWAY ADMINISTRATION
Office of Traffic & Safety
TRAFFIC ENGINEERING DESIGN DIVISION
U.S. 40 ALT.: MD 53 TO MD 658
INTERCONNECTION PLAN
DATE: APRIL 199

DRAWN BY: S.A.	F.A.P. NO. CM-STP-000S(502)E	T.S. NO.	2 OF 16
CHECK BY: R.D.	S.H.A. NO. AW-113-502-085		
SCALE: NOT TO SCALE	COUNTY ALLEGANY		

Plot Requested by: ~/system/scanface/svr_amps.dot.01/300;Arcnfnt,Sansse W
04/24/96
:\PLOTFILE\PAPER\CPLAN\.PRF
:\2010\3\cadd\x\x20\sa0\us40.dgn