F.H.W.A. REGION NO.	STATE	FED. AID PROJ. NO.	SHEET NO.	TOTAL SHEETS
3	MD.			

REVISION "B"

NOTE:
1) THIS IS A REVISION TO A JOB DONE UNDER CONTRACT NO. A-575X-000-685
2) ALL STRIPPING IS SHOWN AS EXISTS IN FIELD.

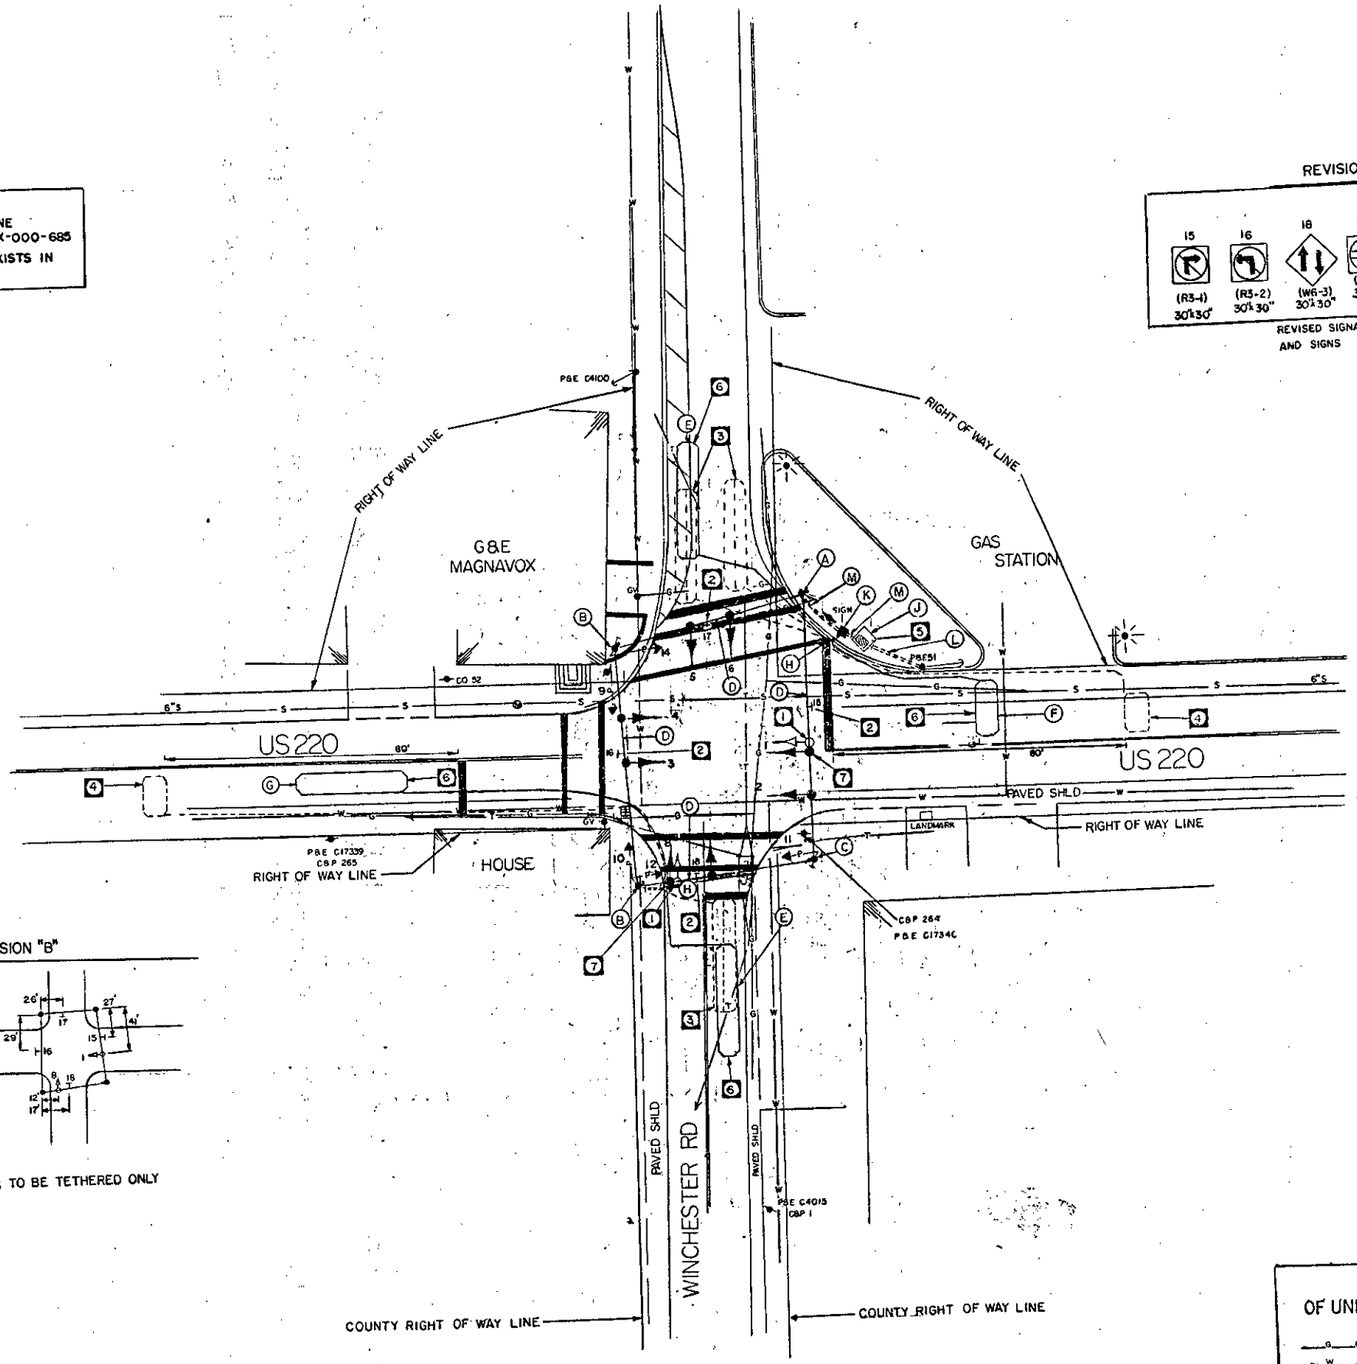

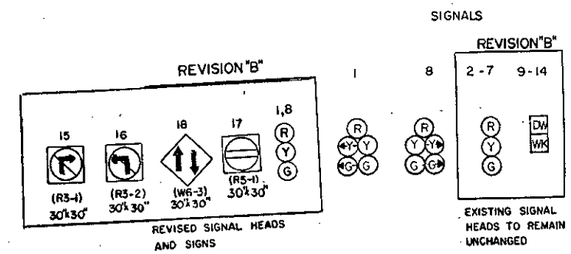

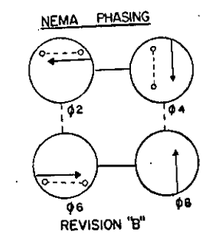

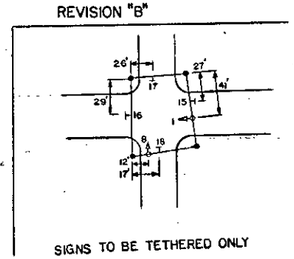

SIGNS TO BE TETHERED ONLY

LEGEND OF UNDERGROUND UTILITIES

G G	GAS MAIN
W W	WATER MAIN
S S	SEWER MAIN
E E	ELECTRIC CABLES
T T	TELEPHONE CABLES
A A	AERIAL CABLES

APPROVAL: REGIONAL TRAFFIC ENGINEER

APPROVAL: CHIEF BUREAU OF TRAFFIC ENGINEERING 7/18/74

APPROVAL: ASS'T. CHIEF ENGINEER TRAFFIC 7/14/74

(B) ADJUST SIGNAL HEAD AND LOOP DETECTION 9-9-83

A 5-3-75
ASBUILT
A-575X-000-685

RTB

REVISIONS

STATE OF MARYLAND
DEPARTMENT OF TRANSPORTATION
STATE HIGHWAY ADMINISTRATION

TRAFFIC DIVISION – BUREAU OF TRAFFIC ENGINEERING

US 220 & MD 53
(CRESAPTOWN)

SCALE 1" = 20' DATE 5-29-73 CONTRACT NO.

DRAWN BY: M LINARDI COUNTY: ALLEGANY

DESIGNED BY: Bruce Thompson SIGNAL NO.: 01108

CHECKED BY: A. Bodrichuk 7-18-74

DRAWING NO. TS-516B

01022014-00