


BORDER REV. DATE: JUNE 1, 2004

DRILL HOLES

DRILL HOLES

DRILL HOLES

US 220 IS CONSIDERED TO RUN IN A NORTH-SOUTH DIRECTION.

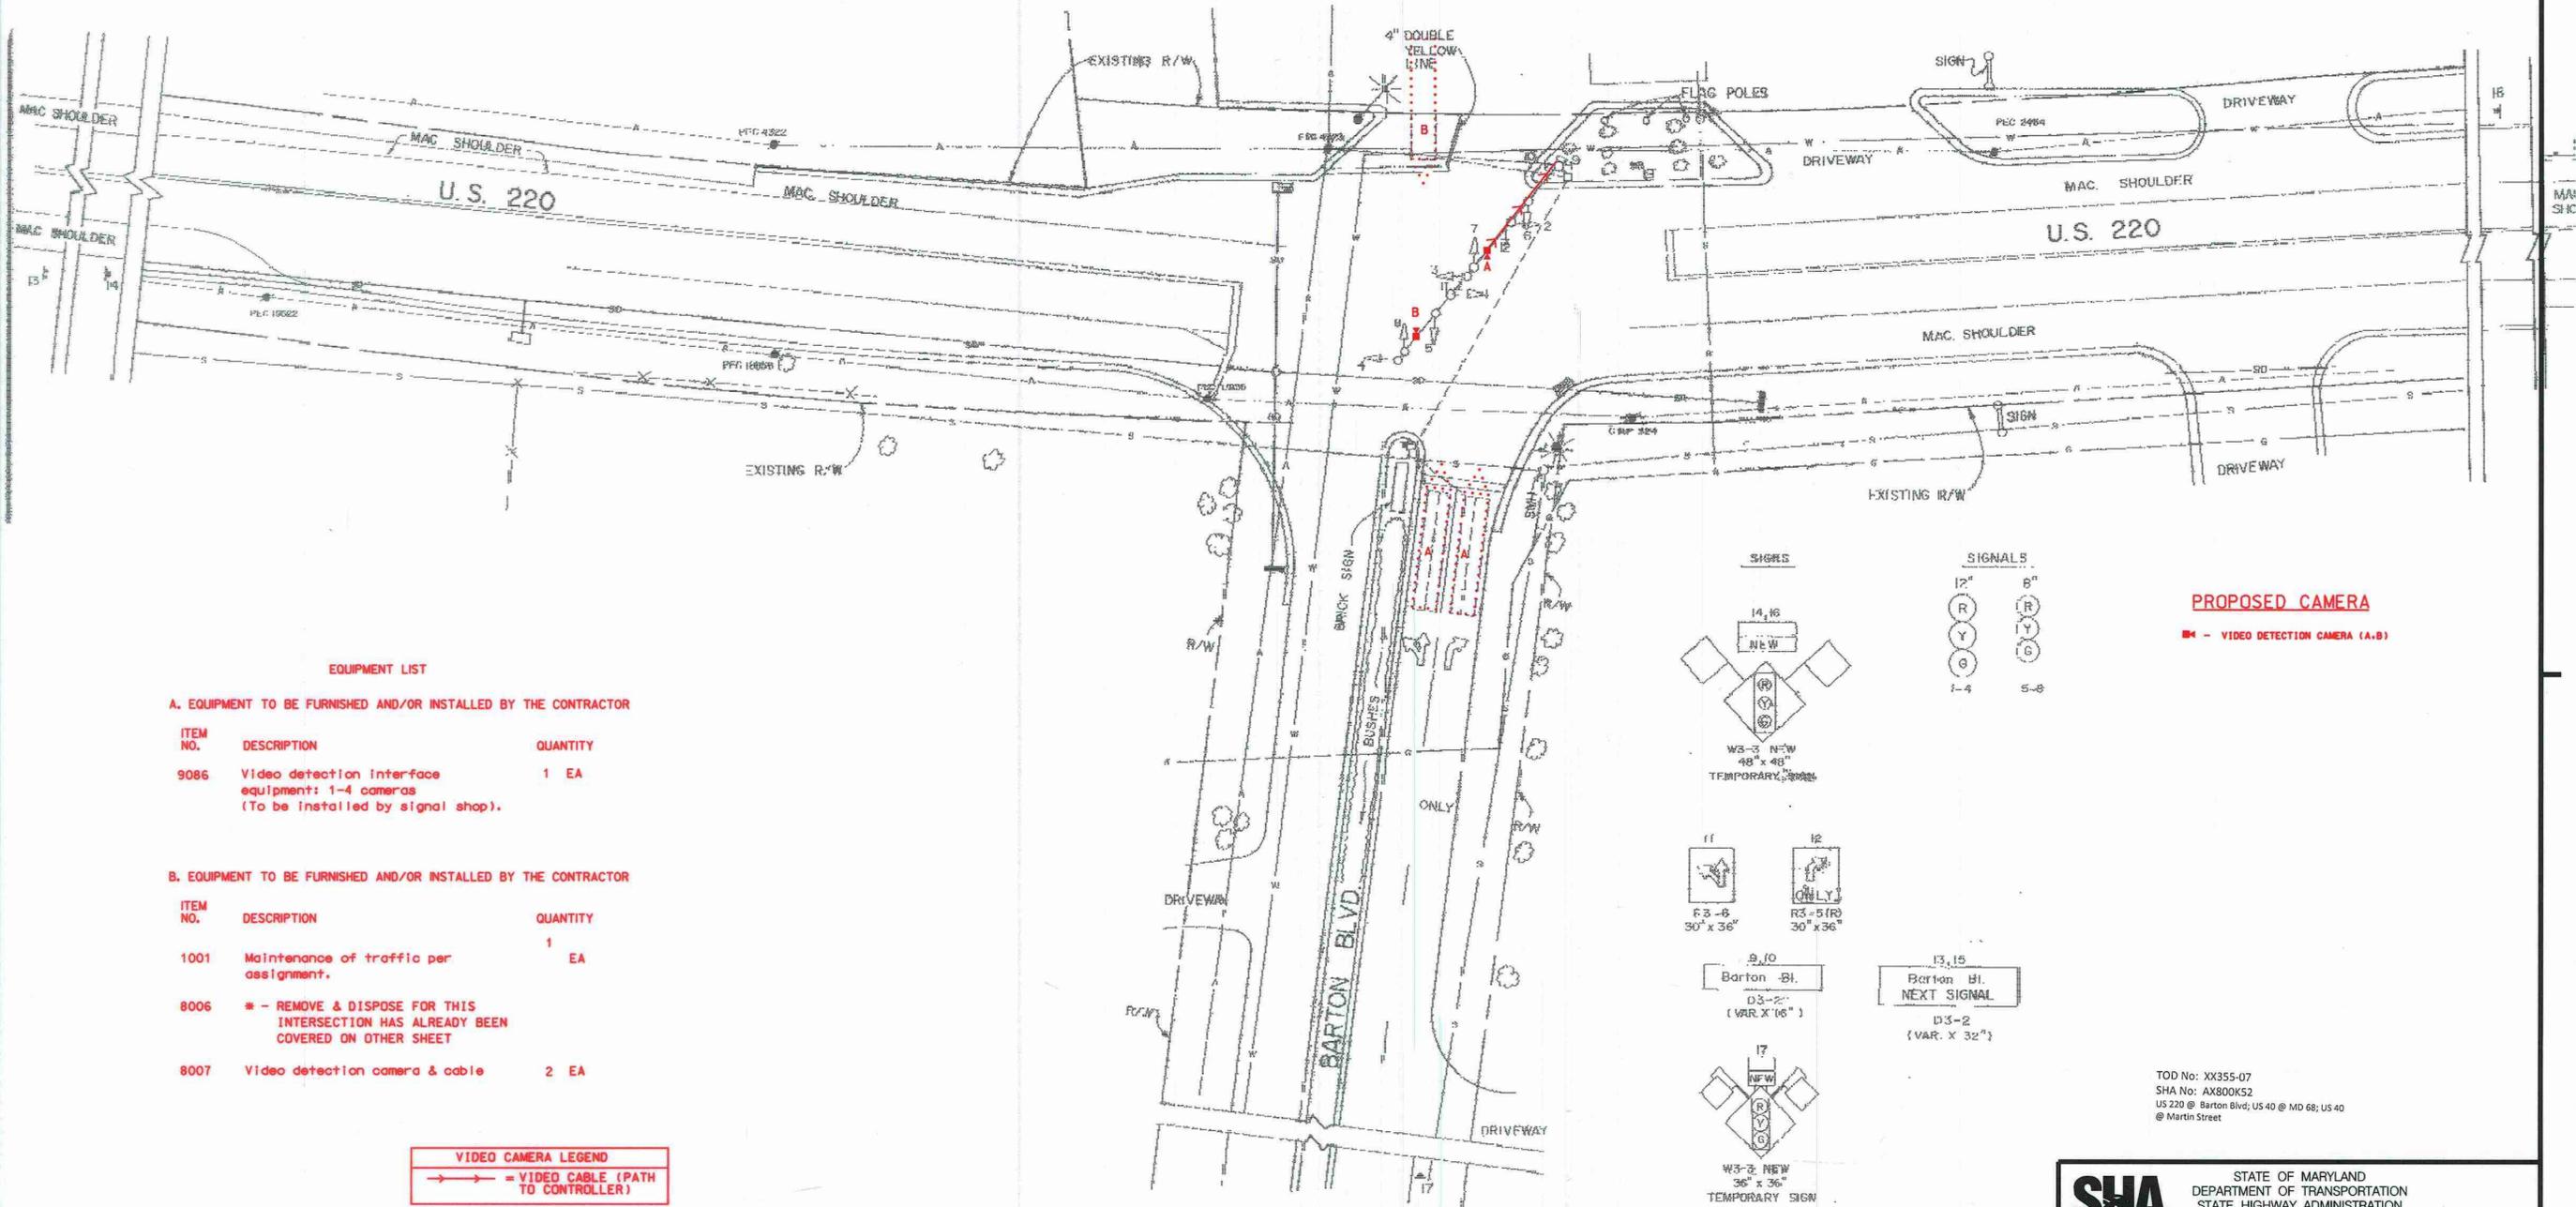

EQUIPMENT LIST

A. EQUIPMENT TO BE FURNISHED AND/OR INSTALLED BY THE CONTRACTOR

ITEM NO.	DESCRIPTION	QUANTITY
9086	Video detection interface equipment: 1-4 cameras (To be installed by signal shop).	1 EA

B. EQUIPMENT TO BE FURNISHED AND/OR INSTALLED BY THE CONTRACTOR

ITEM NO.	DESCRIPTION	QUANTITY
1001	Maintenance of traffic per assignment.	1 EA
8006	* - REMOVE & DISPOSE FOR THIS INTERSECTION HAS ALREADY BEEN COVERED ON OTHER SHEET	
8007	Video detection camera & cable	2 EA



GENERAL NOTES


1. VIDEO CAMERA LOCATION / ALIGNING SHALL BE COORDINATED WITH THE SHA ENGINEER.
2. THE CONTRACTOR SHALL BE RESPONSIBLE FOR TERMINATING ALL VIDEO DETECTION CAMERA CABLES TO THE APPROPRIATE TERMINALS AND PROPERLY LABEL EACH CABLE SO THAT SHA FORCES CAN MAKE THE FINAL CONNECTIONS.
3. THE INSTALLATION OF PROPOSED VIDEO DETECTION EQUIPMENT SHALL NECESSITATE THE REMOVAL OF EXISTING CABLES ASSOCIATED WITH THE PRESENCE LOOP DETECTORS BEING REPLACED BY VIDEO DETECTION.
4. ALL EXISTING TRAFFIC SIGNAL EQUIPMENT REMOVED SHALL BECOME THE PROPERTY OF THE SIGNAL CONTRACTOR UPON COMPLETION OF THE SIGNAL MODIFICATION.
5. ALL UNUSED SIGNAL CABLES SHALL BE REMOVED AND DISPOSED.

GEOMETRIC LEGEND

PROPOSED _____
EXISTING _____

LEGEND OF UNDERGROUND AND OVERHEAD UTILITIES

AERIAL CABLE	A	A
ELECTRIC	E	E
TELEPHONE	T	T
GAS	G	G
SEWER	S	S
WATER	W	W
CABLE TV	TV	TV

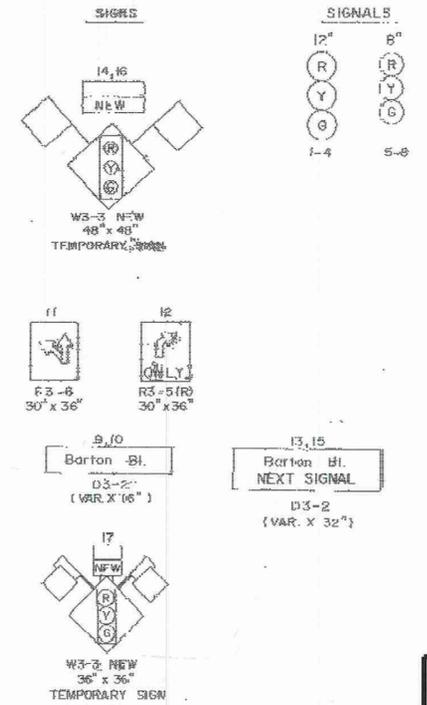

PROPOSED CAMERA
A - VIDEO DETECTION CAMERA (A-B)

TOD No: XX355-07
SHA No: AX800K52
US 220 @ Barton Blvd; US 40 @ MD 68; US 40 @ Martin Street

SHA STATE OF MARYLAND
DEPARTMENT OF TRANSPORTATION
STATE HIGHWAY ADMINISTRATION
US 220 AT BARTON BLVD

REVISION "A"

STREET TRAFFIC STUDIES, LTD.
400 Crain Hwy. NW
Glen Burnie, MD 21061
Ph 410 586-5520
Fax 410 586-6637

APPROVALS	
TEAM LEADER	
ASST. DIV. CHIEF	
DIVISION CHIEF	
OFFICE DIRECTOR	

REVISIONS	

TRAFFIC SIGNAL PLAN			
SCALE 1"=20'		DATE JAN. 1990 CONTRACT NO.	
DESIGNED BY	J. MALINOWSKI	COUNTY	ALLEGANY
DRAWN BY	L. TAUBER	LOGMILE	01022012-52
CHECKED BY		TIMS NO.	
F.A.P. NO.		TOD NO.	
TS NO. 2621A	DRAWING NO. 1 OF 1	SHEET NO.	OF

PLOTTED: #DATE#
FILE: #FILE#

.../SHA/STST/08178.dgn 7/27/2010 11:42:48 AM