F.H.W.A. REGION NO.	STATE	FED. AID PROJ. NO.	SHEET NO.	TOTAL SHEETS
3	MD.			

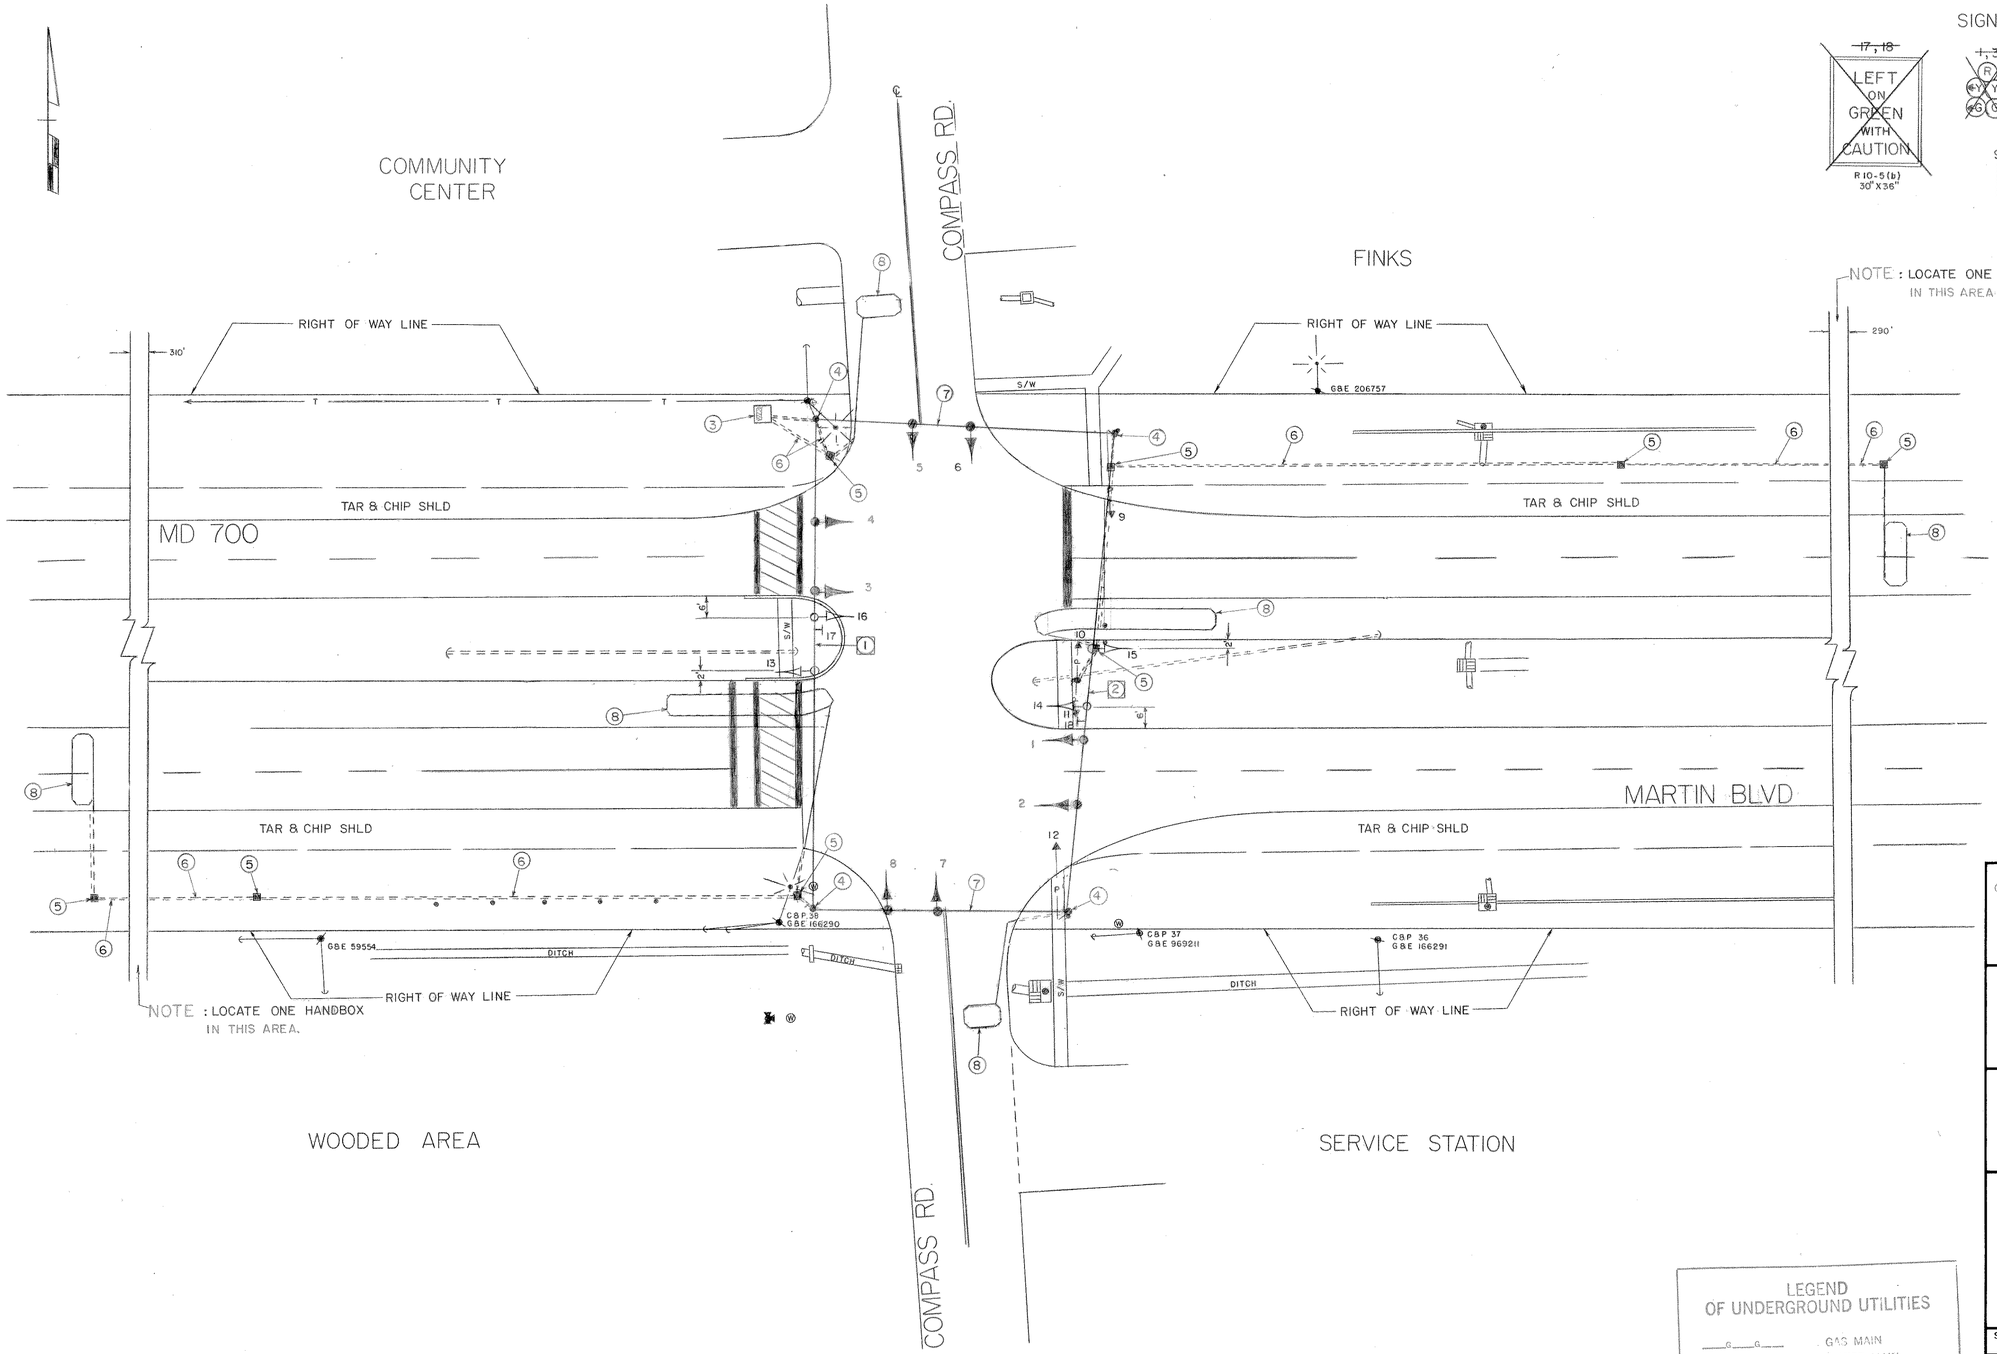

SIGNALS

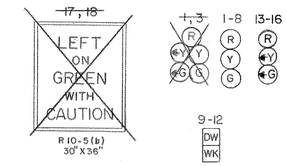

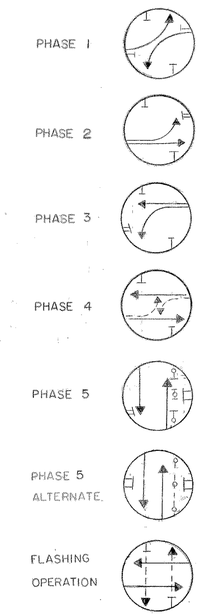

LEGEND OF UNDERGROUND UTILITIES

G G	GAS MAIN
W W	WATER MAIN
S S	SEWER MAIN
E E	ELECTRIC CABLES
T T	TELEPHONE CABLES
A A	AERIAL CABLES

APPROVAL: REGIONAL TRAFFIC ENGINEER — 9/27/74

APPROVAL: CHIEF BUREAU OF TRAFFIC ENGINEERING — 9/27/74

APPROVAL: ASS'T. CHIEF ENGINEER TRAFFIC — 9/30/74

B — AUG 2, 1983 — CHANGE MD 700 LEFT TURNS FROM E/P TO EXCLUSIVE. AW 679-501-085

A — 9/19/75 — ASBUILT B 201X-000-485

WEMS

REVISIONS

STATE OF MARYLAND
DEPARTMENT OF TRANSPORTATION
STATE HIGHWAY ADMINISTRATION

TRAFFIC DIVISION – BUREAU OF TRAFFIC ENGINEERING

MD 700 (MARTIN BLVD.) & COMPASS RD.

SCALE	DATE	CONTRACT NO.
1"=20'	9/9/74	AW 679-501-085

DRAWN BY: R. BRITTON — COUNTY: BALTIMORE

DESIGNED BY: R.J. Britt — SIGNAL NO.:

CHECKED BY: A. Budnichuk

DRAWING NO. TS-501 B

BRUNING 44511 19927