MD 7 IS ASSUMED TO RUN IN AN EAST-WEST DIRECTION

EXISTING SIGNS TO REMAIN

16,18 — R3-5(L) 30" x 36"
19 — R3-5(1) 30" x 36"
20,21 — R10-4(1) 9" x 12"
14 — NORTH 695
13,15 — R10-12 36" x 42"
22 — DO NOT ENTER
23 — SOUTH 695
24 — NORTH 695
25 — TO 95
26 — SOUTH 695
27 — NORTH 695
28 — TO 95

PROPOSED SIGN

17 — R3-6 30"X36"

EXISTING SIGN TO BE REMOVED

29 — R3-5(1) 30" x 36"

EXISTING SIGNALS TO REMAIN

1,3 — 12"
4 — 12"
2,6,8 — 12"
5,7 — 12"
9-12 — 12"

NEMA PHASING

Ø1 Ø2 Ø3 Ø4 Ø4 ALT. Ø5 Ø6

FLASHING OPERATION

NOTE:
PHASES ASSOCIATED BY A DASHED LINE WILL OPERATE CONCURRENTLY.
PHASES ASSOCIATED BY A SOLID LINE WILL NOT OPERATE CONCURRENTLY.

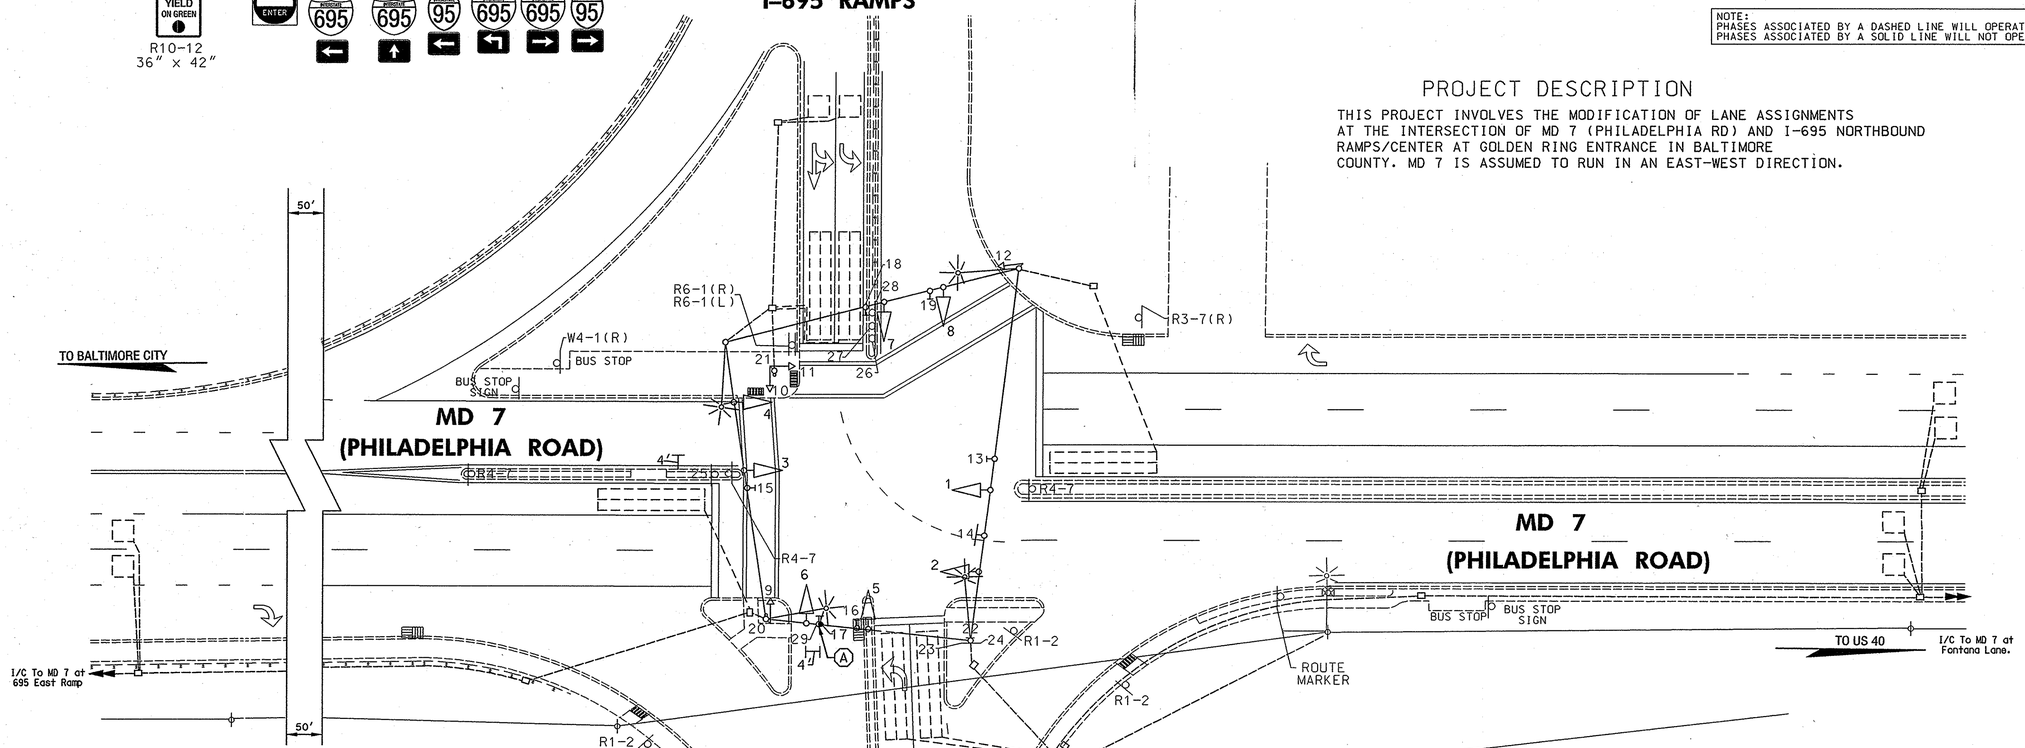

PROJECT DESCRIPTION

THIS PROJECT INVOLVES THE MODIFICATION OF LANE ASSIGNMENTS AT THE INTERSECTION OF MD 7 (PHILADELPHIA RD) AND I-695 NORTHBOUND RAMPS/CENTER AT GOLDEN RING ENTRANCE IN BALTIMORE COUNTY. MD 7 IS ASSUMED TO RUN IN AN EAST-WEST DIRECTION.

EQUIPMENT LIST "A"

A. EQUIPMENT TO BE SUPPLIED AND INSTALLED BY THE SHA.

CATEGORY CODE	DESCRIPTION	UNIT	QUANTITY
8001	SHEET ALUMINUM SPAN MOUNTED SIGN 1 - R3-6 (30"X36")	SF	7.5
8002	INSTALL OVERHEAD SIGN	SF	7.5

CONSTRUCTION DETAILS

A. REPLACE EXISTING SIGN WITH PROPOSED R3-6 SIGN AS SHOWN.

GEOMETRIC LEGEND
EXISTING
PROPOSED

UTILITY LEGEND
SD — STORM DRAIN
G — GAS MAIN
W — WATER MAIN
S — SEWER MAIN
E — ELECTRIC CABLES
A — AERIAL CABLES
T — TELEPHONE CABLES
F — FIBER-OPTIC

RUMMEL, KLEPPER & KAHL, LLP
CONSULTING ENGINEERS
81 MOSHER STREET
BALTIMORE, MARYLAND 21217
TELE:(410)728-2900 FAX:(410)383-3270

APPROVALS
TEAM LEADER
ASST. DIV. CHIEF
DIVISION CHIEF
OFFICE DIRECTOR
ORIGINAL ON FILE

REVISIONS
H — MODIFY I-695 N.B. RAMPS TO SHARED LEFT AND THRU LANES — SHOP FORCES — NOVEMBER 2007 — MLH
G — ASBUILT — NOVEMBER 1, 2002 — RMD

STATE OF MARYLAND
DEPARTMENT OF TRANSPORTATION
STATE HIGHWAY ADMINISTRATION
OFFICE OF TRAFFIC & SAFETY
TRAFFIC ENGINEERING DESIGN DIVISION

MD 7 (PHILADELPHIA RD) AND I-695 N.B. RAMPS/ THE CENTER AT GOLDEN RING ENTRANCE
ROSEDALE, MARYLAND

TRAFFIC SIGNAL PLAN

SCALE 1"=20' DATE MARCH 12, 1982 CONTRACT NO.
DESIGNED BY E.M. MILESKY
DRAWN BY E.M. MILESKY
CHECKED BY STEVE RENZI
FAP NO.
COUNTY BALTIMORE
LOGMILE 0300000702.52
TIMS NO. I-635
TOD NO.
TS NO. 1187-H DRAWING SP-01 OF 01 SHEET NO. 1 OF 1

PLOTTED: Friday, November 30, 2007 AT 05:46 AM
FILE: K:\projects\104-154\Task117\CADD\MD 7 @ I-695 Ramp Goldenring Plaza SP.dgn