F.H.WA. REGION NO.	STATE	FED. AID PROJ. NO.	SHEET NO.	TOTAL SHEETS
3	MD.			

NOTE: (A) STRIPING SHOWN IS PROPOSED

SIGNALS

1-4 (R) (Y) (G)

5&6 (R) (Y) (G)

PHASE A

PHASE B

FLASHING OPERATION

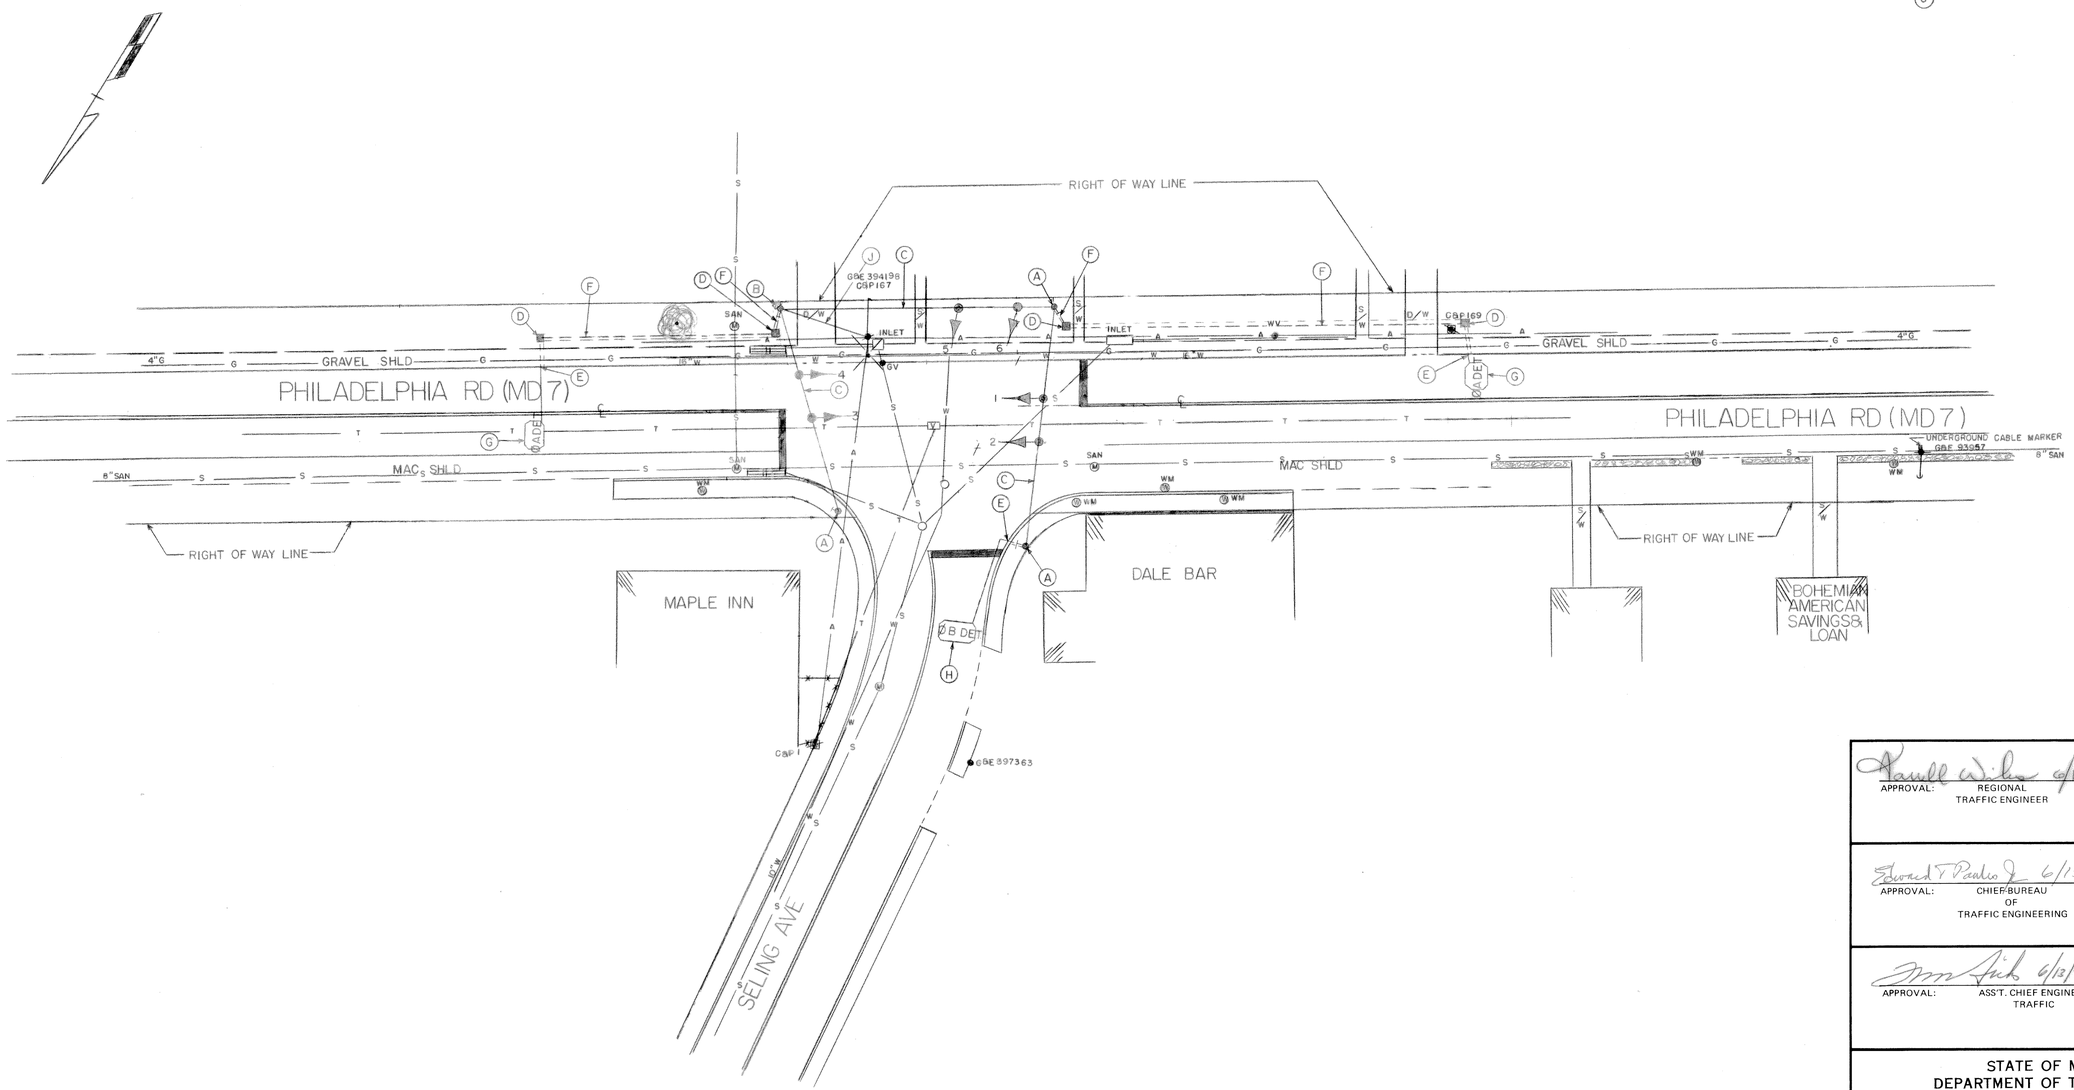

LEGEND OF UNDERGROUND UTILITIES

G G	GAS MAIN
W W	WATER MAIN
S S	SEWER MAIN
E E	ELECTRIC CABLES
T T	TELEPHONE CABLES
A A	AERIAL CABLES

APPROVAL: Harrell Wilson 6/13/74 REGIONAL TRAFFIC ENGINEER

APPROVAL: Edward T Paulus Jr 6/13/74 CHIEF BUREAU OF TRAFFIC ENGINEERING

APPROVAL: [signature] 6/13/74 ASS'T. CHIEF ENGINEER TRAFFIC

A 12-27-74 ASBUILT B 295X-000-485

D.Z. [initials]

REVISIONS

STATE OF MARYLAND
DEPARTMENT OF TRANSPORTATION
STATE HIGHWAY ADMINISTRATION

TRAFFIC DIVISION – BUREAU OF TRAFFIC ENGINEERING

MD7 (PHILADELPHIA RD) & SELING AVE

SCALE 1" = 20' DATE 6-19-73 CONTRACT NO.

DRAWN BY: B TYSON COUNTY: BALTIMORE

DESIGNED BY: D.J. Dodge Jr. SIGNAL NO.: 03272

CHECKED BY: A. Budnichuk

DRAWING NO. TS-959A

BRUNING 44-511 19927