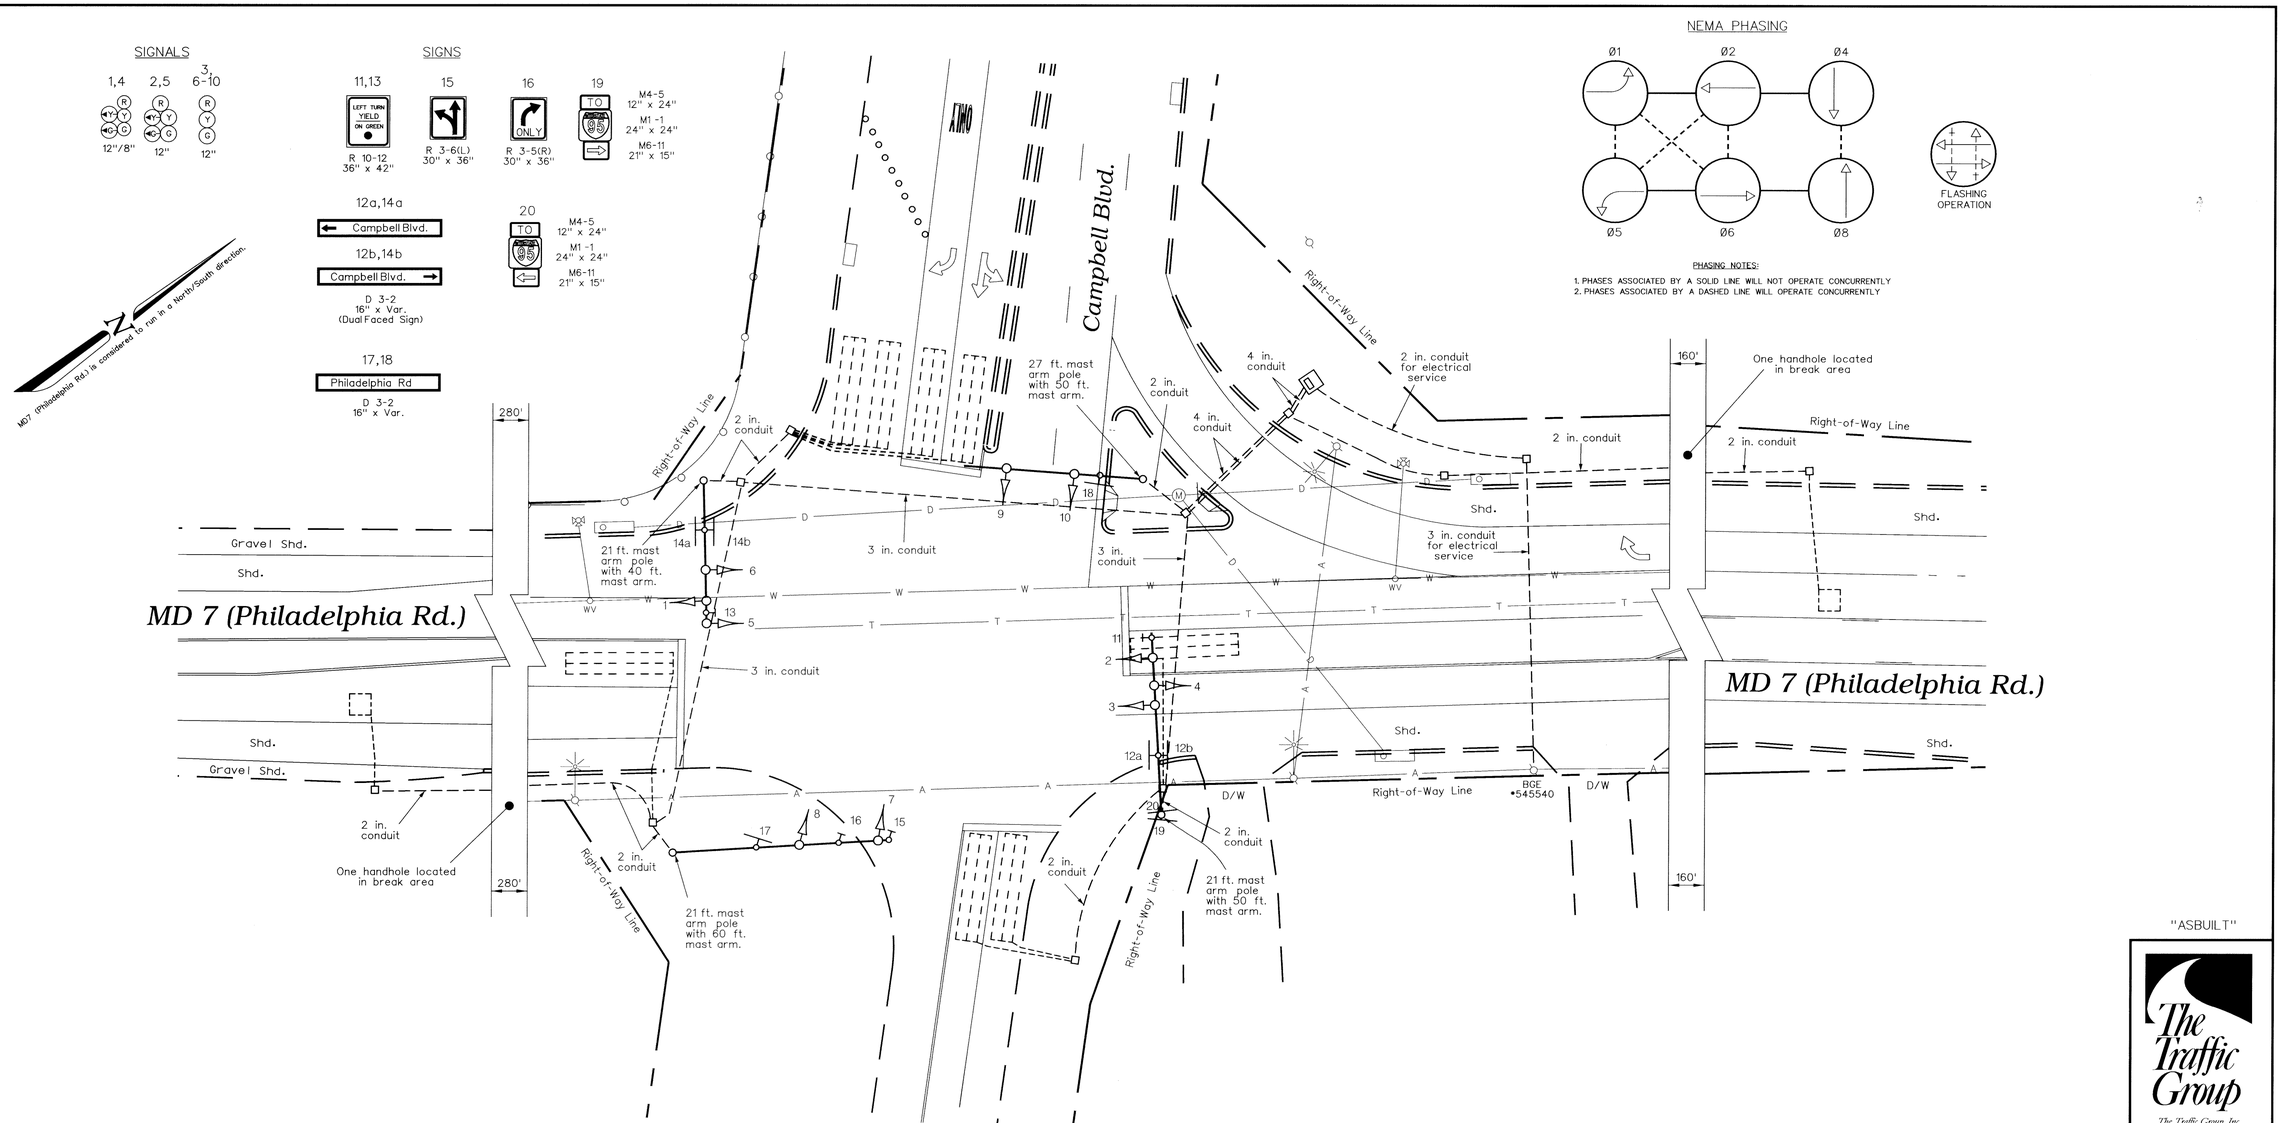

CARMAX
Truck Entrance

"ASBUILT"

The Traffic Group
The Traffic Group, Inc.
Suite 600
40 W. Chesapeake Avenue
Towson, Maryland 21204
410-583-8405
1-800-583-8411
Fax 410-321-8458
Job No. 970107
ASBUILT.DGN

GEOMETRIC LEGEND

EXISTING GEOMETRICS
PROPOSED GEOMETRICS

UTILITY LEGEND

G — G	GAS MAIN
W — W	WATER MAIN
S — S	SEWER MAIN
E — E	ELECTRIC CABLES
D — D	STORM DRAIN
A — A	AERIAL CABLES
T — T	TELEPHONE CABLES

REVISIONS

Ⓑ ASBUILT — Febuary 10, 1999
S.H.A. No.:BW996M82
FJH

APPROVALS

ORIGINAL ON FILE

ASST. TRAFFIC ENGINEERING DESIGN DIVISION
ASST. DISTRICT ENGINEER - TRAFFIC
CHIEF, TRAFFIC ENGINEERING DESIGN DIVISION
DIRECTOR, OFFICE OF TRAFFIC & SAFETY

MDOT – STATE HIGHWAY ADMINISTRATION
Office of Traffic & Safety
TRAFFIC ENGINEERING DESIGN DIVISION
(Traffic Signal Plan)

MD 7 (Philadelphia Road) at Campbell Blvd. / CARMAX

LOG MILE • 03000706.01

DATE: February 23, 1995					
DRAWN BY:	A. A.	F.A.P. NO.	N/A	PLAN SHEET NO.: 3517B	SHEET NO. 1 of 1
CHK. BY:	J. A. B.	S.H.A. NO.	BW789-802-412		
SCALE:	1" = 20'	COUNTY:	BALTIMORE		

66 833 21 dgn:\SHA\BW\L20\26\V3