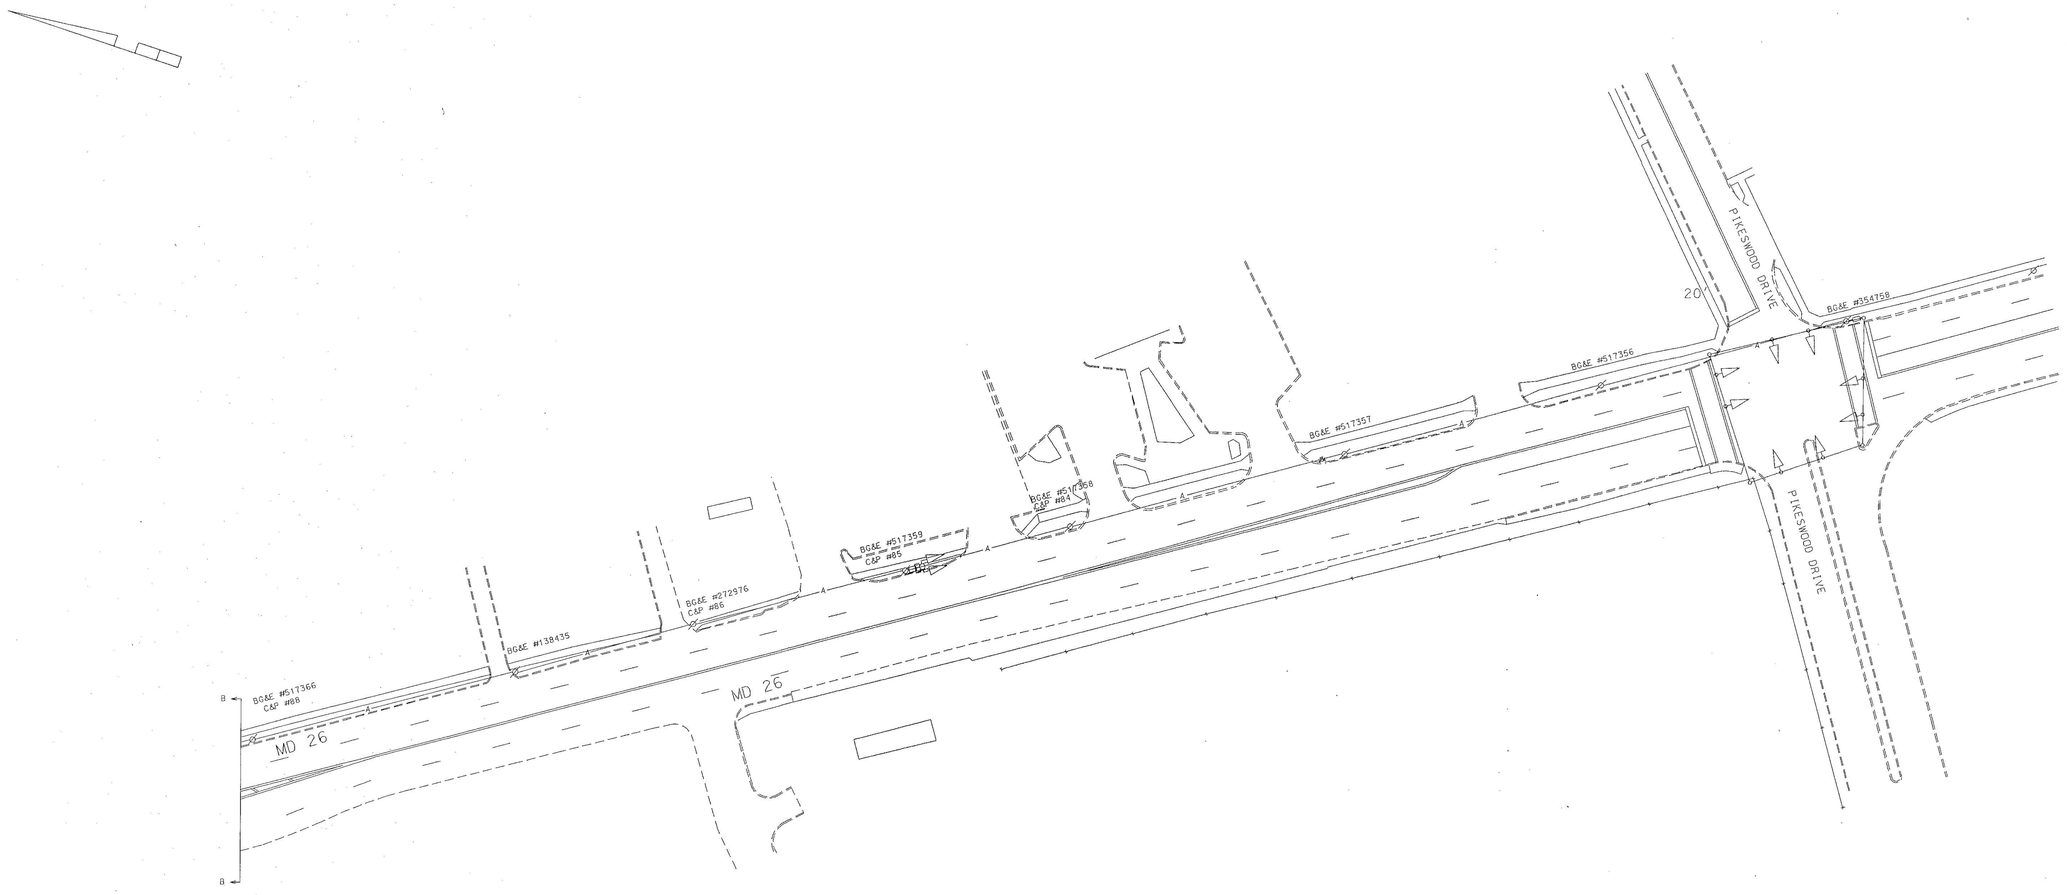

REVISIONS	APPROVALS
A . 11/1999 – AS BUILT	ORIGINAL ON FILE ASSISTANT DIVISION CHIEF, OSOD ASST. DISTRICT ENGINEER- TRAFFIC CHIEF, TRAFFIC ENGINEERING DESIGN DIVISION DIRECTOR, OFFICE OF TRAFFIC AND SAFETY

MARYLAND DOT - STATE HIGHWAY ADMINISTRATION

Office of Traffic & Safety

TRAFFIC ENGINEERING DESIGN DIVISION

MD 26: TIVERTON ROAD TO PIKESWOOD DRIVE

RANDALLSTOWN, MARYLAND

DATE: 11/1999

DRAWN BY:	F.A.P. NO.	PLAN SHEET NO.:	SHEET NO.
DES. BY:	S.H.A. NO.	~~TS 3874 A~~	2 OF 3
CHECK BY:	COUNTY BALTIMORE		
SCALE: 1" = 40'			

TS-12428 A