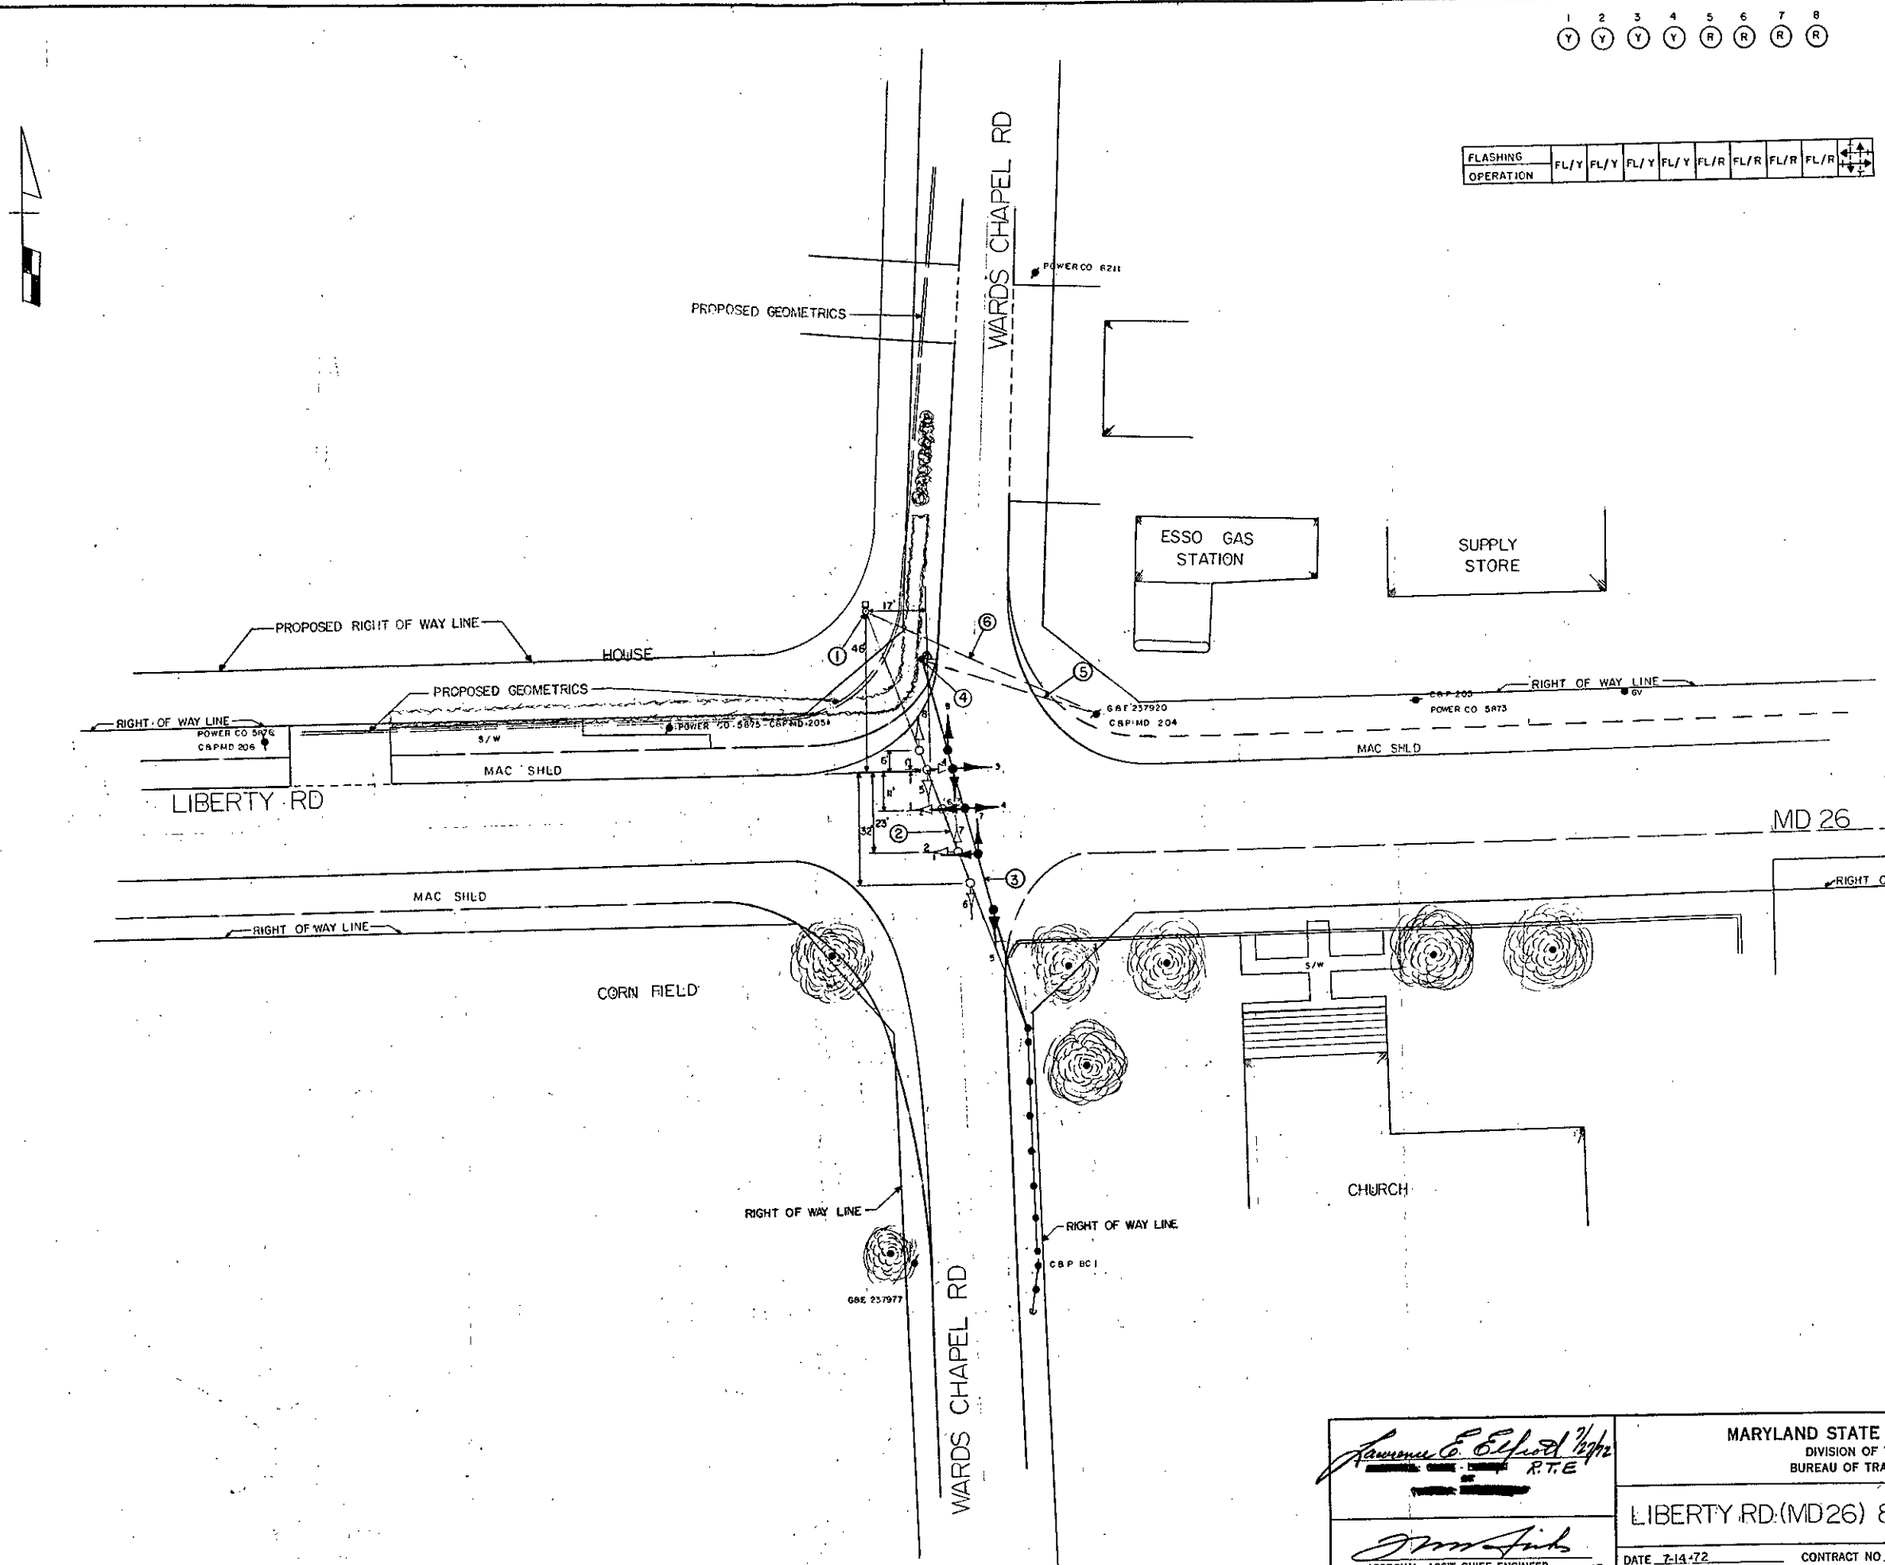

B	12-10-80 REVISED DUE TO CONSTRUCTION BW 529-801-412
A	8/11/75 ASBUILT B-206X-485
WEM	CTS A.B.

REVISIONS

Lawrence E. Elfrod 7/27/72
[redacted] R.T.E
[redacted]

APPROVAL: ASS'T CHIEF ENGINEER TRAFFIC SAFETY 7-27-72

MARYLAND STATE ROADS COMMISSION
DIVISION OF TRAFFIC SAFETY
BUREAU OF TRAFFIC ENGINEERING

LIBERTY RD (MD 26) & WARDS CHAPEL RD
SIGNAL NO. 03257

DATE 7-14-72
SCALE 1"=20'
DRAWN BY: J BOLING (D.D.)
CONTRACT NO B-206X-485
COUNTY BALTIMORE
CHECKED BY:

DRAWING NO. TS 621 B

0300.2601.06