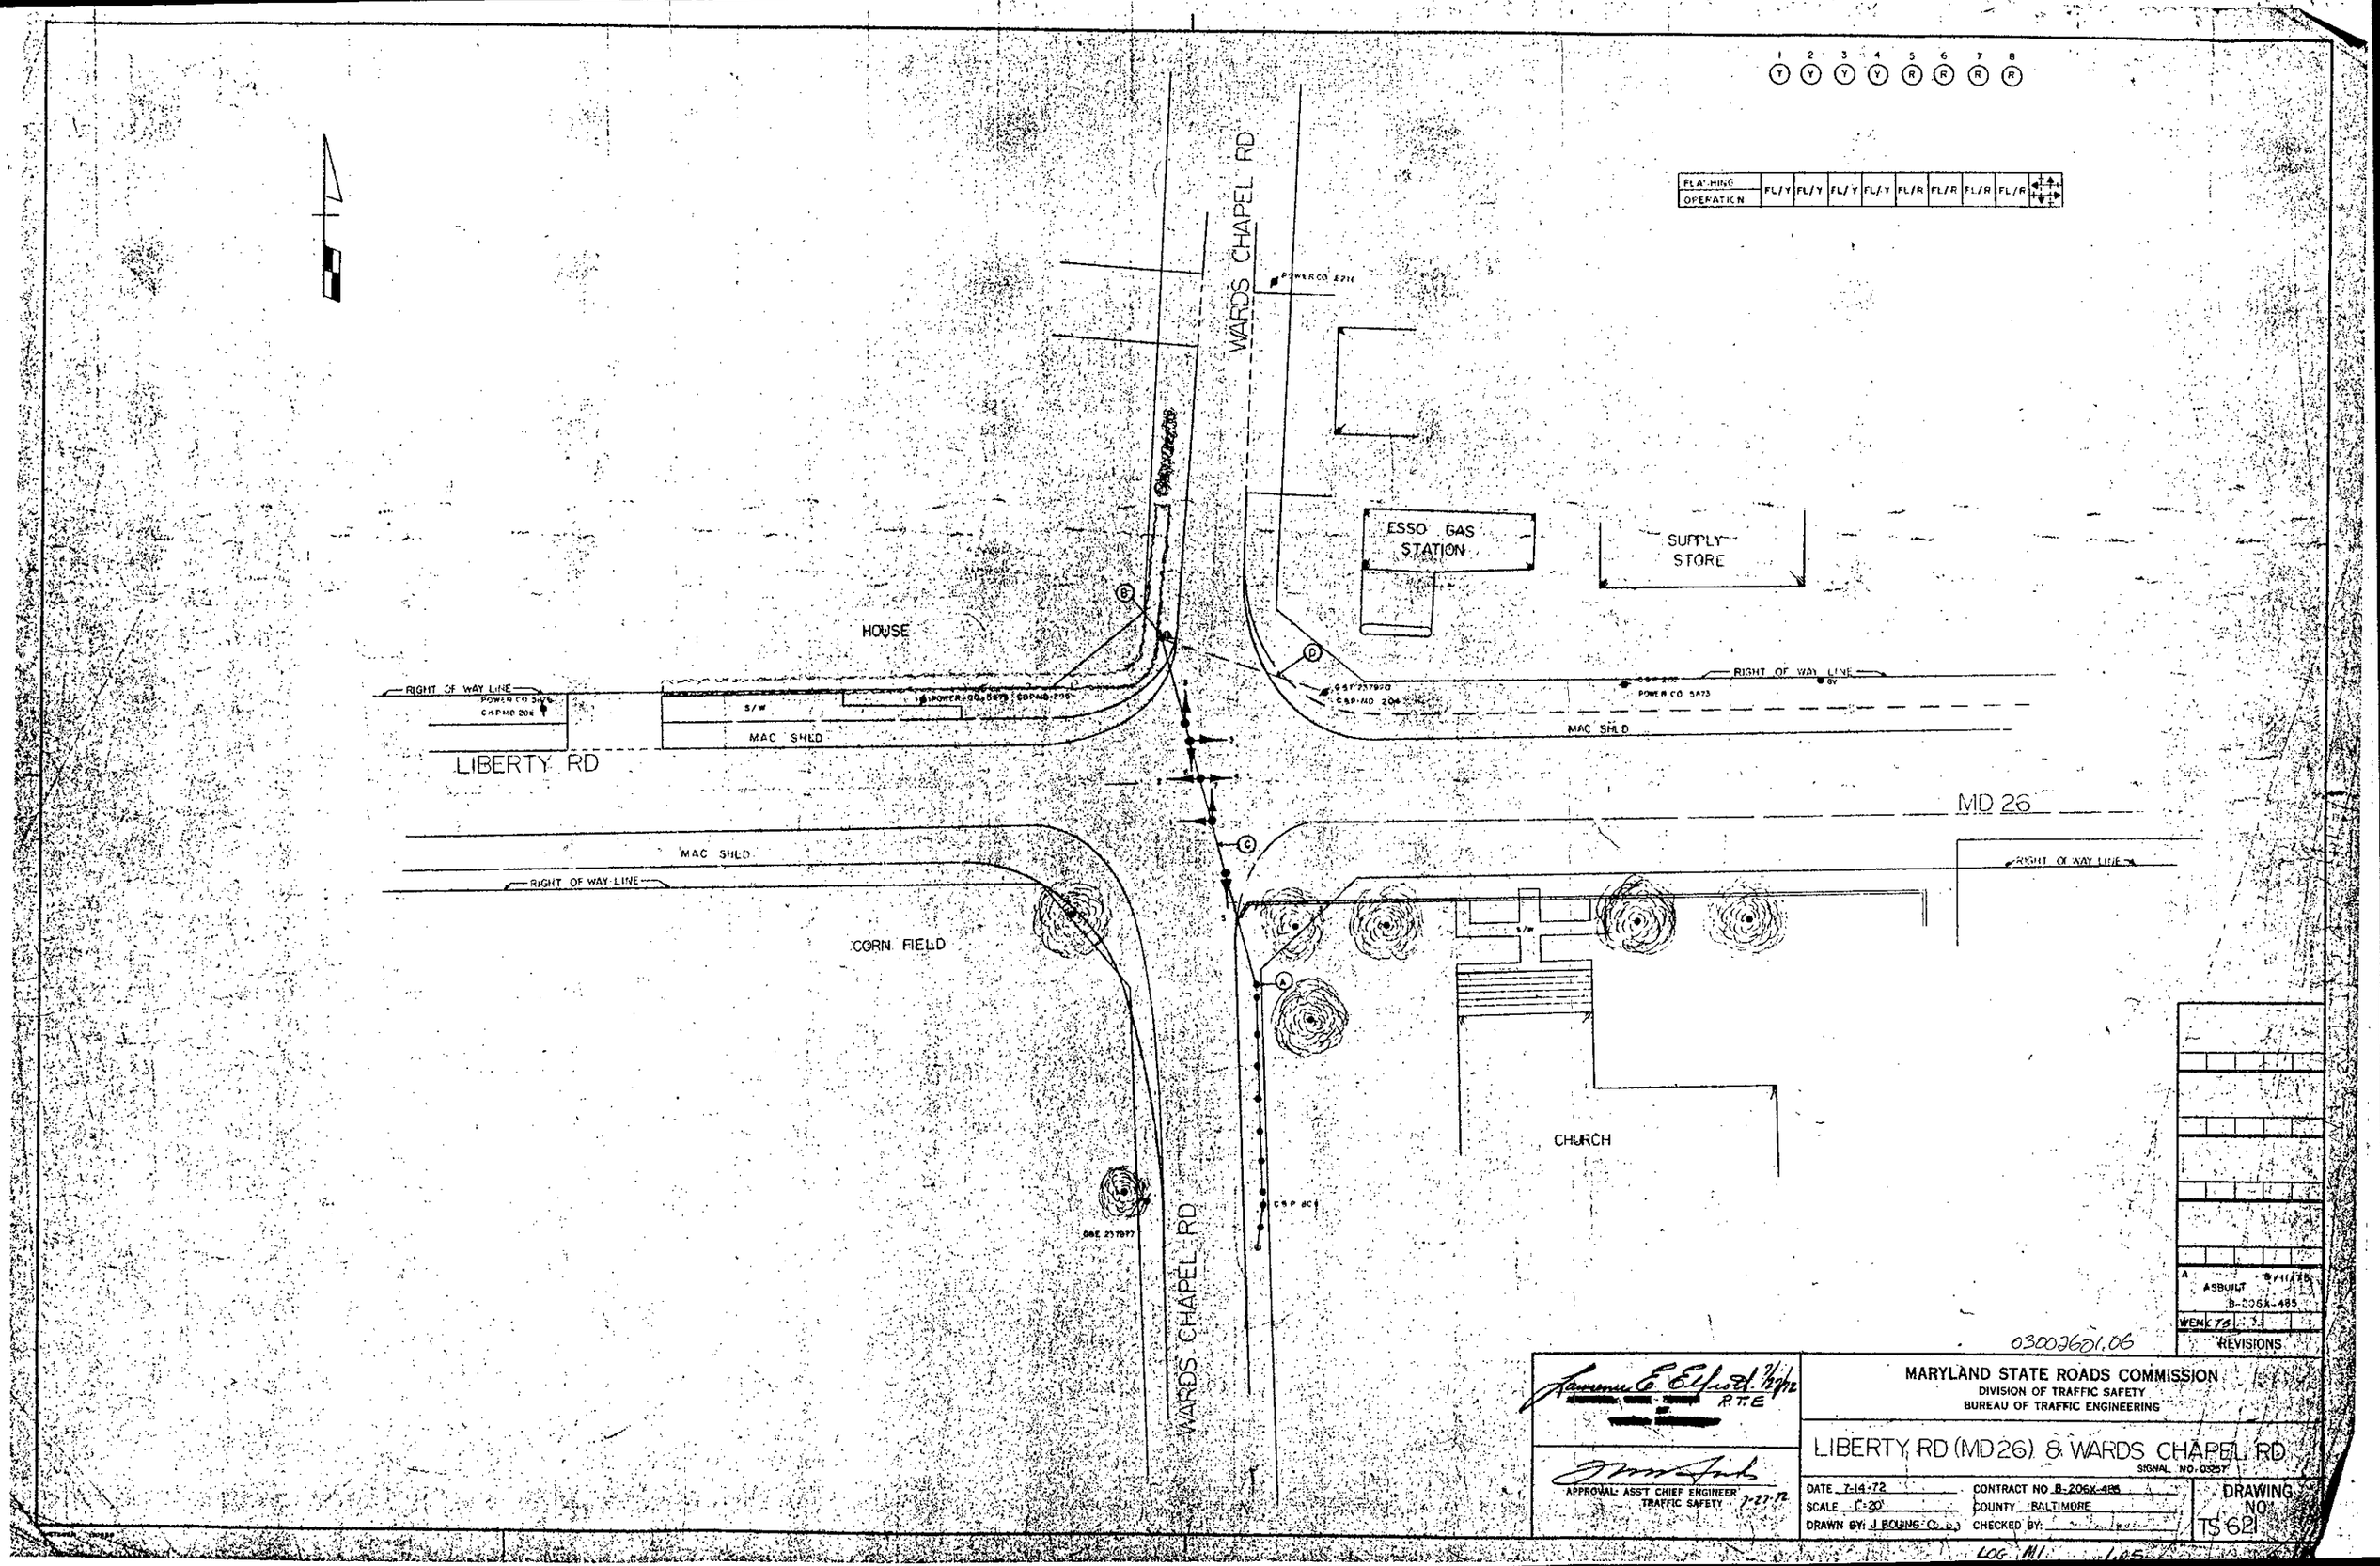

1 2 3 4 5 6 7 8
Y Y Y Y R R R R
FLASHING OPERATION
FL/Y FL/Y FL/Y FL/Y FL/R FL/R FL/R FL/R
WARDS CHAPEL RD
ESSO GAS STATION
SUPPLY STORE
HOUSE
RIGHT OF WAY LINE
S/W
MAC SHED
LIBERTY RD
MD 26
CORN FIELD
CHURCH
WARDS CHAPEL RD
ASBUILT
B-206X-485
REVISIONS
03002601.06
MARYLAND STATE ROADS COMMISSION
DIVISION OF TRAFFIC SAFETY
BUREAU OF TRAFFIC ENGINEERING
LIBERTY RD (MD 26) & WARDS CHAPEL RD
SIGNAL NO. 03257
APPROVAL: ASS'T CHIEF ENGINEER TRAFFIC SAFETY 7-27-72
DATE 7-14-72
SCALE 1"=20'
DRAWN BY: J BOLING
CONTRACT NO B-206X-485
COUNTY BALTIMORE
CHECKED BY:
DRAWING NO TS 621
LOG MI 1.05