F.A.P. NO. T-8007 (8)
SHEET 8 OF 13

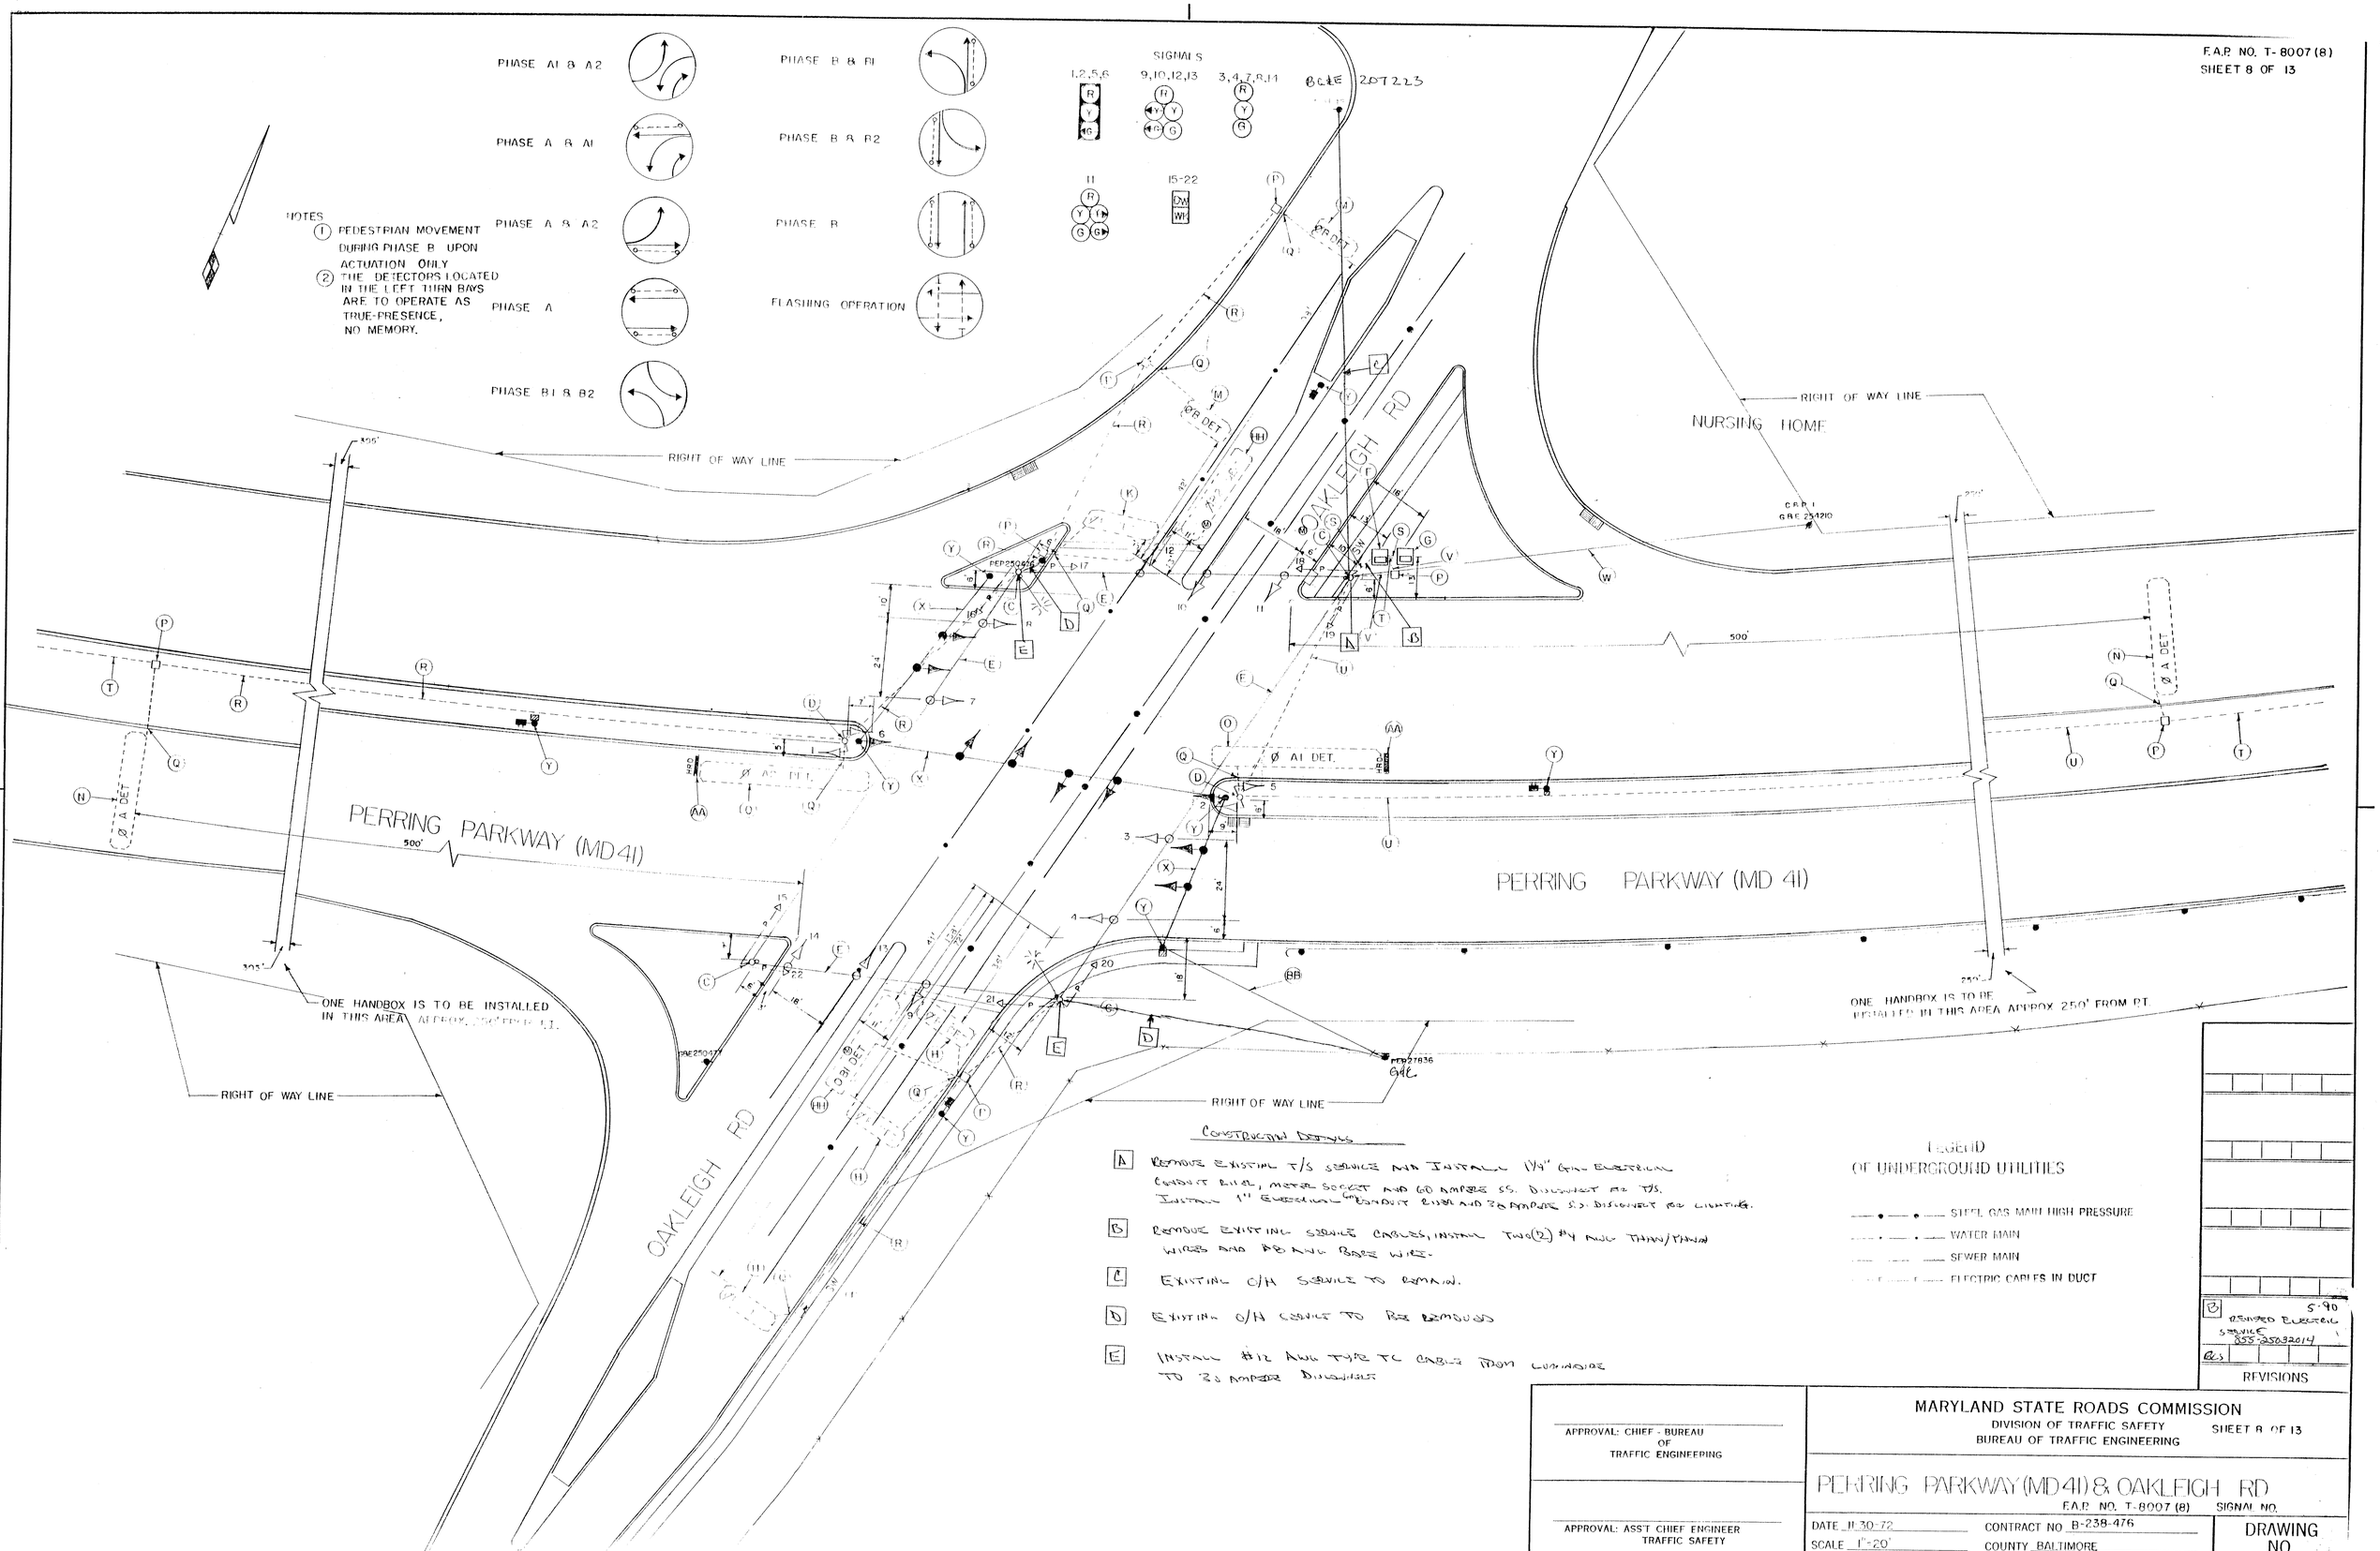

03004100.59