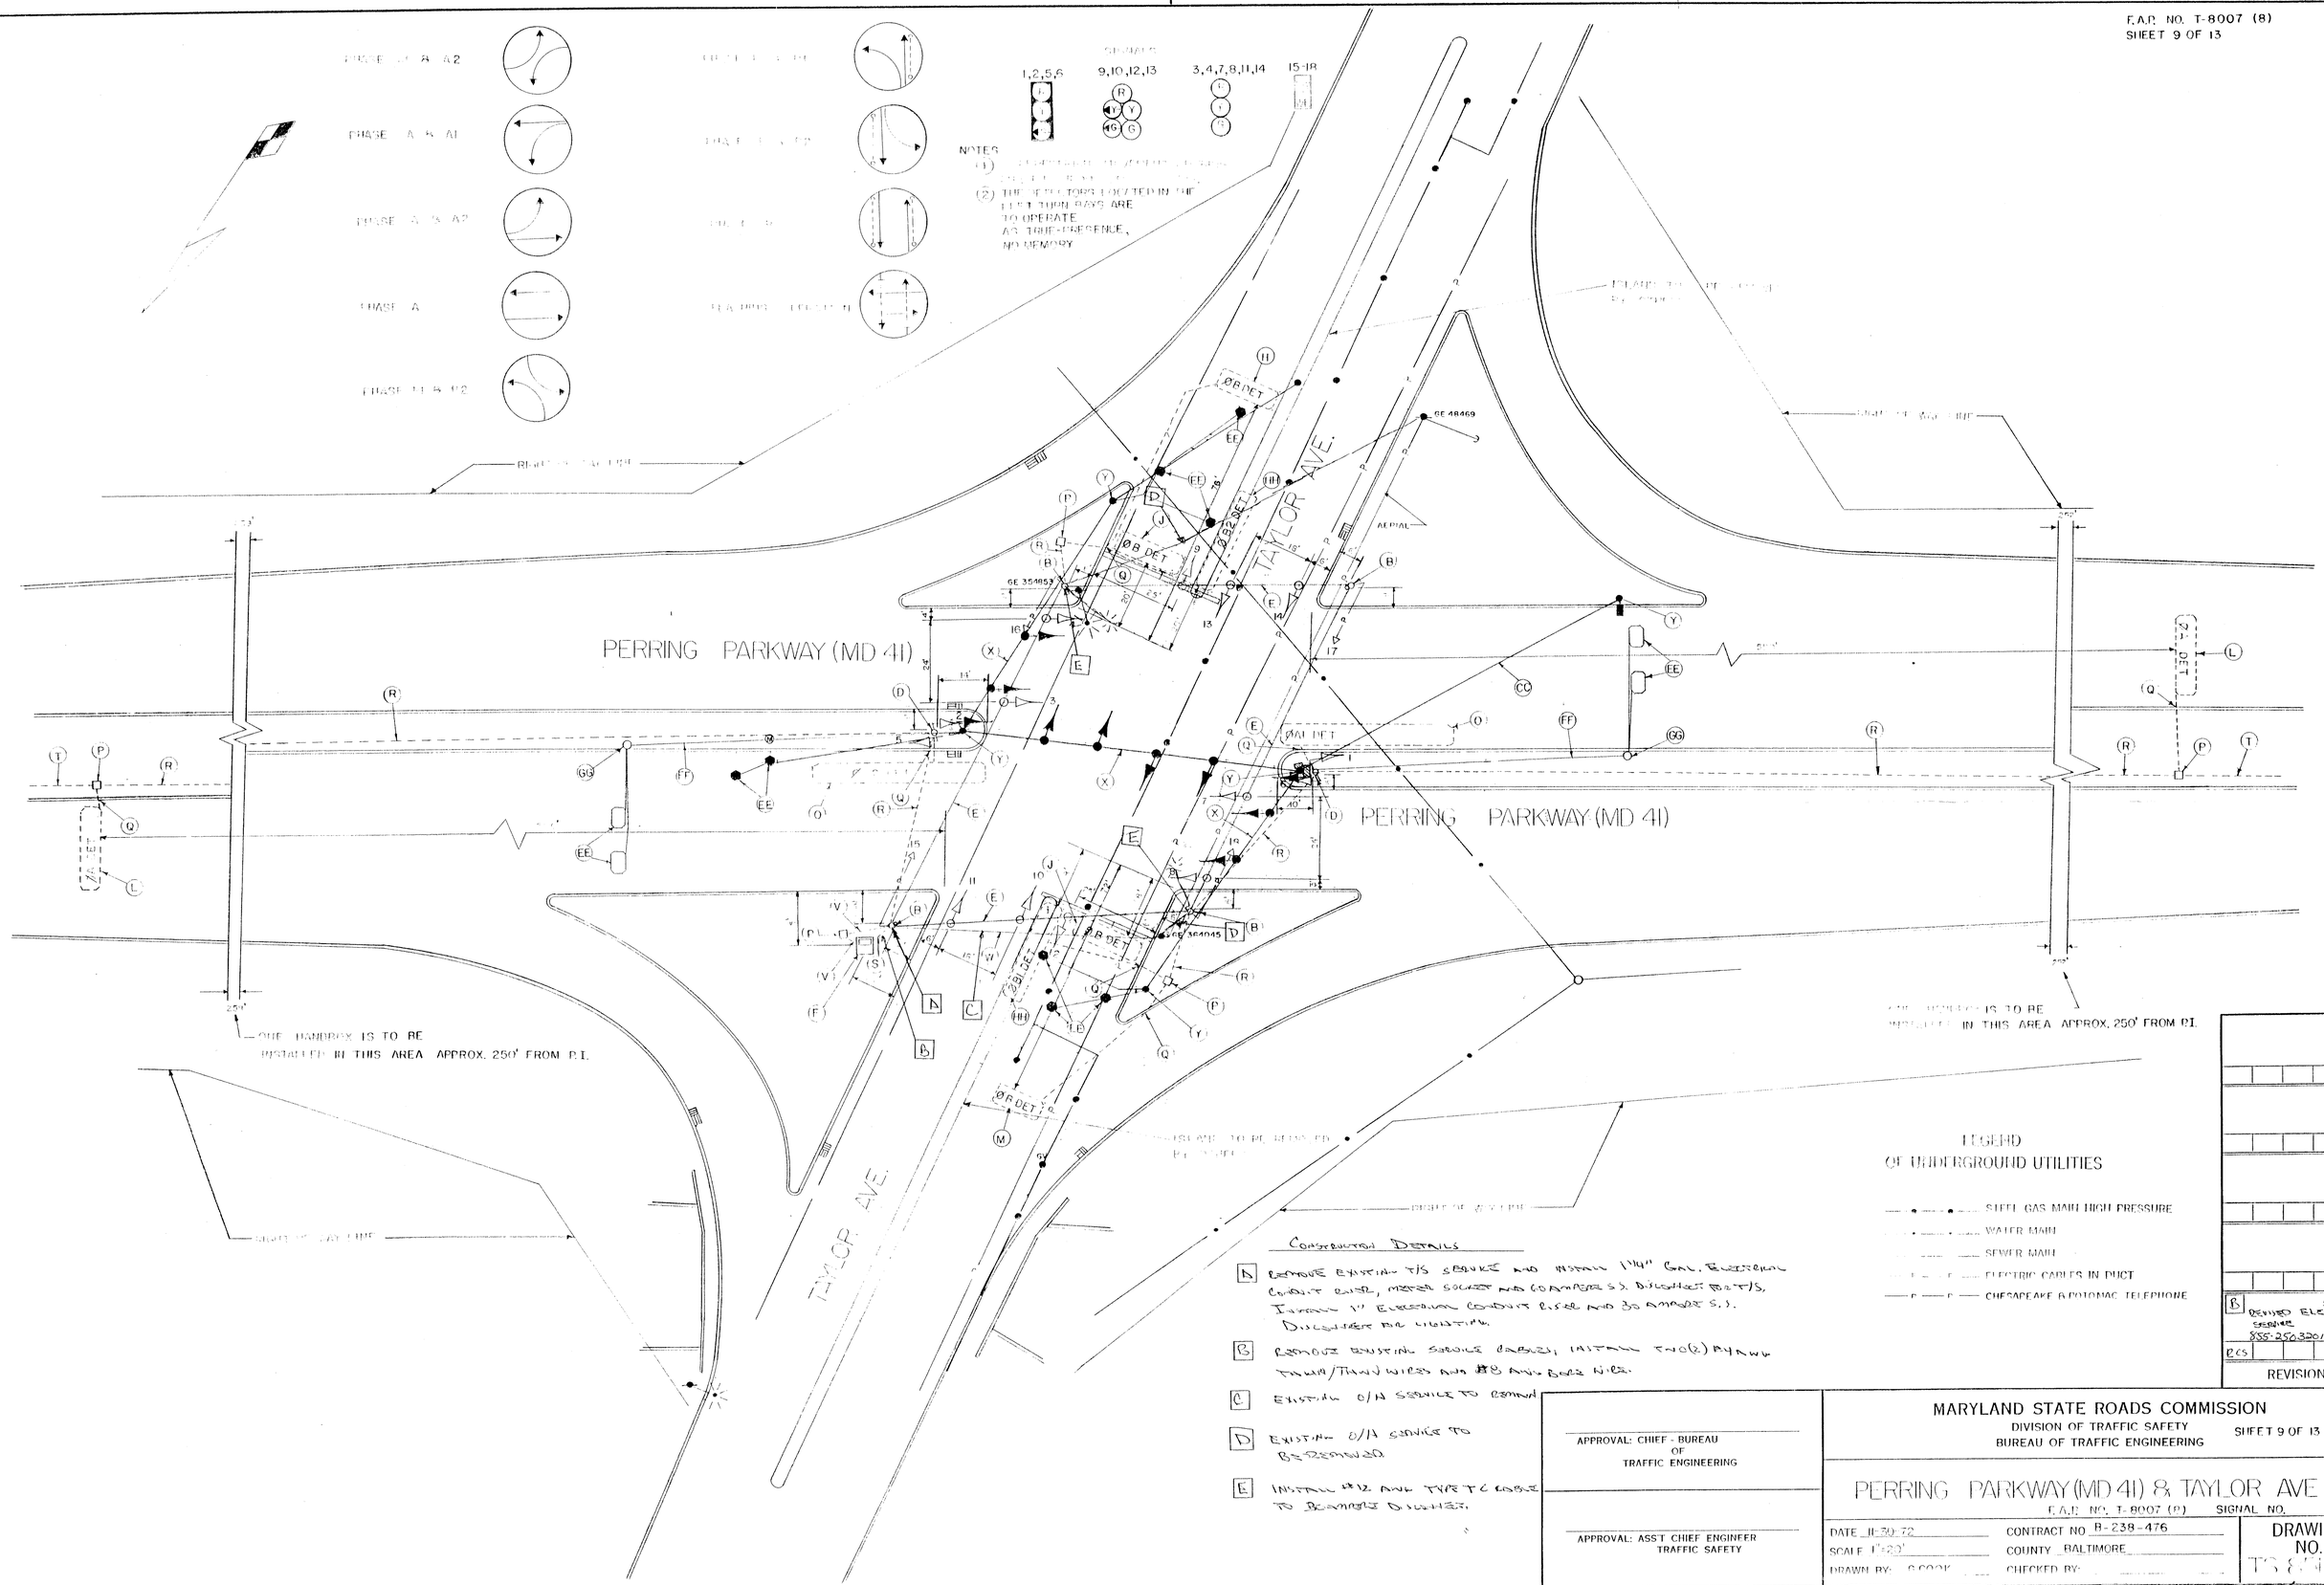

CONSTRUCTION DETAILS

A REMOVE EXISTING T/S SERVICE AND INSTALL 1 1/4" GAL. ELECTRICAL CONDUIT RISER, METER SOCKET AND 60 AMPERE S.S. DISCONNECT FOR T/S. INSTALL 1" ELECTRICAL CONDUIT RISER AND 30 AMPERE S.S. DISCONNECT FOR LIGHTING.

B REMOVE EXISTING SERVICE CABLES, INSTALL TWO (2) #4 AWG THWN/THWN WIRES AND #8 AWG BARE WIRE.

C EXISTING O/H SERVICE TO REMAIN

D EXISTING O/H SERVICE TO BE REMOVED.

E INSTALL #12 AWG TYPE TC CABLE TO 30 AMPERE DISCONNECT.

B REVISED ELECTRIC SERVICE 5-90
855-250-32014
RCS

REVISIONS

APPROVAL: CHIEF - BUREAU OF TRAFFIC ENGINEERING

APPROVAL: ASS'T CHIEF ENGINEER TRAFFIC SAFETY

MARYLAND STATE ROADS COMMISSION
DIVISION OF TRAFFIC SAFETY
BUREAU OF TRAFFIC ENGINEERING

SHEET 9 OF 13

PERRING PARKWAY (MD 41) & TAYLOR AVE
F.A.P. NO. T-8007 (8) SIGNAL NO.

DATE 11-30-72
SCALE 1"=20'
DRAWN BY: G. COOK
CONTRACT NO. B-238-476
COUNTY BALTIMORE
CHECKED BY:

DRAWING NO. TS 8[illegible]